


CONSTRUCTION PLANS FOR

# WINNWOOD ROAD CELESTIAL ROAD IMPROVEMENTS PHASE I & II

WINNWOOD: FROM BELT LINE RD. SOUTH TO CELESTIAL ( PHASE I )  
 CELESTIAL: FROM WINNWOOD RD. WEST TO MONTFORD RD. ( PHASE II )

(WINNWOOD) CELESTIAL ROAD Imp. PHASE II 1/89

Pages Here PHASE II  
 25, 12, 13, 14, 15, 24,  
 25, 26, 27, 28, 28a, 29,  
 29a

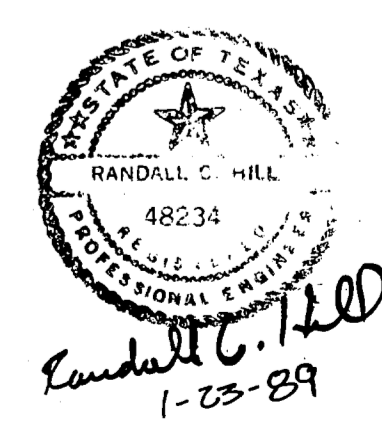

GINN, INC.  
 Consulting Engineers Dallas, Texas

RECORD DRAWING  
 S2-1