



NOTE:
MODIFY RAMP TO
FIT DIFFERENT RADIUS

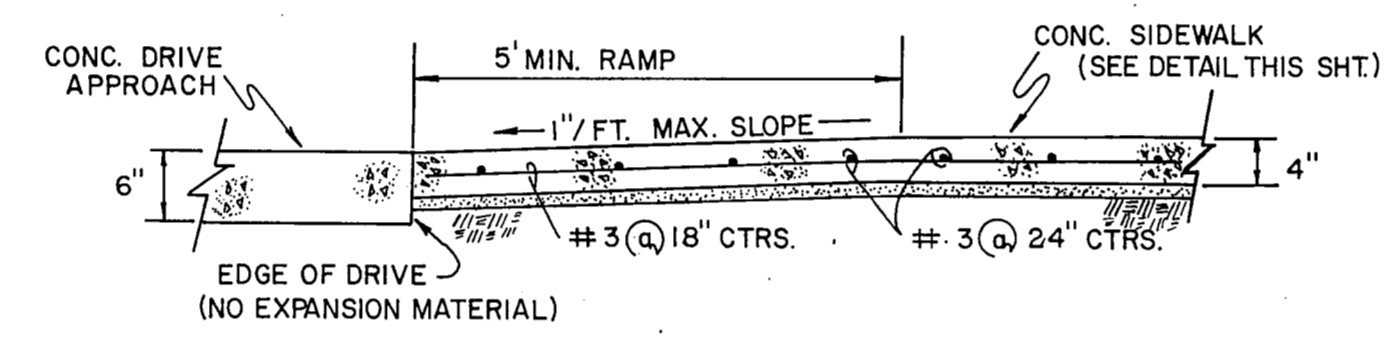


SECTION

**BARRIER FREE RAMP AT DRIVEWAY
DETAIL**

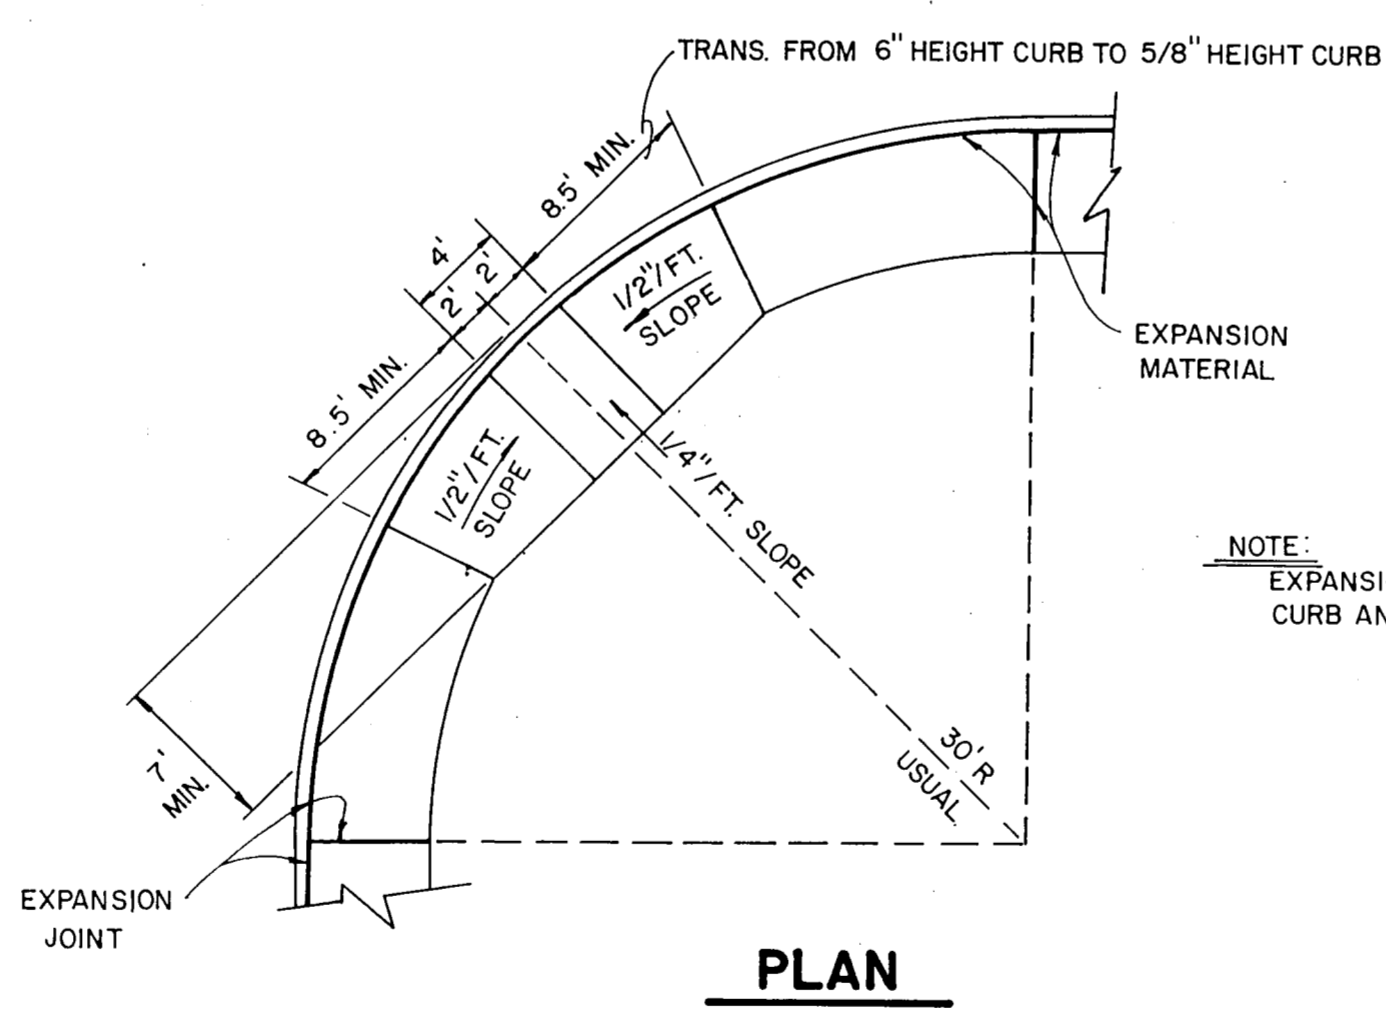


NOTE:
EXPANSION MATERIAL ALONG
CURB AND AT CURB RETURNS

PLAN

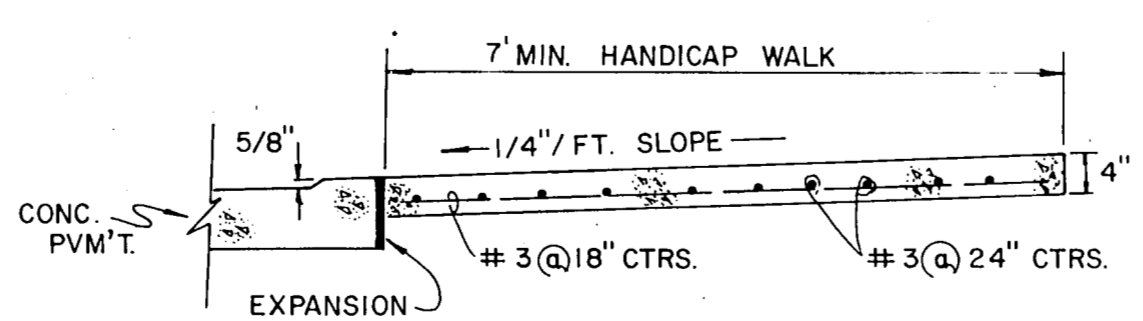


SECTION


HANDICAP ROLL-DOWN CURB DETAIL

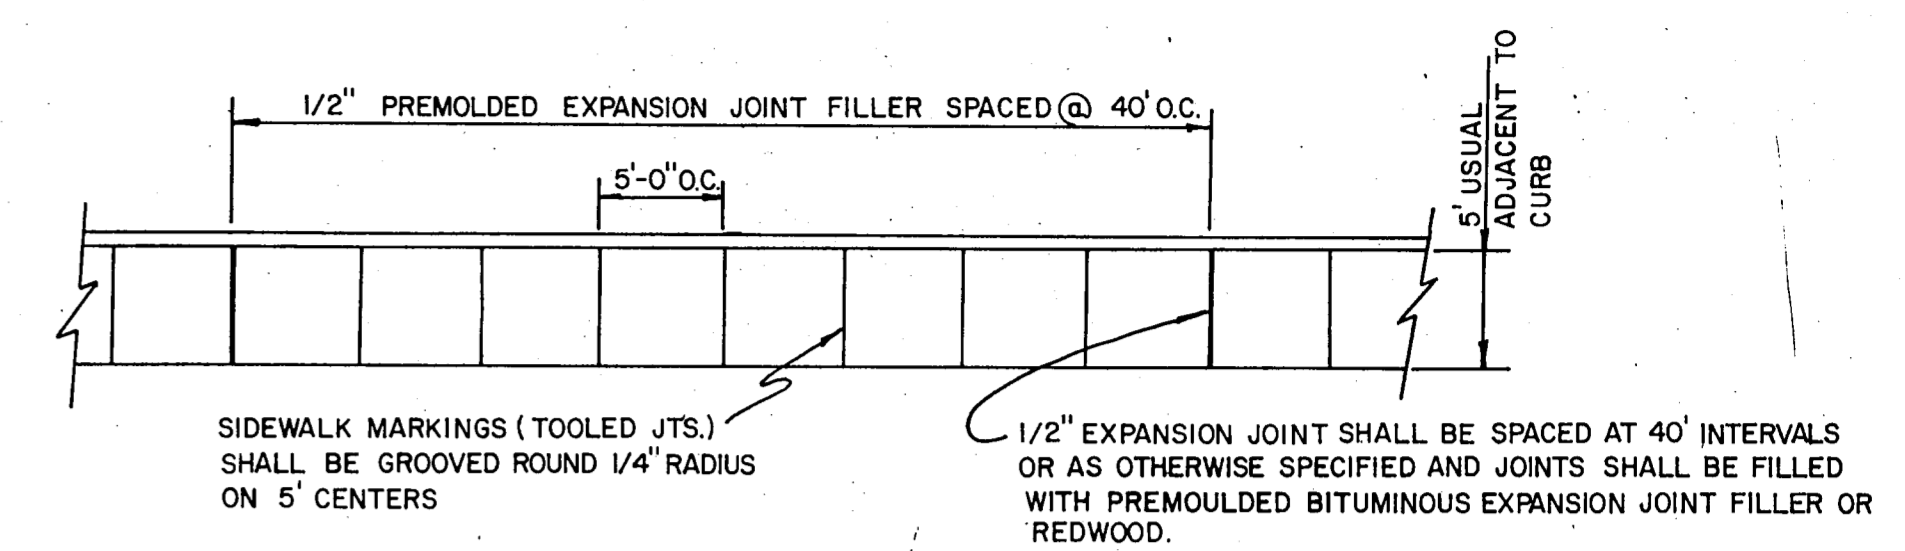

PLAN

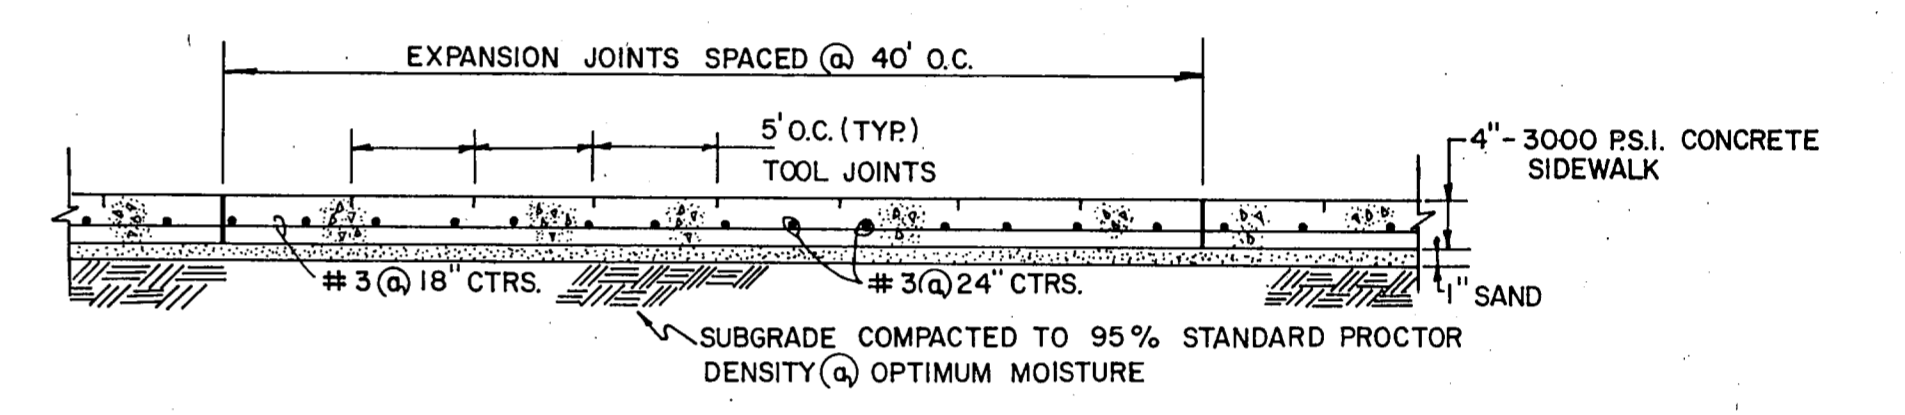

SIDE ELEVATION

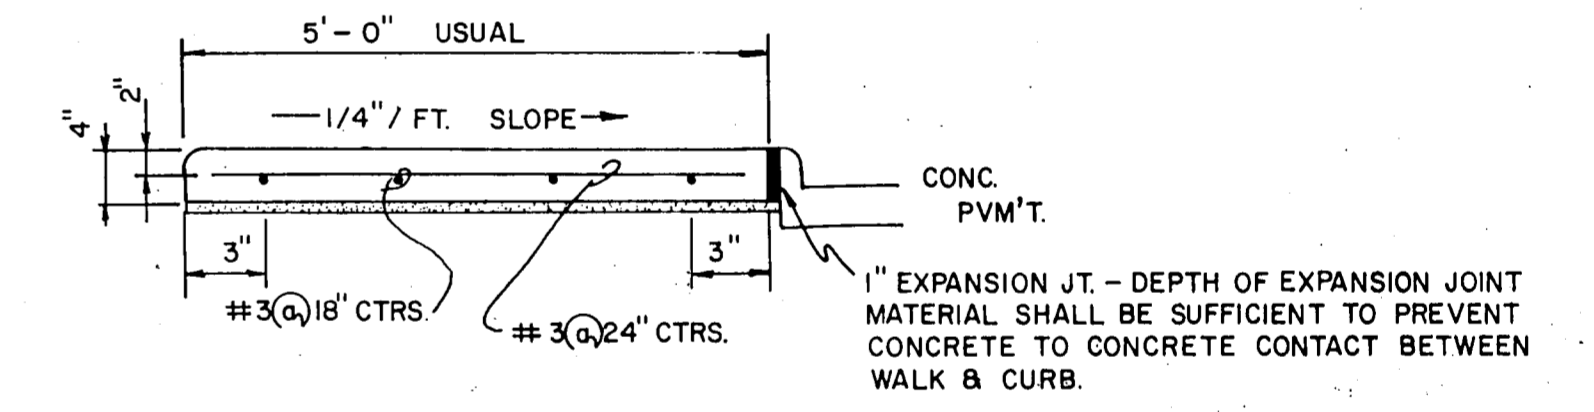

SECTION

CONCRETE SIDEWALK DETAIL

GENERAL NOTES

1. Reinforced concrete sidewalk shall be five (5) feet wide, a minimum of four (4) inches thick and shall be 3000 psi at 28 days (5 sack mix).
2. Chamfer all exposed edges of concrete (1/4) inch.
3. All bar dimensions are given as center to center of bars and are located as shown.
4. All reinforcing steel shall be No. 3 on 18 inch centers longitudinally, 24 inch centers transversely and shall conform to the requirements of ASTM A-615, Grade 60.
5. 1" thick min. fine, washed sand cushion shall be free from organic materials or clays and shall be used for grade adjustment.
6. Subgrade shall be compacted to a density not less than 95% at optimum moisture.
7. Tooled joints (contraction joints) shall be on five (5) foot centers and shall be round one-fourth (1/4) inch radius.
8. A one-half (1/2) inch expansion joint shall be placed every eight (8) tooled joints, and where works abut old work, or where new work is constructed adjacent to other concrete, a one (1) inch expansion joint shall be used where sidewalk is adjacent to curb, the expansion joint shall be made of pre-molded bituminous expansion joint filler or redwood.
9. Sidewalks shall be finished by lightly brooming surface transversely to direction of main traffic or where adjacent sidewalks differ from this standard, new sidewalks shall conform to adjacent sidewalk (e.g. exposed aggregate).
10. Cross slope walk one-fourth (1/4) inch per foot towards curb or as shown on the drawings to provide drainage.
11. All trees, bushes, and shrubs in the path of construction will be replaced or relocated by owner.

STATE OF TEXAS
RANDALL G. HILL
48234
PROFESSIONAL ENGINEER
Randall G. Hill
1-23-89

RECORD DRAWING

NO.	REVISION	BY	DATE
TOWN OF ADDISON, TEXAS DEPARTMENT OF ENGINEERING			
STANDARD CONSTRUCTION DETAILS PAVING			
SIDEWALKS & RAMPS			
APPROVED _____ H. WAYNE GINN, P.E.			
DATE	AUGUST, 1988	SHEET	SD-7A