

GRADE TO DRAIN ON PUMP STATION SITE, INSTALL TEMP HEADWALL AS PER DETAIL THIS SHEET PAY ITEM 475.3



STA. 10+86.63
1'-10" MDD. REC. INLET
T.C. = 606.80
P.I. = 602.80
PAY ITEM 470.6
SEE DETAIL SHT. 28

STA. 10+86.63
1'-10" REC. INLET
T.C. = 606.30
P.I. = 602.30
PAY ITEM 470.1


CAUTION!
Underground Gas Main in This Area.
Contact Lone Star Gas Company 2
Working Days Prior To Construction.
Call MR. Leon Weatherford At
276-1171

DERYL COMER

TEMP HEADWALL DETAIL
NOT TO SCALE

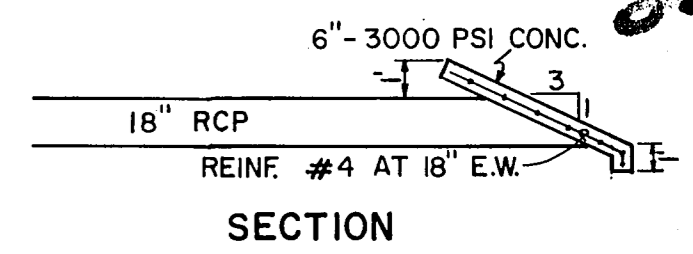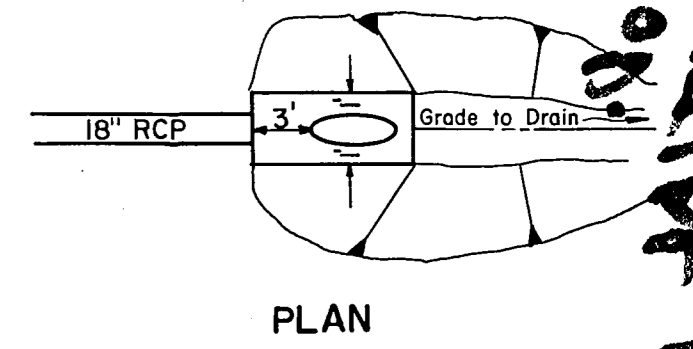

B.M. "D" CUT CENTER FRONT PORCH 5555 CELESTIAL ROAD, ELEV. 577.95 (M.S.L.)

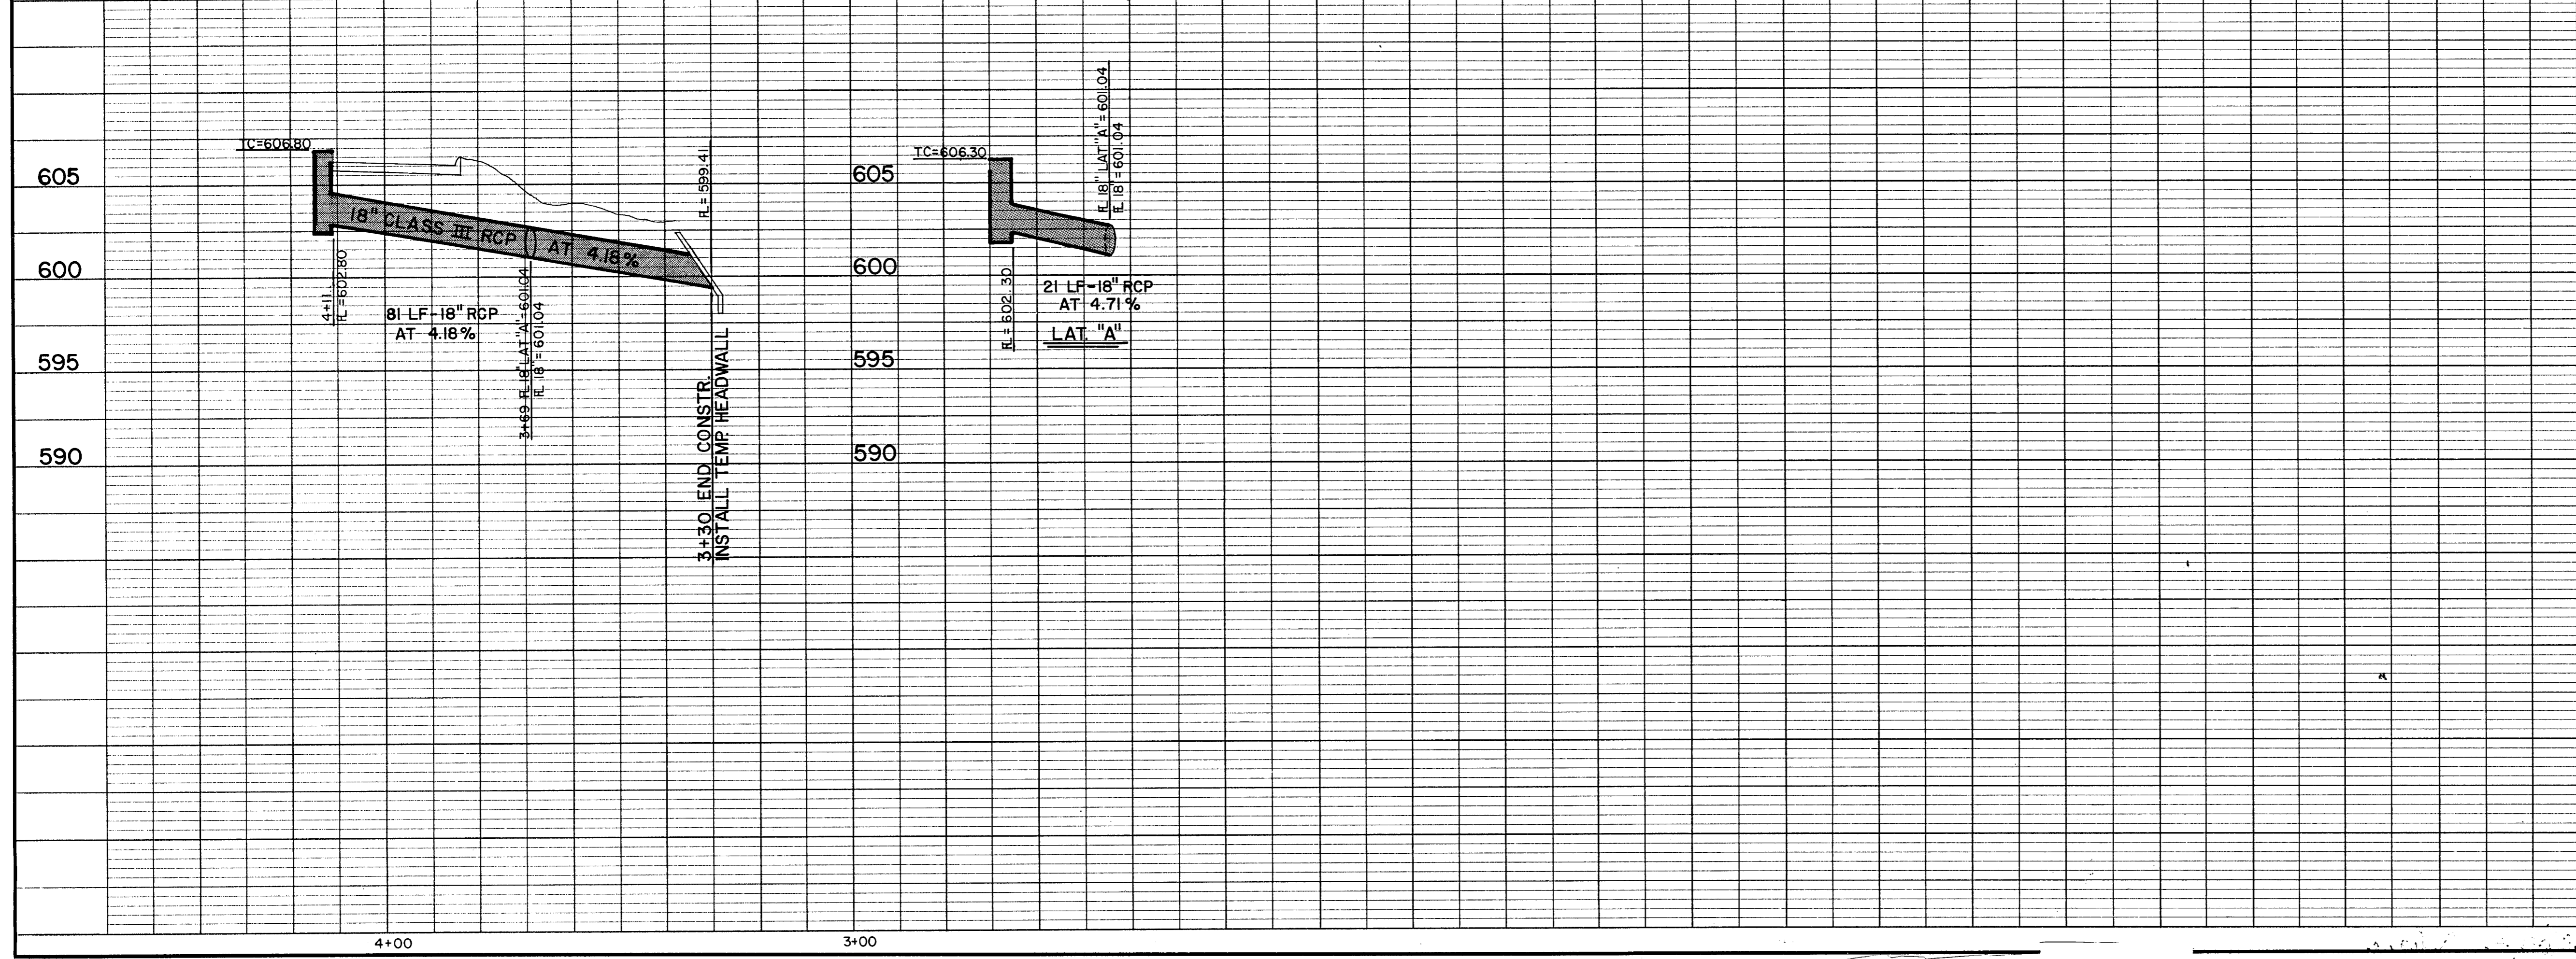

PHASE II

Changed Pay Item 470.3 to 470.6. Add Note - Pay Item 475.3 No. Revision By Date		JCK 6-13-86	
TOWN OF ADDISON DALLAS COUNTY, TEXAS WINNWOOD/CELESTIAL RD. IMPROVEMENTS CELESTIAL RD. OFFSITE STORM SEWER			
GINN, INC. Consulting Engineers Dallas, Texas			
Designed - JCK	Drawn - DEM	Date - 5 23 86	Job No. - 265
Approved - HWG	Checked - JCK	Scale - 1" = 20' H / 1" = 5' V	Sheet 29a of 29

25-1
 1500004914
 CIVIL ENGINEER
 10/1/86