

PAY ITEM	DESCRIPTION	UNIT	QTY
465.5	8" PVC SEWER PIPE SDR-35	LF	240
465.8	4' DIAMETER M.H.	EA	3


NOTE: Contractor to Verify Location & Elevation of Existing 6" PVC Sanitary Sewer Prior to Construction.

CAUTION!  
Underground Gas Main In This Area.  
Contact Lone Star Gas Company 2  
Working Days Prior To Construction.  
Call MR. Leon Weatherford At  
276-1171

Note: Contractor to contact M. Parsley, Manager of DWU City Forces, at 670-8692, at least two weeks prior to commencement of work on this project.


B.M. "□" CUT ON HEADWALL, EAST SIDE OF WINNWOOD, 180' SOUTH OF BELT LINE ROAD. ELEV. 555.79 (M.S.L.)  
B.M. "□" CUT CENTER FRONT PORCH 5555 CELESTIAL ROAD. ELEV. 577.95 (M.S.L.)

BLK. 8171

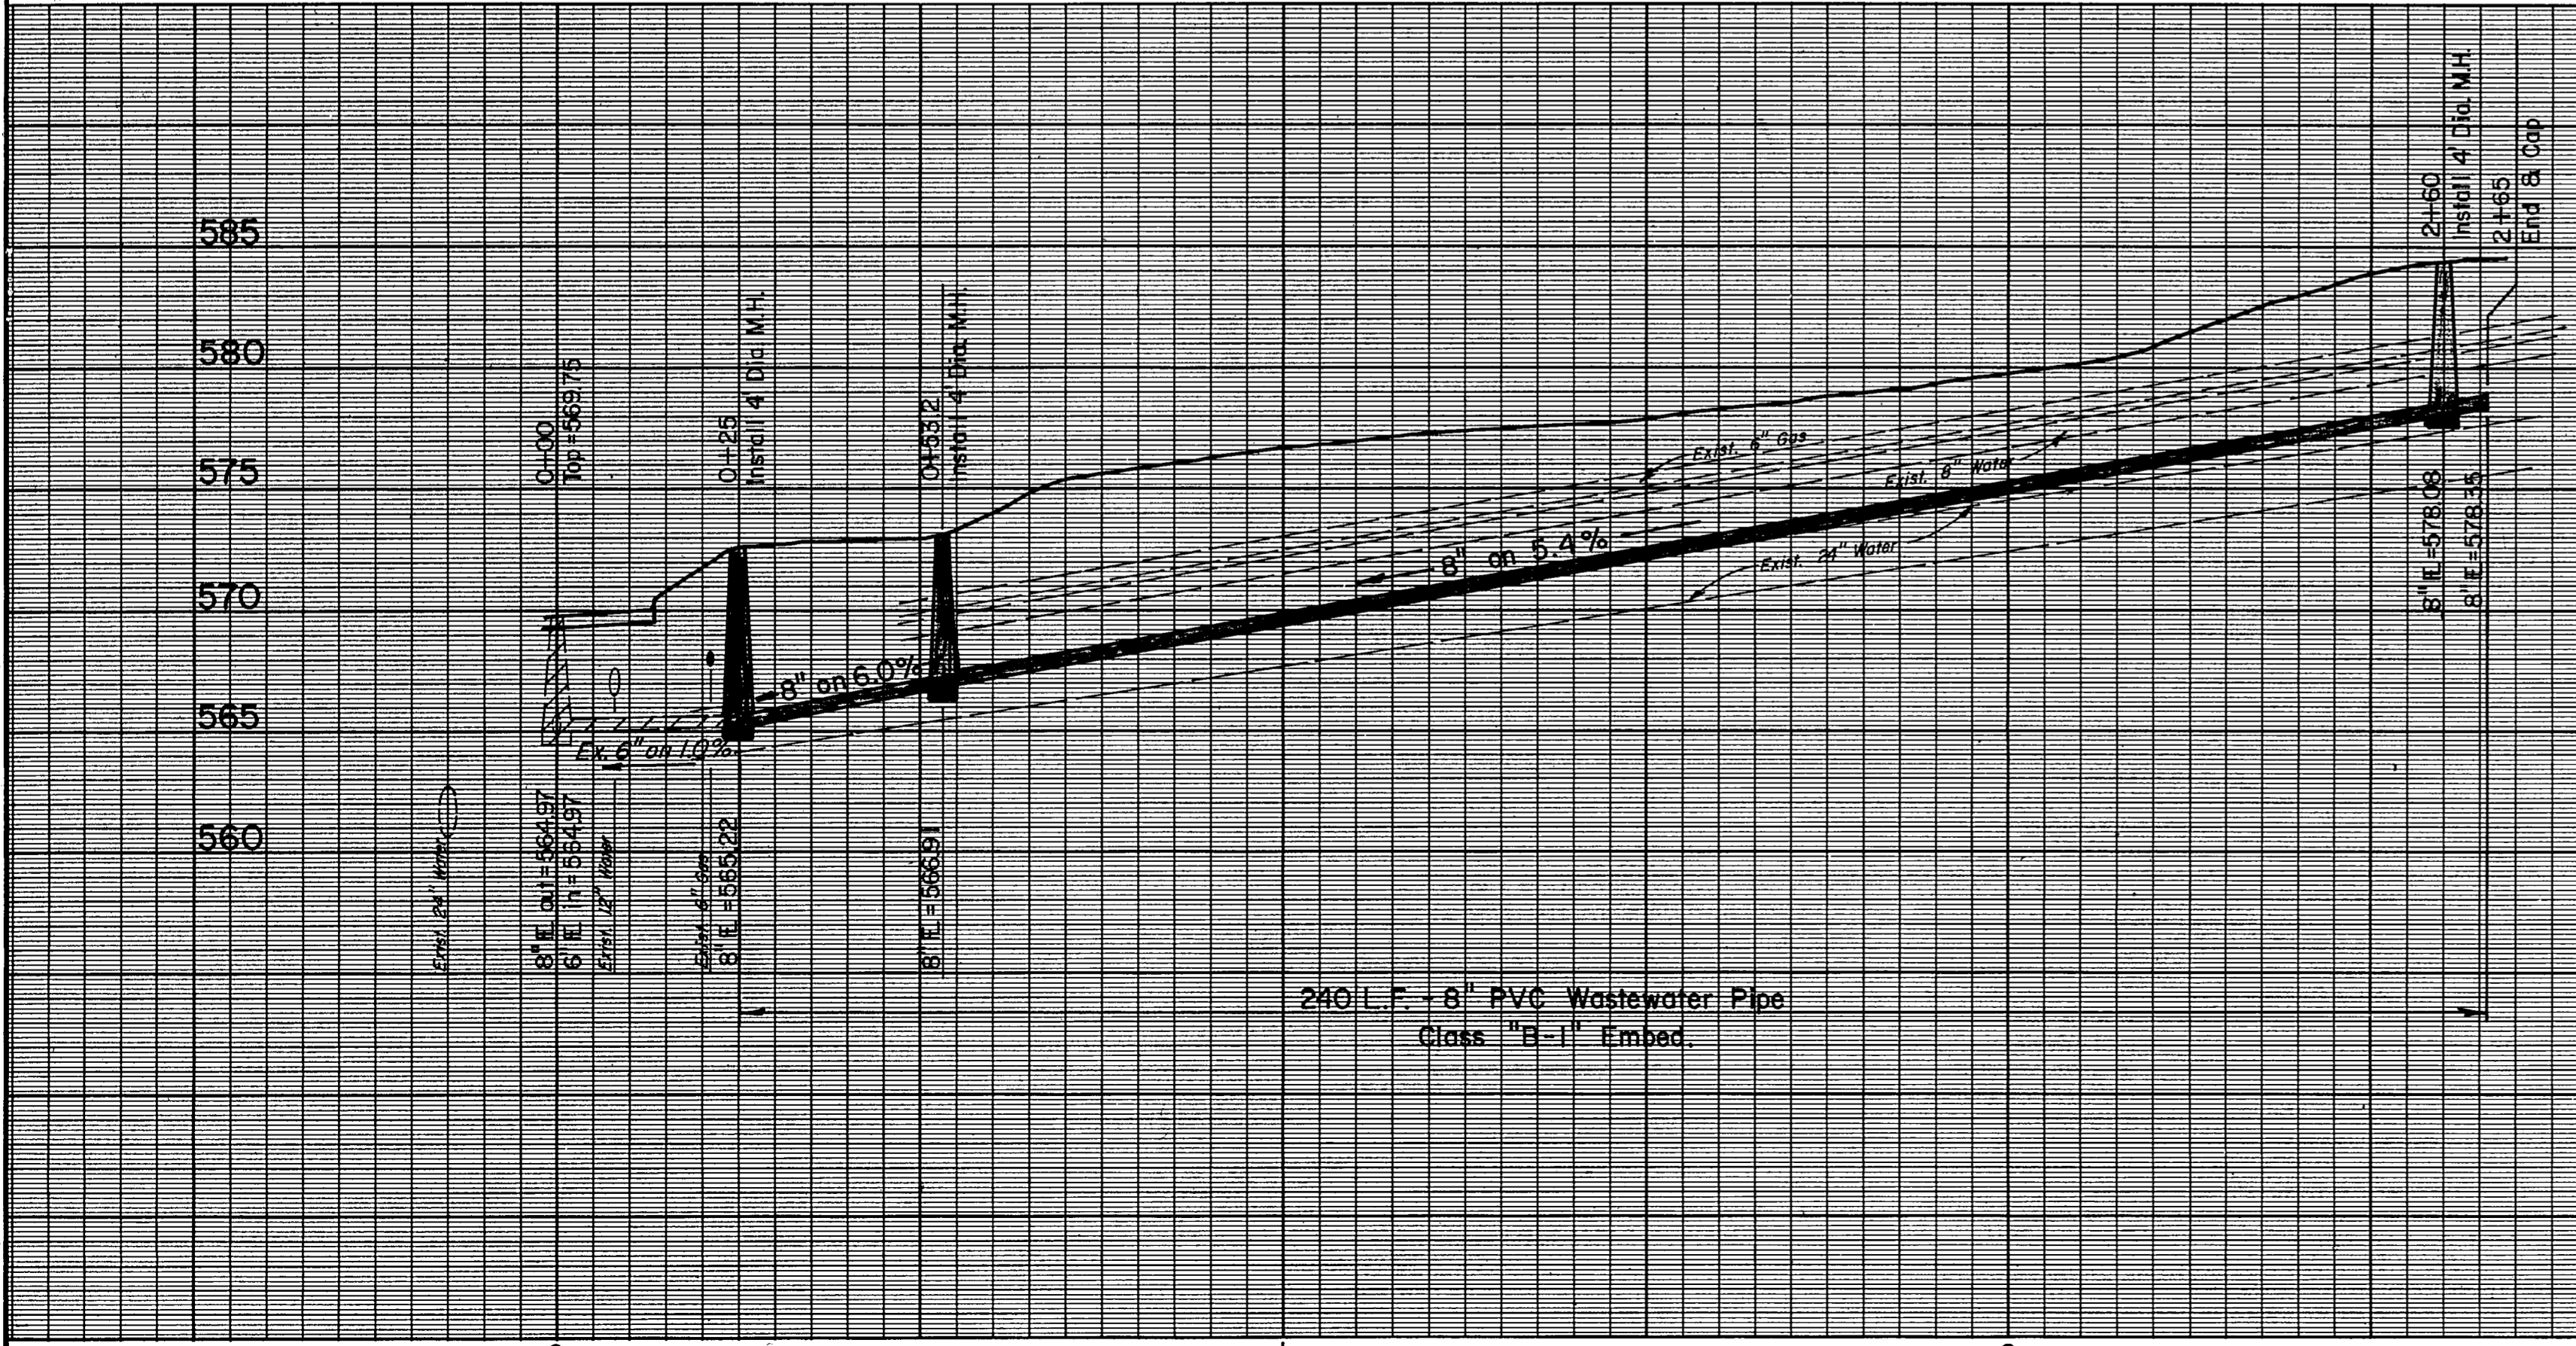

240 LF - 8" PVC Wastewater Pipe  
Class "B-1" Embed.

RECORD DRAWING 110

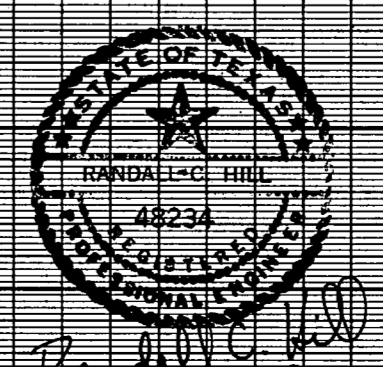

WATER & SANITARY SEWER						
WINNWOOD RD. SAN. SWR. IMPROVEMENTS						
PLAN & PROFILE						
WATER UTILITIES DEPARTMENT						
CITY OF DALLAS, TEXAS						
DESIGN	DRAWN	DATE	SCALE	NOTES	FILE	NO.
TEC	TEC	DEC. 1988	1" = 20' H 1" = 6' V		411Q	1960