


CAUTION!
UNDERGROUND S.W. BELL TELE. CONDUIT. CONTACT S.W. BELL PRIOR TO CONST. IN THIS AREA. CALL OPERATOR 800 FOR ENTERPRISE 2800

CAUTION!
CONTACT LESLIE BARBER TWO WORKING DAYS PRIOR TO EXCAVATING IN VICINITY OF DALLAS POWER & LIGHT CO. FACILITIES. TELE. 648-7237 OR 628-7208

CAUTION!
6" + 4" GAS MAIN IN AREA. CONTRACTOR SHALL NOTIFY LONG STAR GAS CO. 48 HOURS PRIOR TO CONSTRUCTION. TELEPHONE ENTERPRISE 2800

DALLAS
BLK/8222

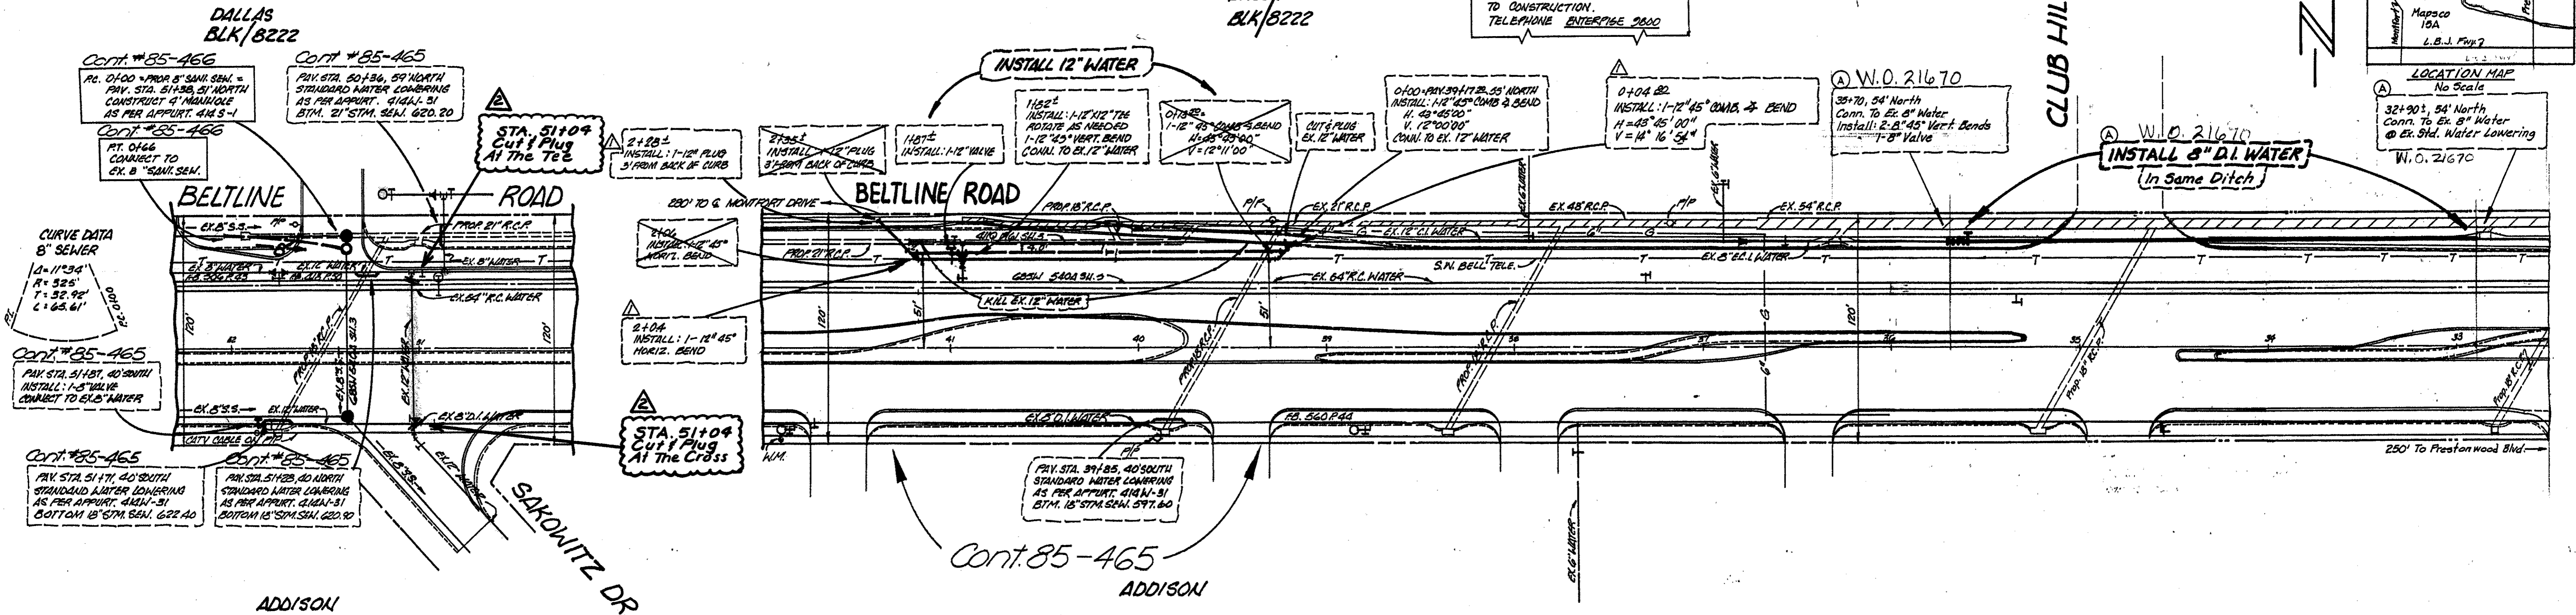

CURVE DATA
8" SEWER
A=11°34'
R=325'
T=52.92'
L=63.61'

Cont. #85-466
PC. 0+00 + 8" SANI. SEN. =
P.V. STA. 51+38.51 NORTH
CONSTRUCT 4" MANHOLE
AS PER APPURT. 414-3-1

Cont. #85-465
P.V. STA. 51+38.51 NORTH
STANDARD WATER LOWERING
AS PER APPURT. 414-3-1
BTM. 21" STM. SEN. 622.20

Cont. #85-465
P.V. STA. 51+37.40 SOUTH
STANDARD WATER LOWERING
AS PER APPURT. 414-3-1
BTM. 18" STM. SEN. 622.40

Cont. #85-465
P.V. STA. 51+28.40 NORTH
STANDARD WATER LOWERING
AS PER APPURT. 414-3-1
BTM. 18" STM. SEN. 622.20

FOR PROP. PAVING AND DRAINAGE
SEE STATE HIGHWAY PLANS
PROJECT #3050 () SH. 1-5

FOR PROP. PAVING AND DRAINAGE
SEE STATE HIGHWAY PLANS
PROJECT #3050 () SH. 1-5


FOR GENERAL NOTES
SEE 685A1-750 SH. 175

Design By: Donna Long
Drawn By: J. Broadnax
Date: June 10, 1986
W.O. # 21670

INDICATES REVISED DESIGN
5-26-86
BY: DONNA LONG
DRAWN: EARNEST LONE

WATER MAP: 7-22, 23, 24 W
SEWER MAP: B.4. MAP F-3, G-3

OHMS RANGE FROM 1100 TO 1900

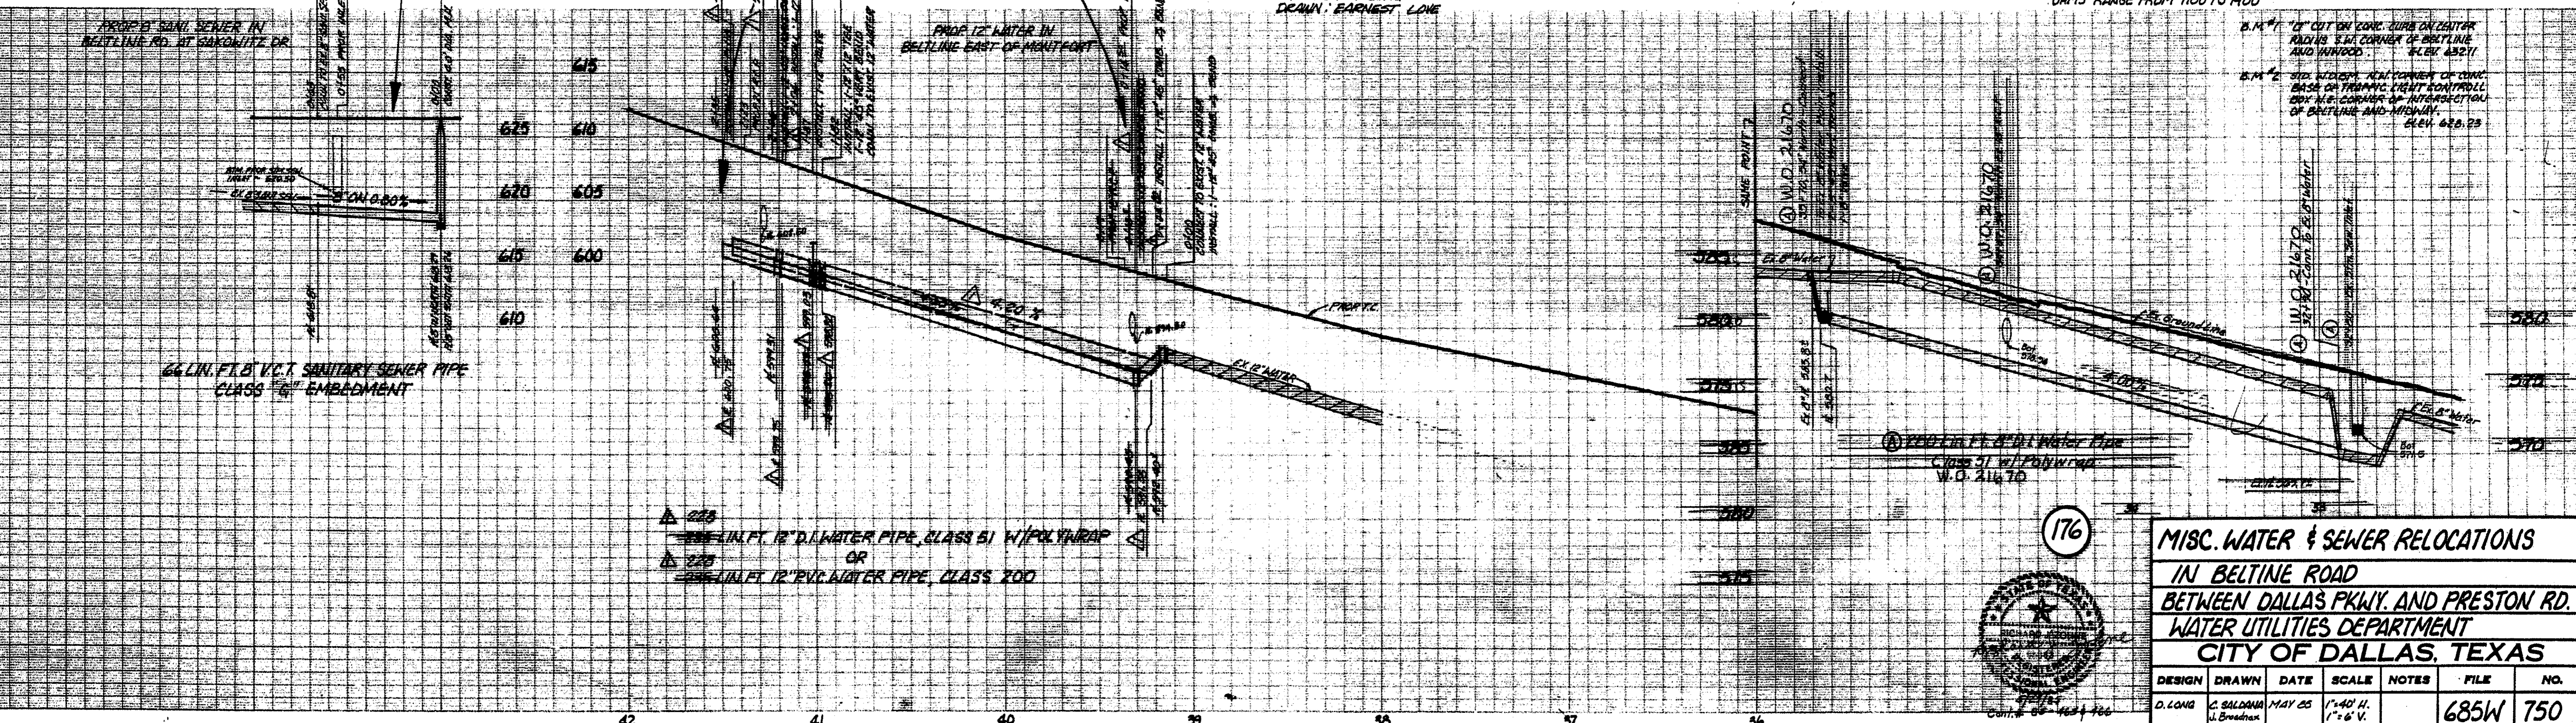

MISC. WATER & SEWER RELOCATIONS
IN BELTLINE ROAD
BETWEEN DALLAS PKWY. AND PRESTON RD.
WATER UTILITIES DEPARTMENT
CITY OF DALLAS, TEXAS

DESIGN	DRAWN	DATE	SCALE	NOTES	FILE	NO.
D. LONG	J. Broadnax	MAY 85	1"=40' H. 1"=6' V.		685W	750



176