

BLK. 8222
PRESTON WOOD MALL
411Q 1961 SH. 3-15

BLK. 8222


CITY OF DALLAS
HOCKADAY SCHOOL, INC. PROPERTY

ABSTRACT 1580

ABSTRACT 1580

411Q-1961 Sh. 3


411Q 1961
45-46

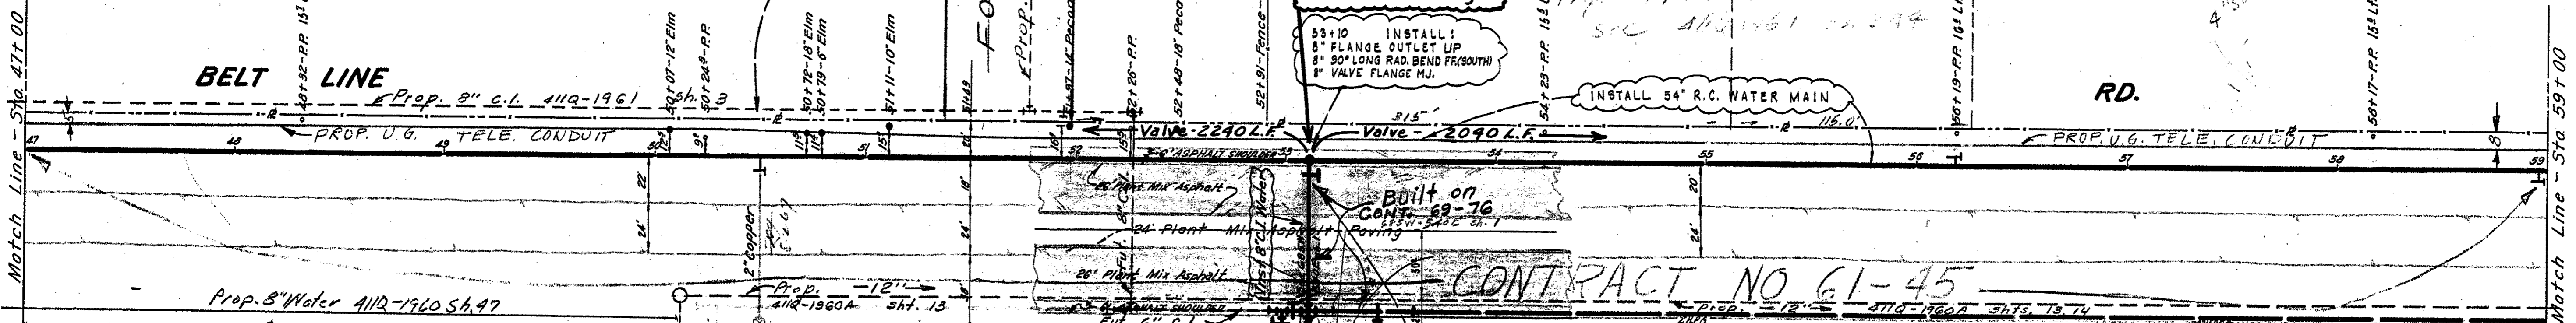

Oaks North Add.
411Q-1960 Sh 47, 48

BENCH MARK:
R.R. spike in 18' Pecan N. side of
BELT LINE RD. 5248' E. of INWOOD
RD. & near LAKE FOREST RD.
ELEV. 568.34

NOTE! BORINGS BY:
MASON-JOHNSTON & ASSOCIATES.
BORING B-7 DRY AT 24-HR.
WATER CHECK. 30 NOV, 1960.

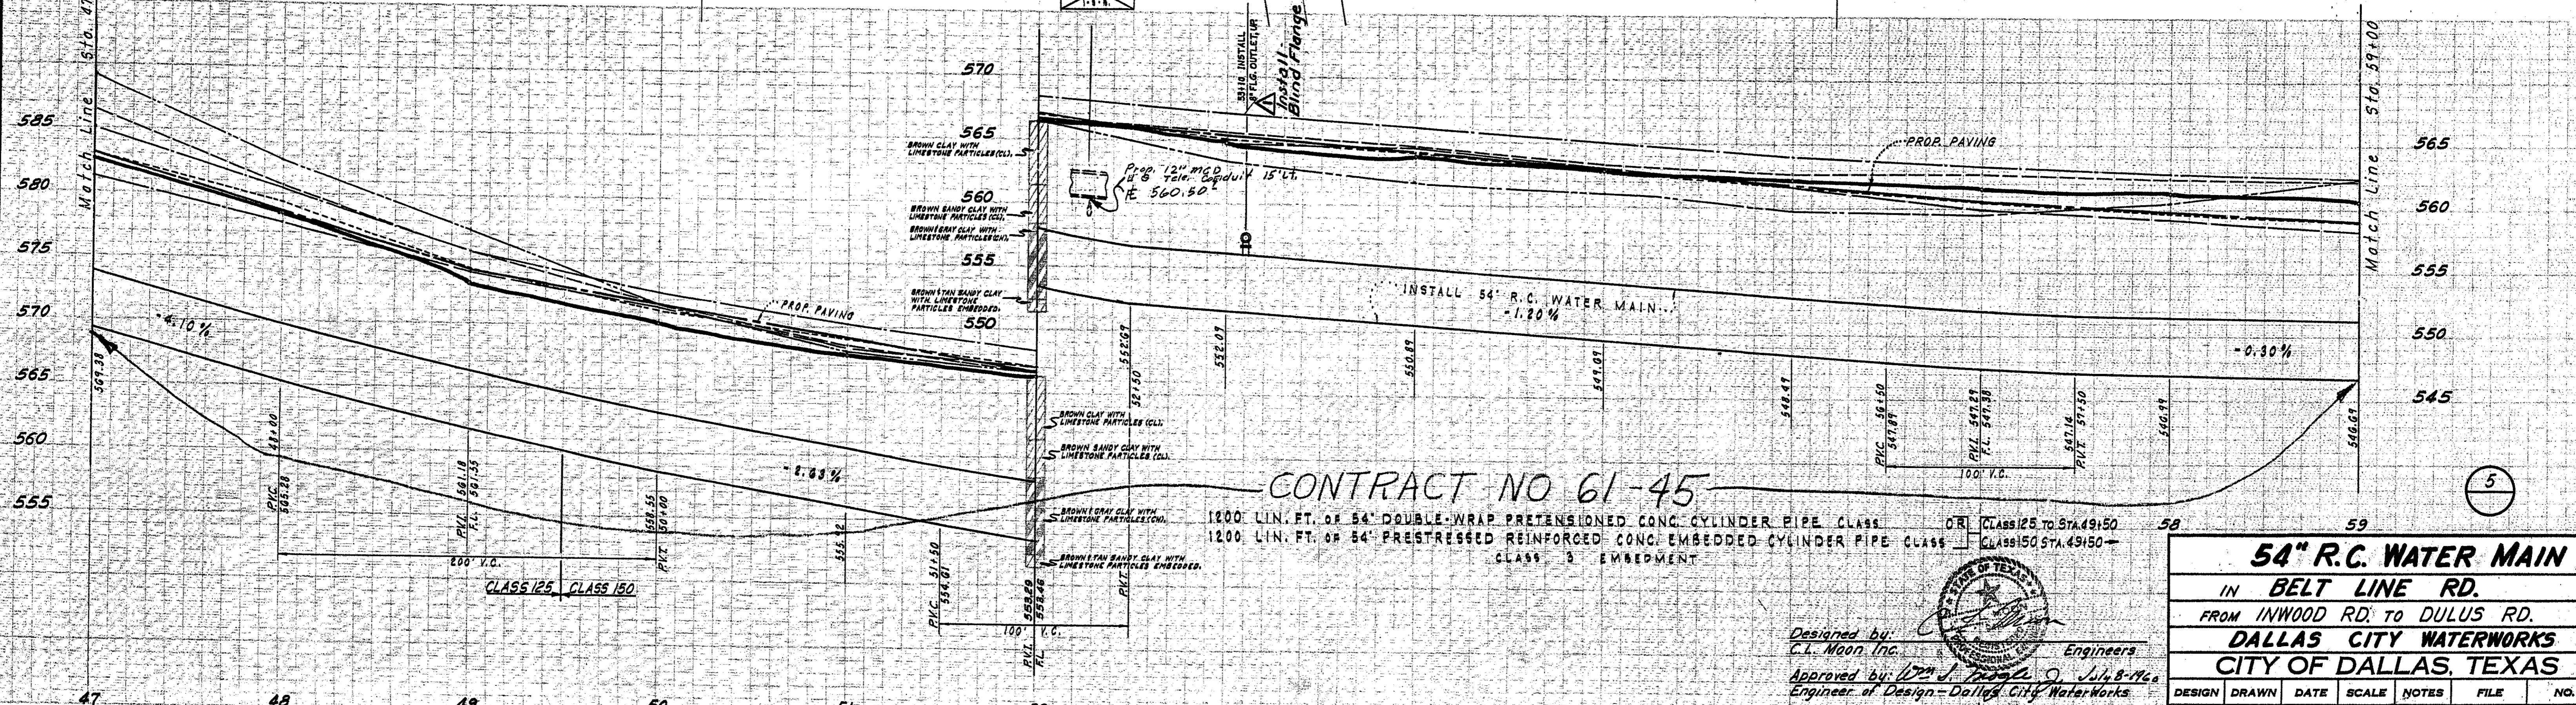

54" R.C. WATER MAIN
IN BELT LINE RD.
FROM INWOOD RD. TO DULUS RD.
DALLAS CITY WATERWORKS
CITY OF DALLAS, TEXAS

Designed by
C.L. Moon, Inc. Engineers
Approved by
C.L. Moon, Inc. Engineer of Design - Dallas City Waterworks

| DESIGN | DRAWN | DATE | SCALE | NOTES | FILE | NO. |
|------------------------|-------|---------|-----------------------|--------|-------------|-----|
| C.L. Moon Engineers | D.P. | May '60 | H: 1"=20' V: 1"=5' | 5/1/60 | 685-W 540-A | |