



PAY ITEM	DESCRIPTION	UNIT	QTY
465.5	8" PVC SEWER PIPE SDR-35	LF	240
465.8	4' DIAMETER M.H.	EA	3

B.M. "O" CUT ON HEADWALL, EAST SIDE OF WINWOOD, 180' SOUTH OF BELT LINE ROAD. ELEV. 555.79 (M.S.L.)

B.M. "O" CUT CENTER FRONT PORCH 5555 CELESTIAL ROAD. ELEV. 577.95 (M.S.L.)

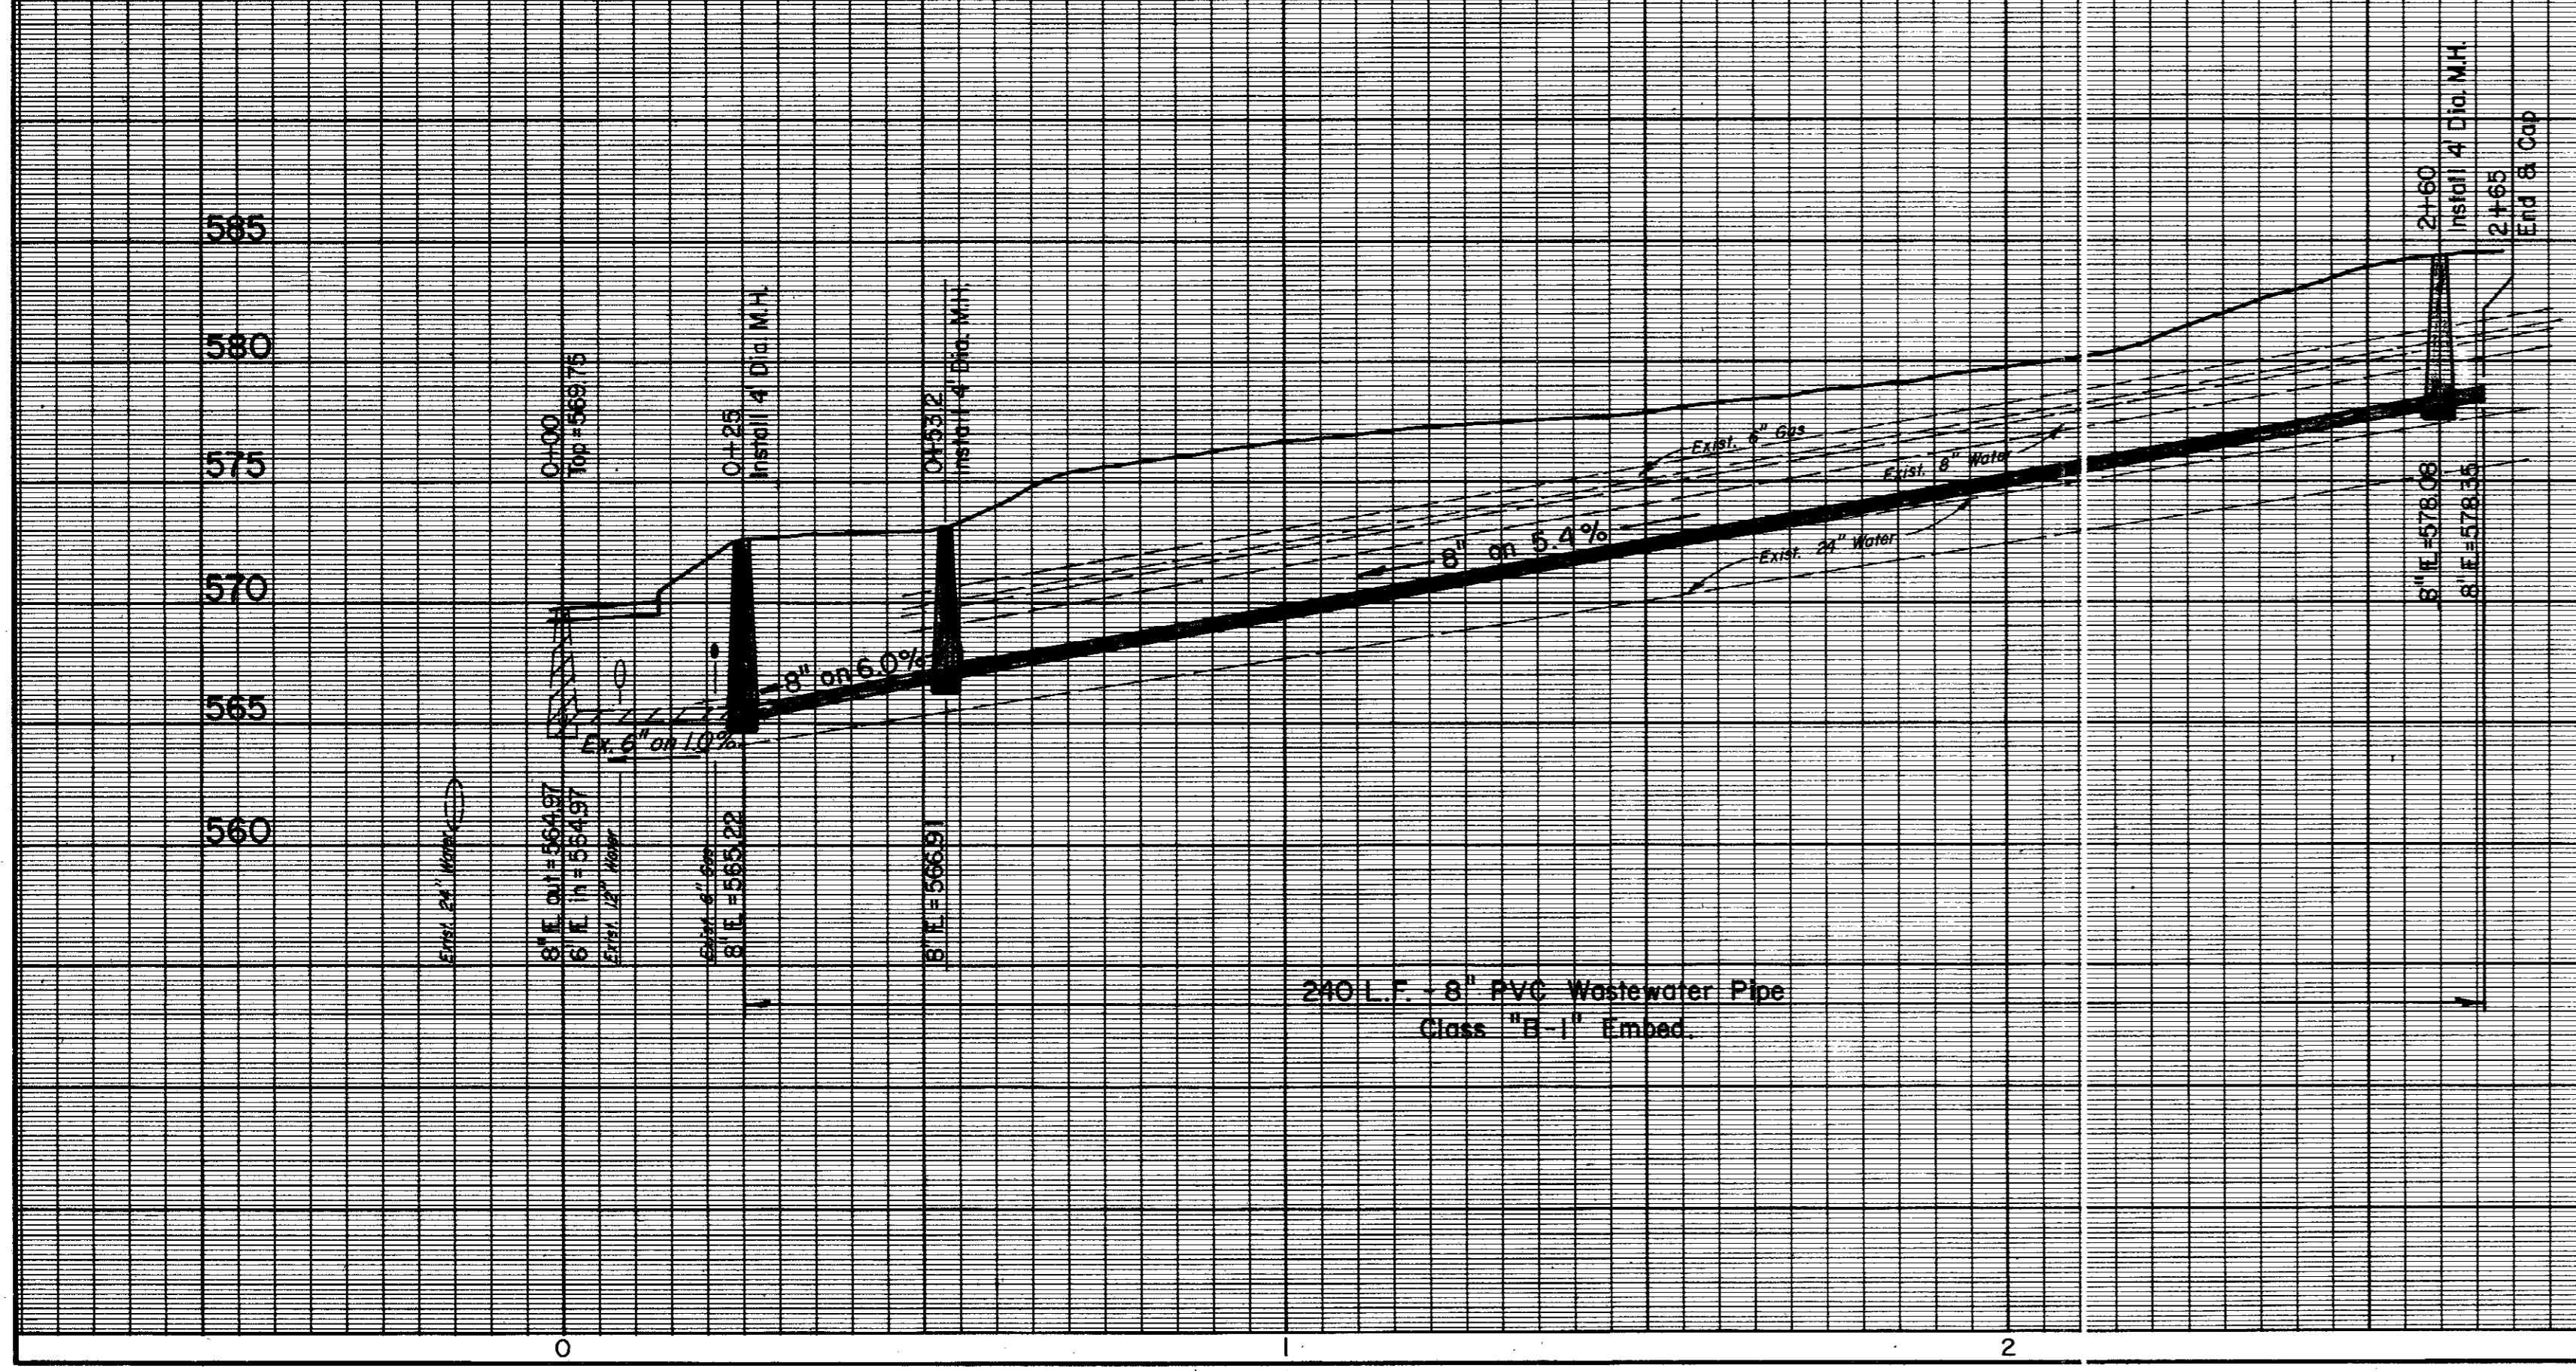

RECORD DRAWING 110

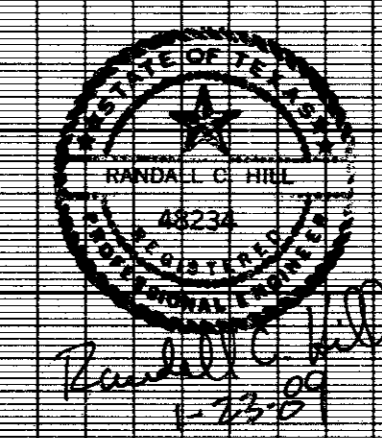

WATER & SANITARY SEWER						
WINWOOD RD. SAN. SWR. IMPROVEMENTS						
PLAN & PROFILE						
WATER UTILITIES DEPARTMENT						
CITY OF DALLAS, TEXAS						
DESIGN	DRAWN	DATE	SCALE	NOTES	FILE	NO.
TEC	TEC	DEC. 1988	1" = 20' H 1" = 6' V		411Q	1960