


CONC. CAP DETAIL FOR EXIST. SANI. SWR.
N.T.S. PAY ITEM 582.1


B.M. \square CUT ON HEADWALL, EAST SIDE OF WINNWOOD RD., 180' SOUTH OF BELTLINE RD. ELEV. 555.79 (M.S.L.)

Scale: 1" = 20'

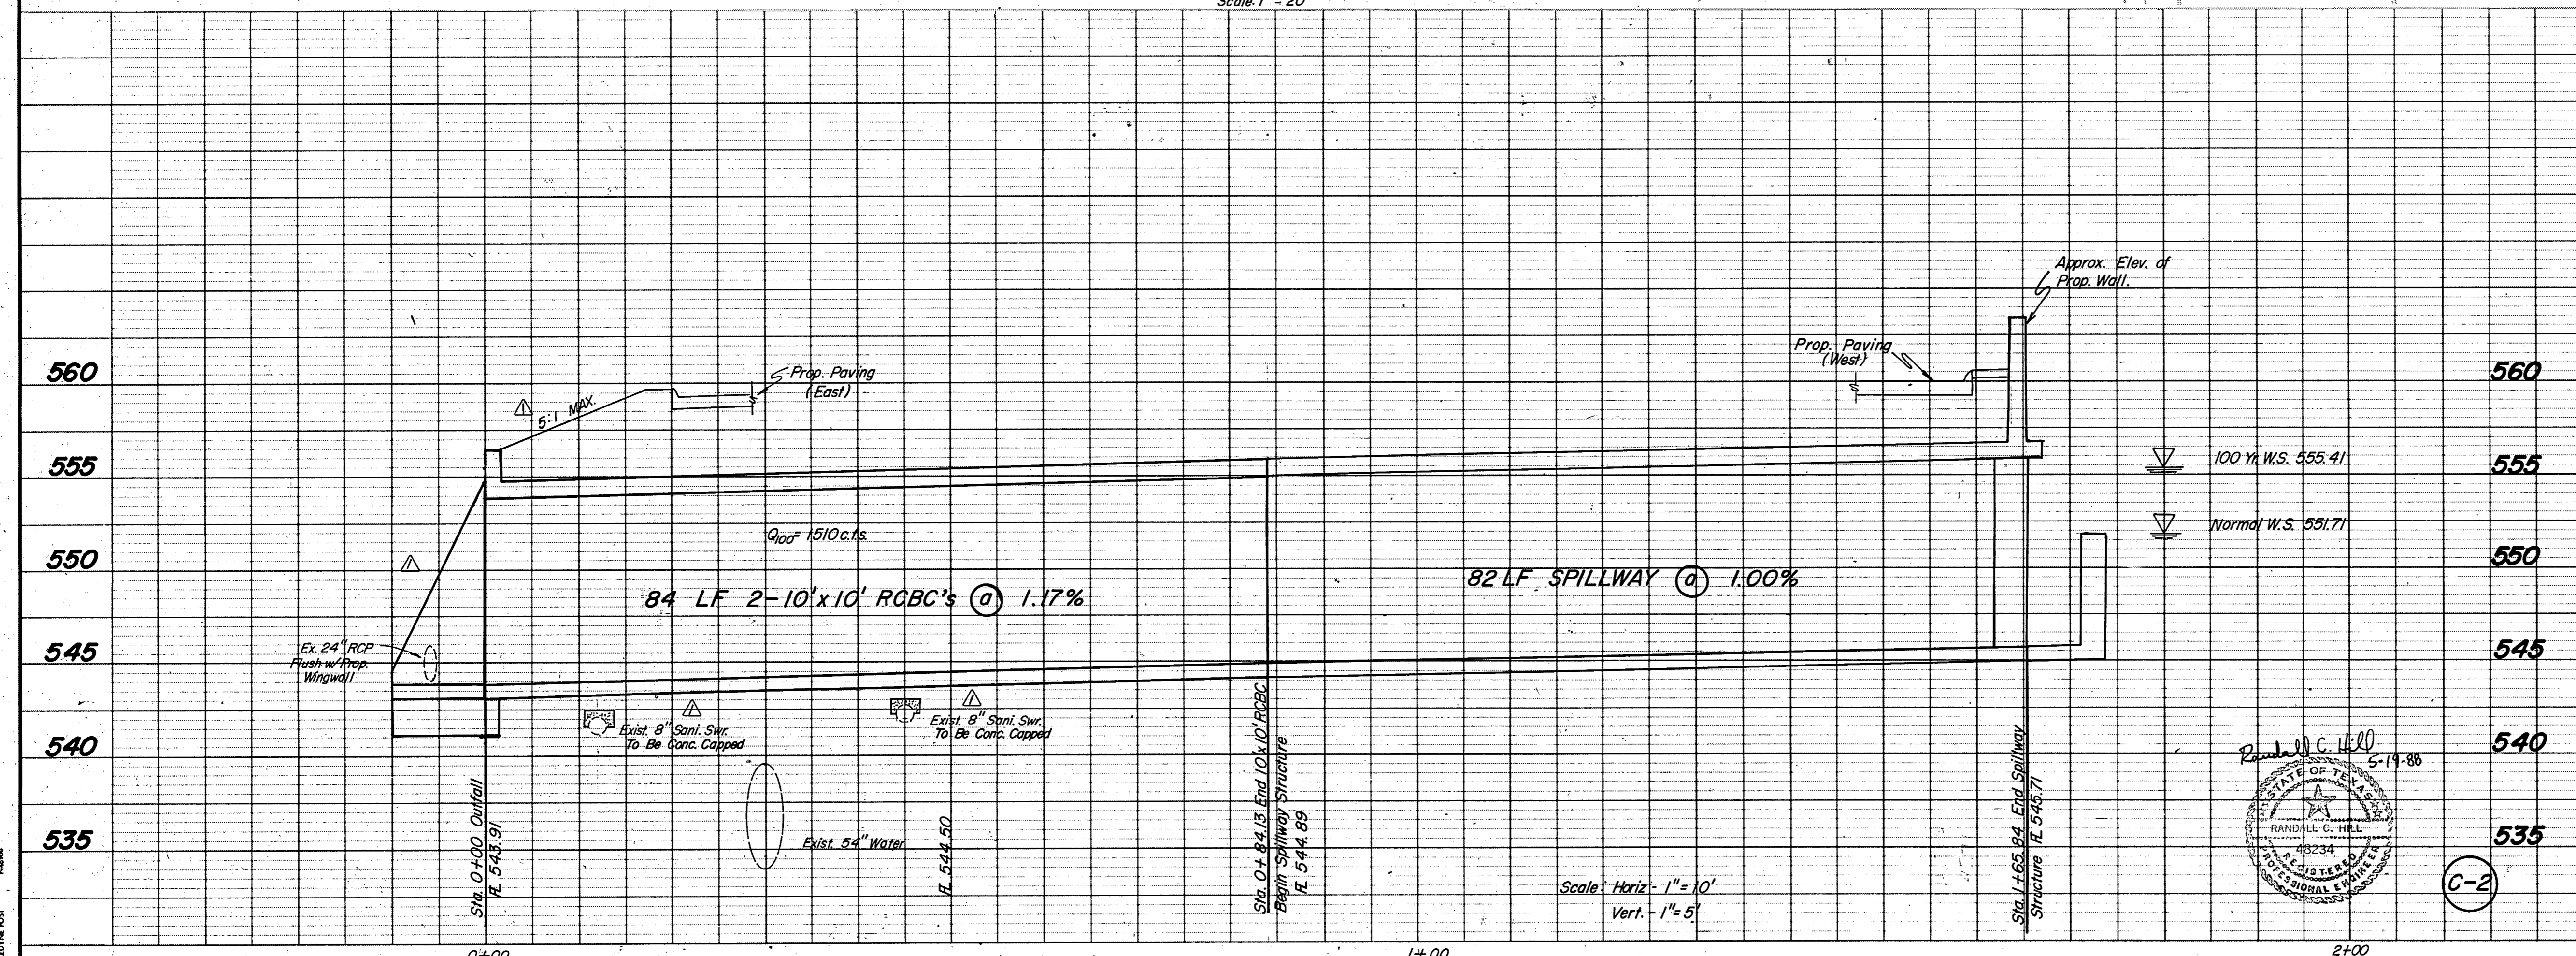

RECORD DRAWING

Revised Wingwall, Added Conc. Cap incl. Detail & Ex. S.S. Notes	R/C	6/2/88
No.	Revision	By Date
TOWN OF ADDISON DALLAS COUNTY, TEXAS		
WINNWOOD CELESTIAL PHASE III		
WINNWOOD ROAD ENTRANCE		
BOX CULVERT PLAN & PROFILE		
GINN, INC. Consulting Engineers Dallas, Texas		
Designed - RCH	Drawn - TEC	Date - Feb., 1988
Approved - HWG	Checked - RCH	Scale - As Noted
		Job No. - 328
		Sheet 2 of 13

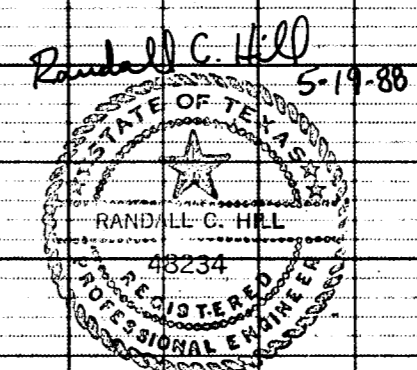

C-2