


**PLAN OF SPILLWAY**  
 scale: 3/16" = 1'-0"

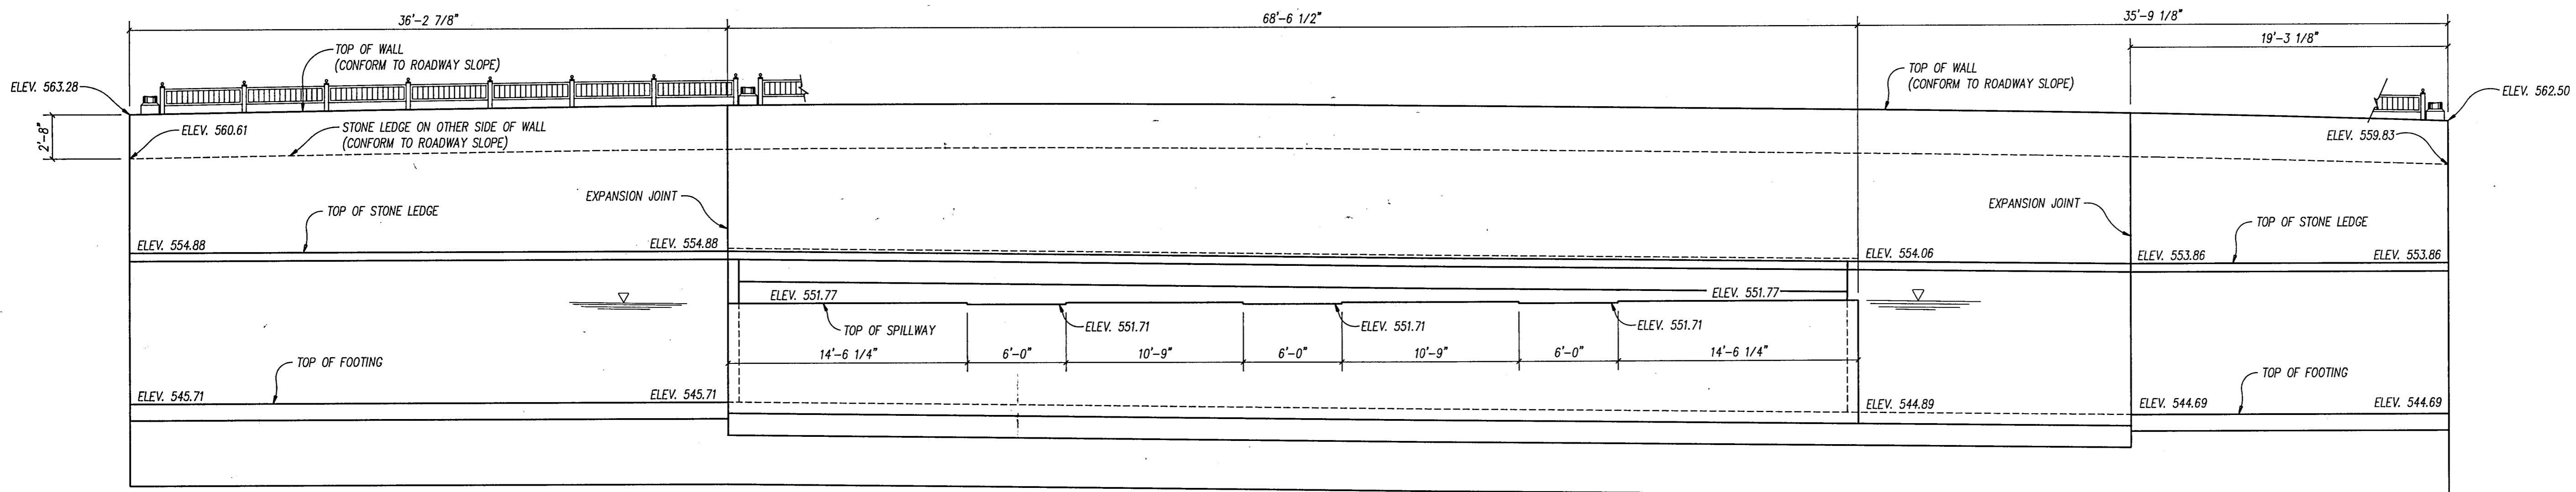

**ELEVATION OF SPILLWAY**  
 SCALE: 3/16" = 1'-0"

**RECORD DRAWING**

No.	Revision	By	Date

TOWN OF ADDISON  
 DALLAS COUNTY, TEXAS  
**WINNWOOD CELESTIAL PHASE III**  
 WINNWOOD ROAD ENTRANCE  
 PLAN & SECTIONS OF SPILLWAY  
**GINN, INC.**  
 Consulting Engineers Dallas, Texas

Designed - SCR Drawn - SCR Date - APRIL 25, 1988 Job No. - 328  
 Approved - HWG Checked - RCH Scale - AS SHOWN Sheet 8 of 13

REEDCON, INC.  
 STRUCTURAL ENGINEERS

These plans and related specifications were prepared for construction of this specific project only. Reuse of these documents is not permitted without written authorization of Reedcon, Inc.

*Sanford*  
 APR 25 1988