

CONSTRUCTION PLANS
FOR
JW OPERATING - PHASE 1
ADDISON AIRPORT INDUSTRIAL DISTRICT
LOT 7A, BLOCK B
5.083 ACRES
TOWN OF ADDISON, DALLAS COUNTY, TEXAS
PW# 2007-002

FOR

HIDELL ASSOCIATES ARCHITECTS
 3033 KELLWAY DRIVE, SUITE 120
 (972) 416-4666

OWNER/DEVELOPER




JW Operating Company
 P.O. BOX 226406
 DALLAS, TX 75222-6406

PREPARED BY




8350 N. CENTRAL EXPWY., SUITE 1000 PH. 972.235.3031
 DALLAS, TEXAS 75206 FAX 972.235.9544

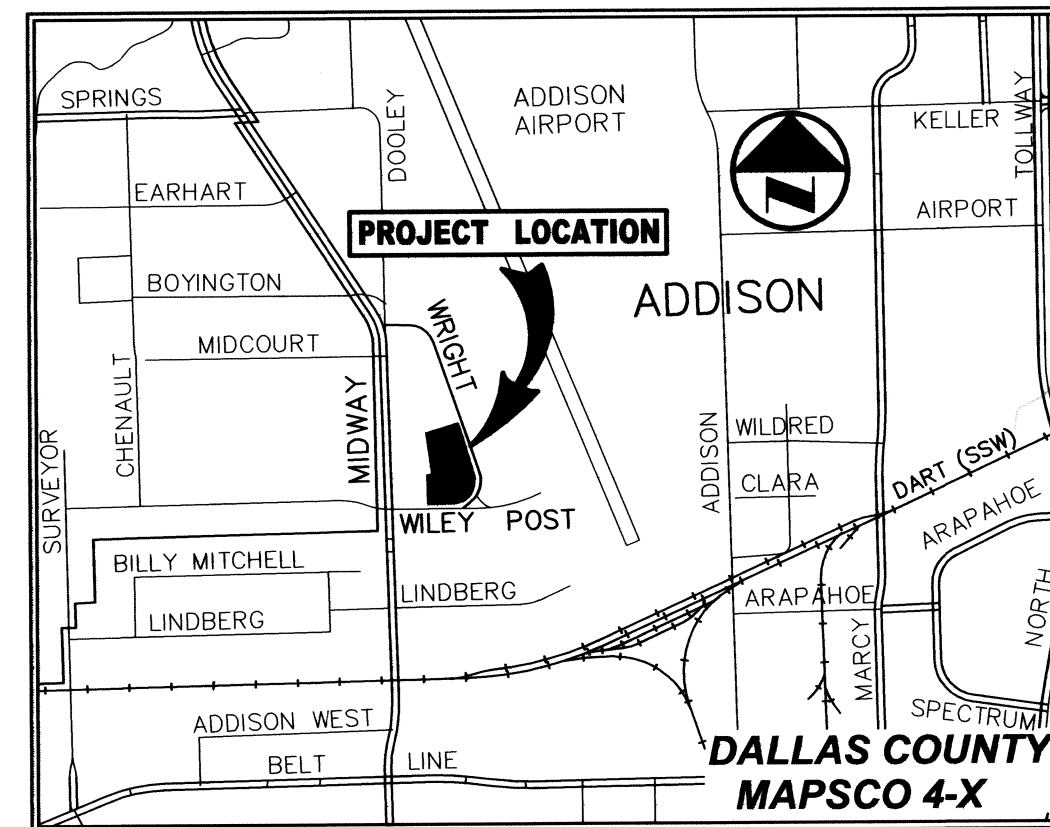

VICINITY MAP
(NOT TO SCALE)

DRAWING SHEET INDEX

SHEET	DESCRIPTION
-	REPLAT
C1.1	DIMENSIONAL CONTROL PLAN
C2.1	GRADING PLAN
C2.2	STORM SEWER PLAN
C2.3	STORM SEWER PROFILES
C3.1	EXISTING DRAINAGE AREA MAP
C3.2	PROPOSED DRAINAGE AREA MAP
C4.1	WATER & SANITARY SEWER PLAN
C5.1	PAVING PLAN & DETAILS
C6.1	EROSION CONTROL PLAN & DETAILS

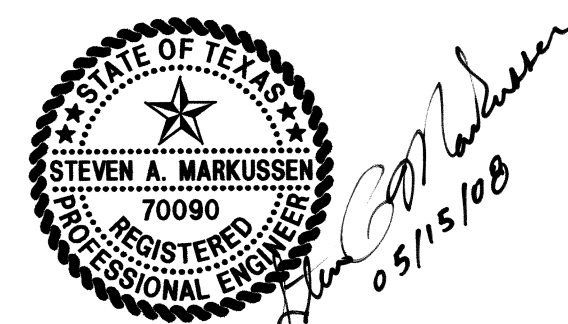

THE SEAL APPEARING ON THIS DOCUMENT WAS AUTHORIZED BY STEVEN A. MARKUSEN, P.E. 70090 ON 05/15/2008. ALTERATION OF A SEALED DOCUMENT WITHOUT PROPER NOTIFICATION TO THE RESPONSIBLE ENGINEER IS AN OFFENSE UNDER THE TEXAS ENGINEERING PRACTICE ACT.

RECORD DRAWING

THIS DRAWING HAS BEEN REVISED TO REFLECT CONSTRUCTION RECORDS MAINTAINED AND PROVIDED BY THE CONTRACTOR FOR THIS PROJECT.

CONTRACTOR: PINION CONSTRUCTION
 DATE REVISED: 06/24/2010

▲	04/30/2010	ADDED ACCESS RAMPS TO WEST SIDE OF BUILDING
▲	03/17/2009	REVISED WATER LINE - ADDED VERTICAL BENDS
▲	03/03/2009	REVISED WATER LINE
▲	09/29/2008	REVISED TRANSFORMER PAD LOCATION
▲	08/21/2008	REVISED SITE PLAN AND ADDED STORM DRAINS
▲	08/11/2008	ADDED TRANSFORMER PADS AND REVISED STORM LINE
▲	07/09/2008	REVISED GRADING AND ADDED CURB WALL
▲	06/18/2008	REVISED FIRE HYDRANT LOCATION
▲	06/12/2008	REVISED ST-1
▲	06/11/2008	REVISED BUILDING FOOTPRINT