




10 TREE GROUND STAKING IN LEVEL PLANTING AREA - PLAN
NOT TO SCALE

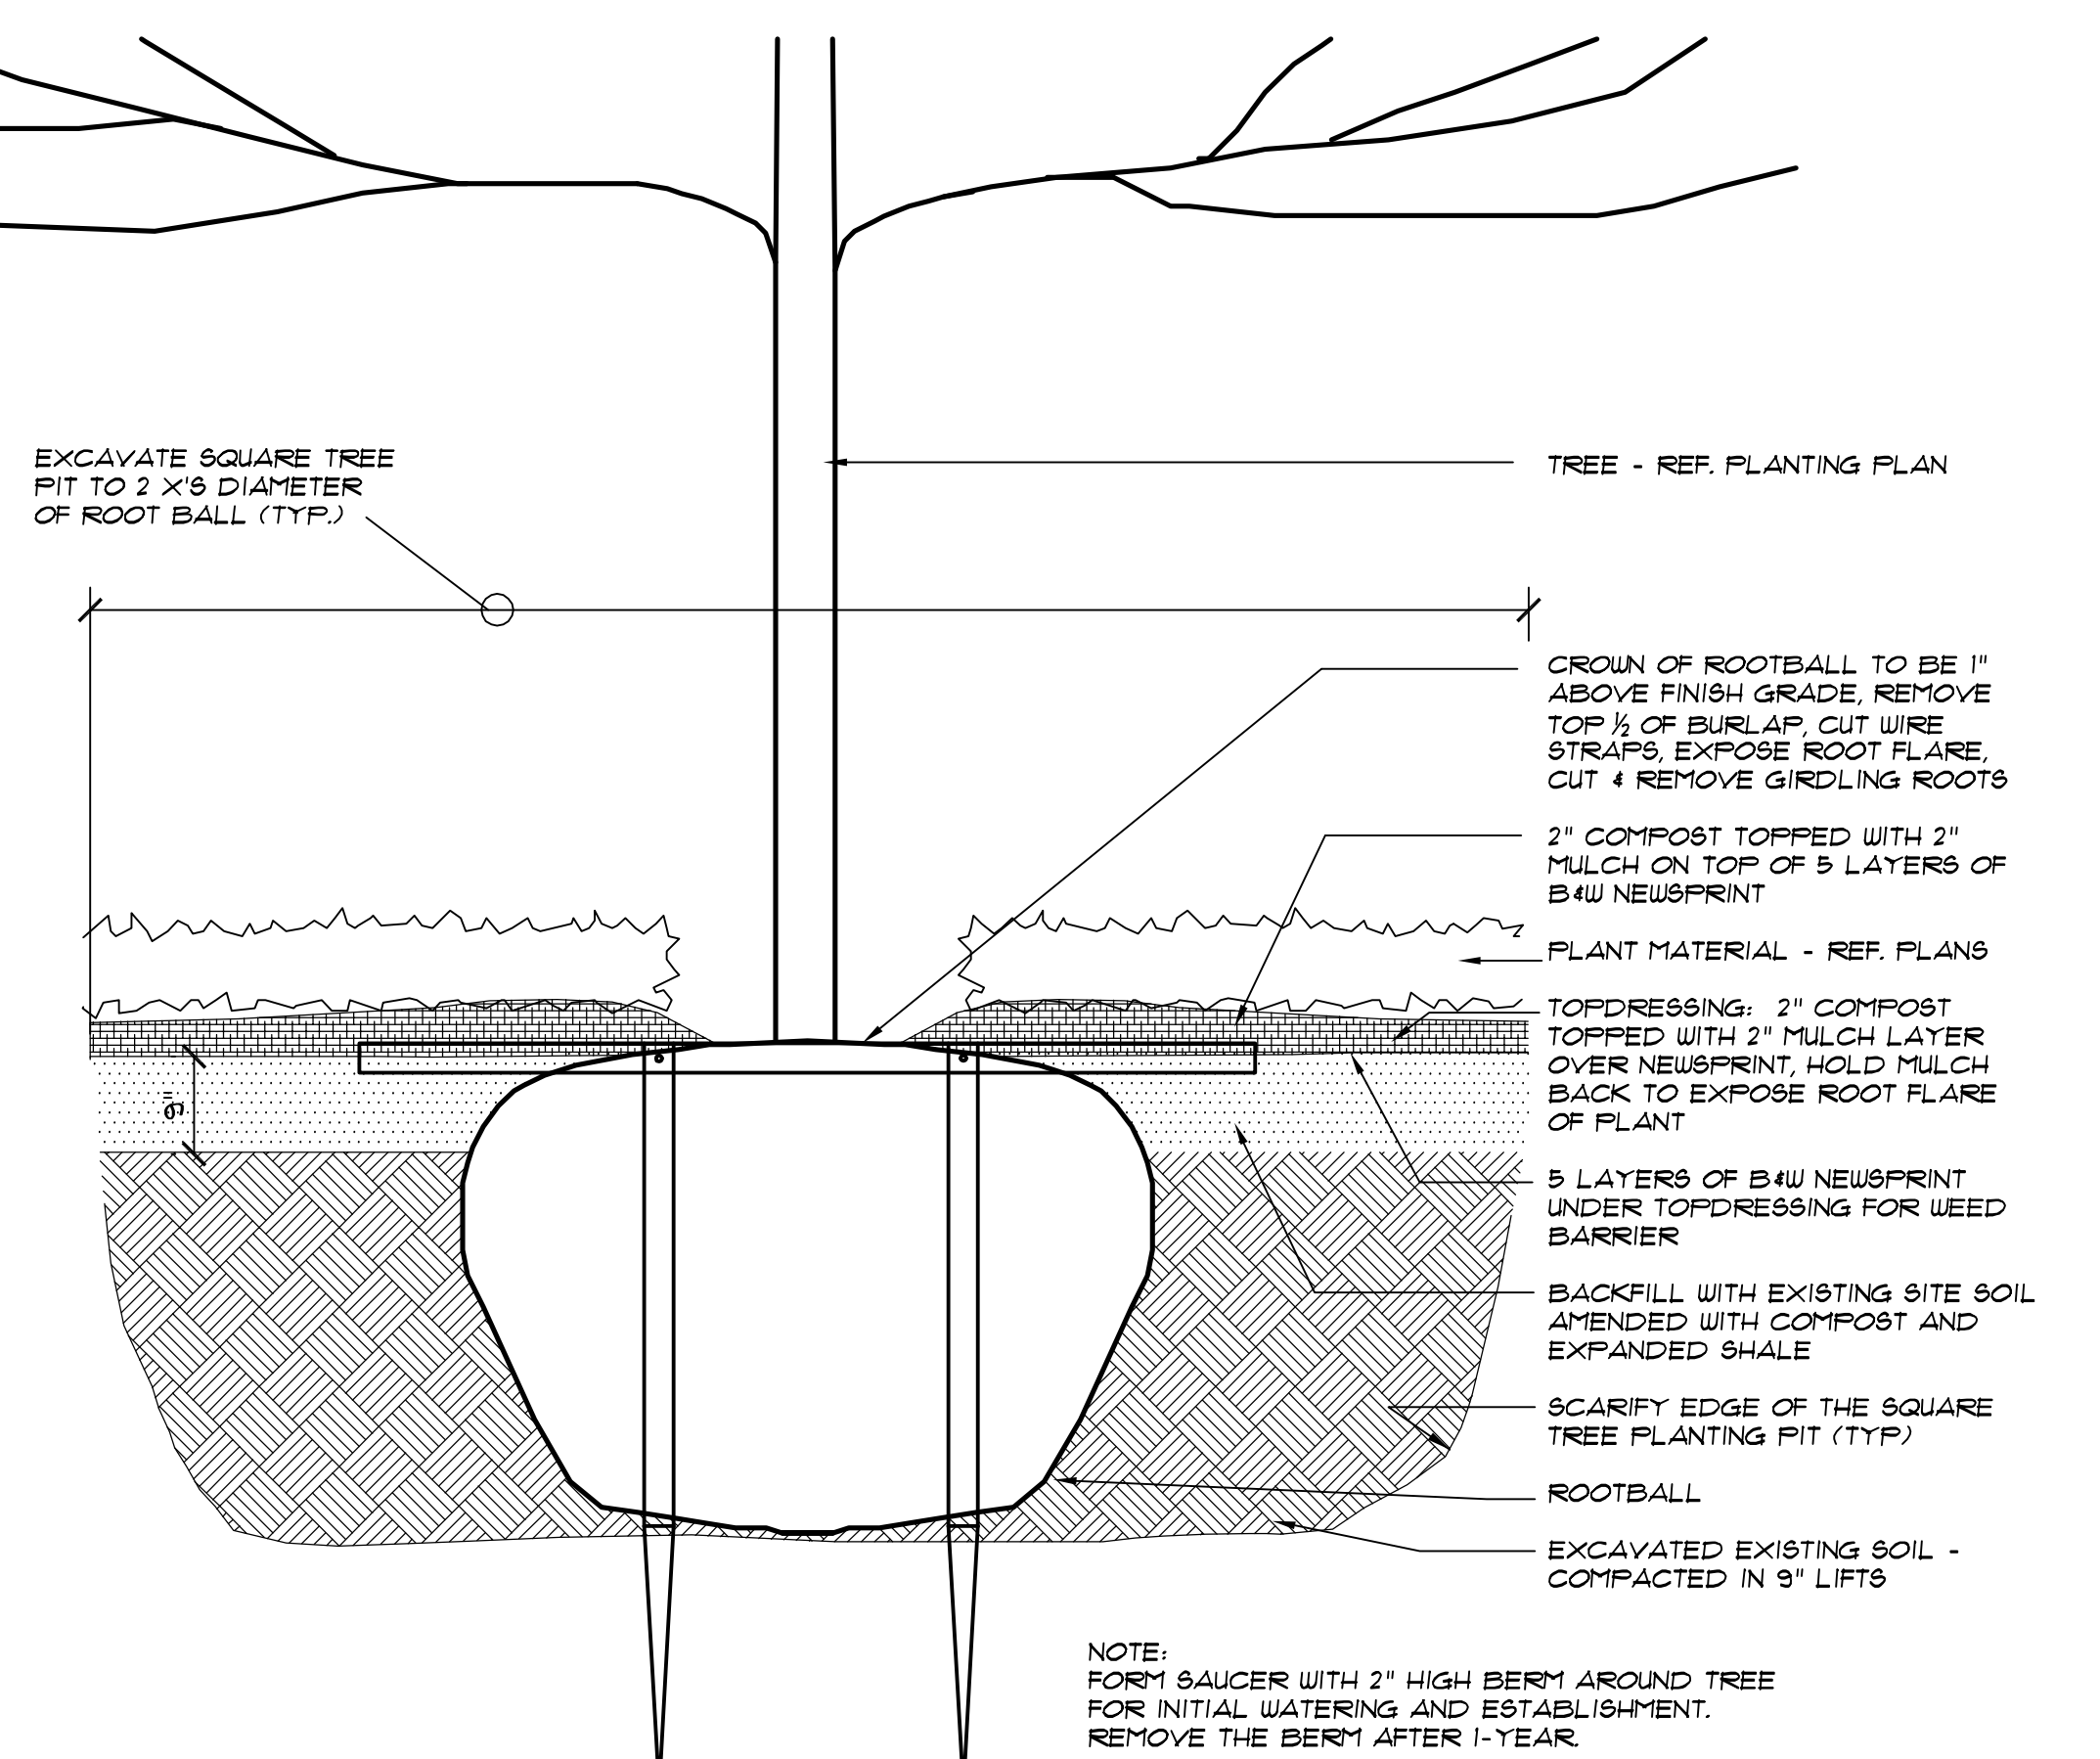


11 CANOPY TREE PLANTING / STAKING - SECTION
NOT TO SCALE

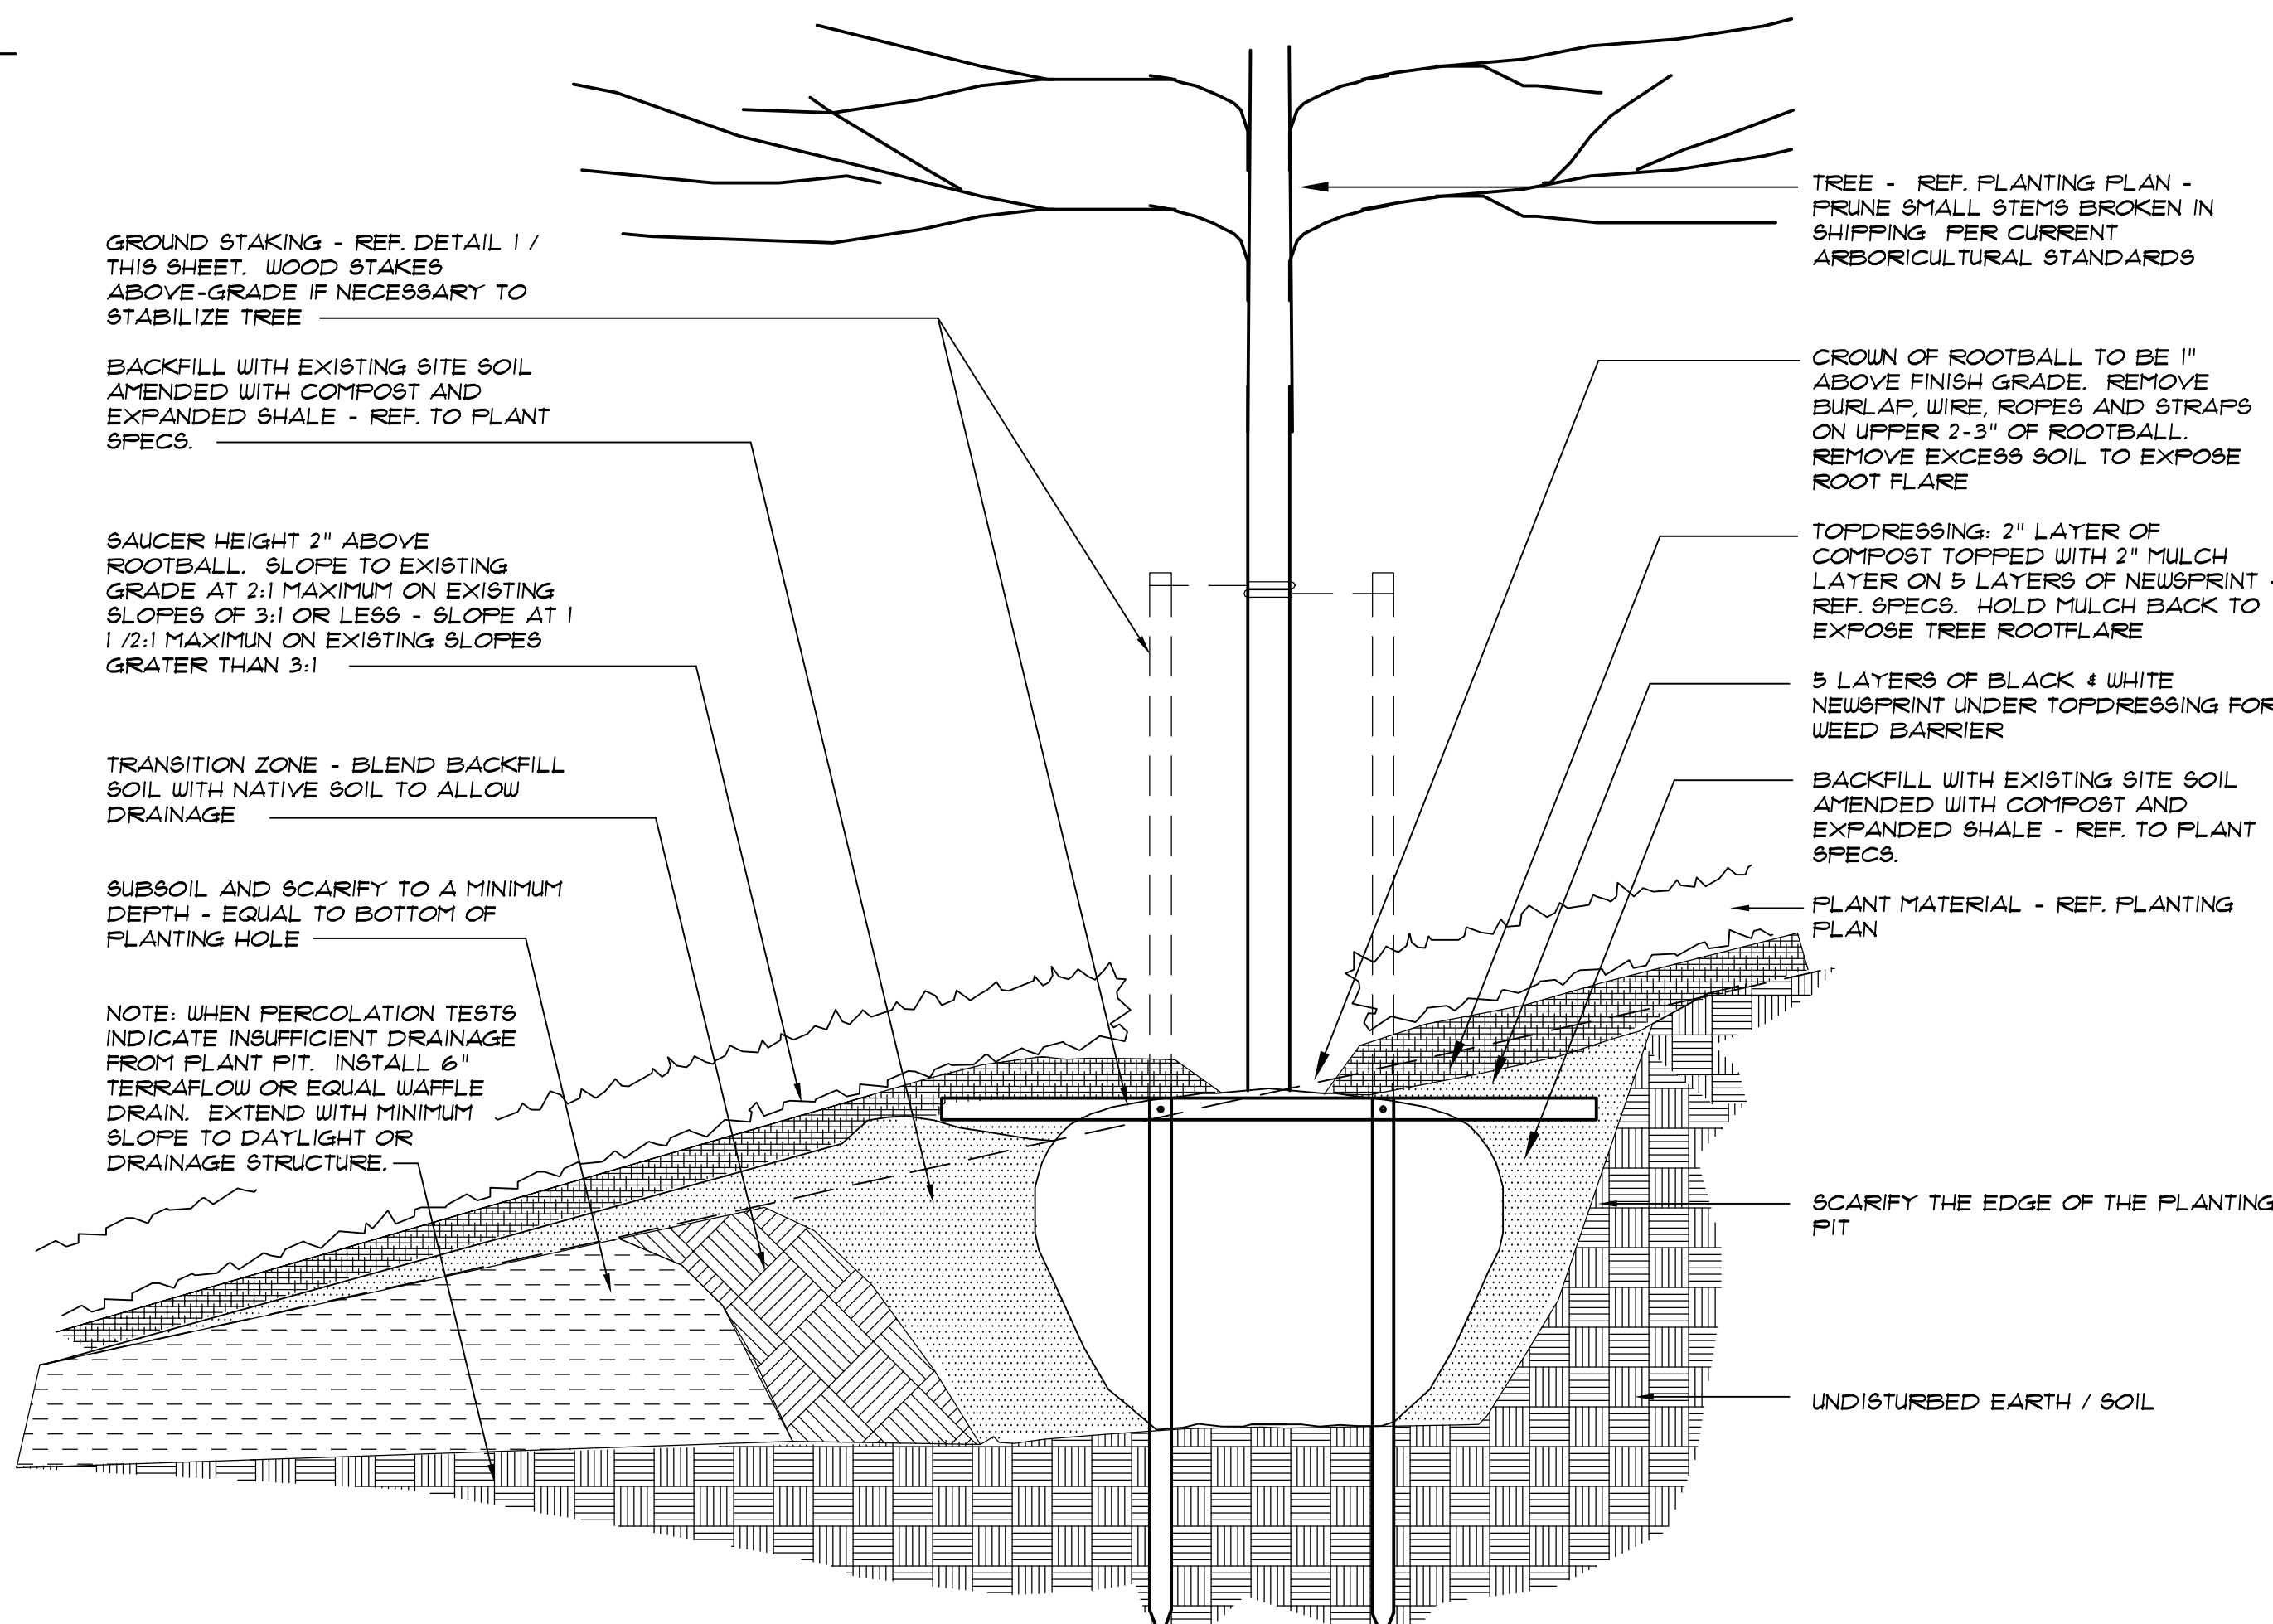


09 TREE PLANTING / STAKING ON PLANTED SLOPE - SECTION
NOT TO SCALE

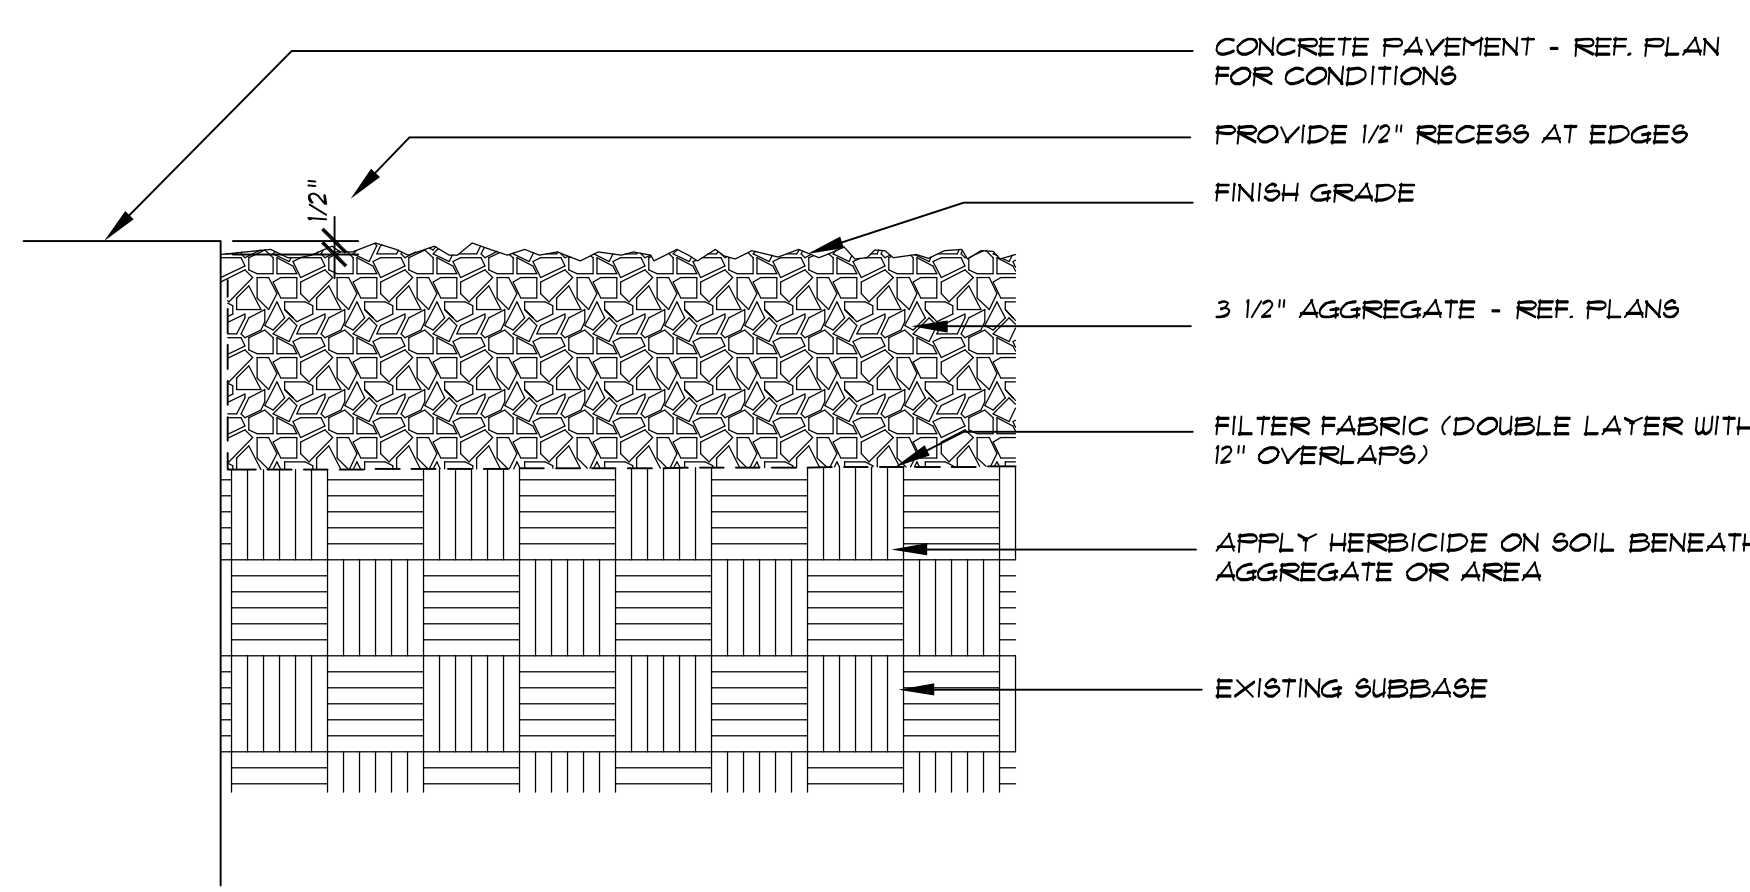


06 AGGREGATE AT PAVING - SECTION
NOT TO SCALE

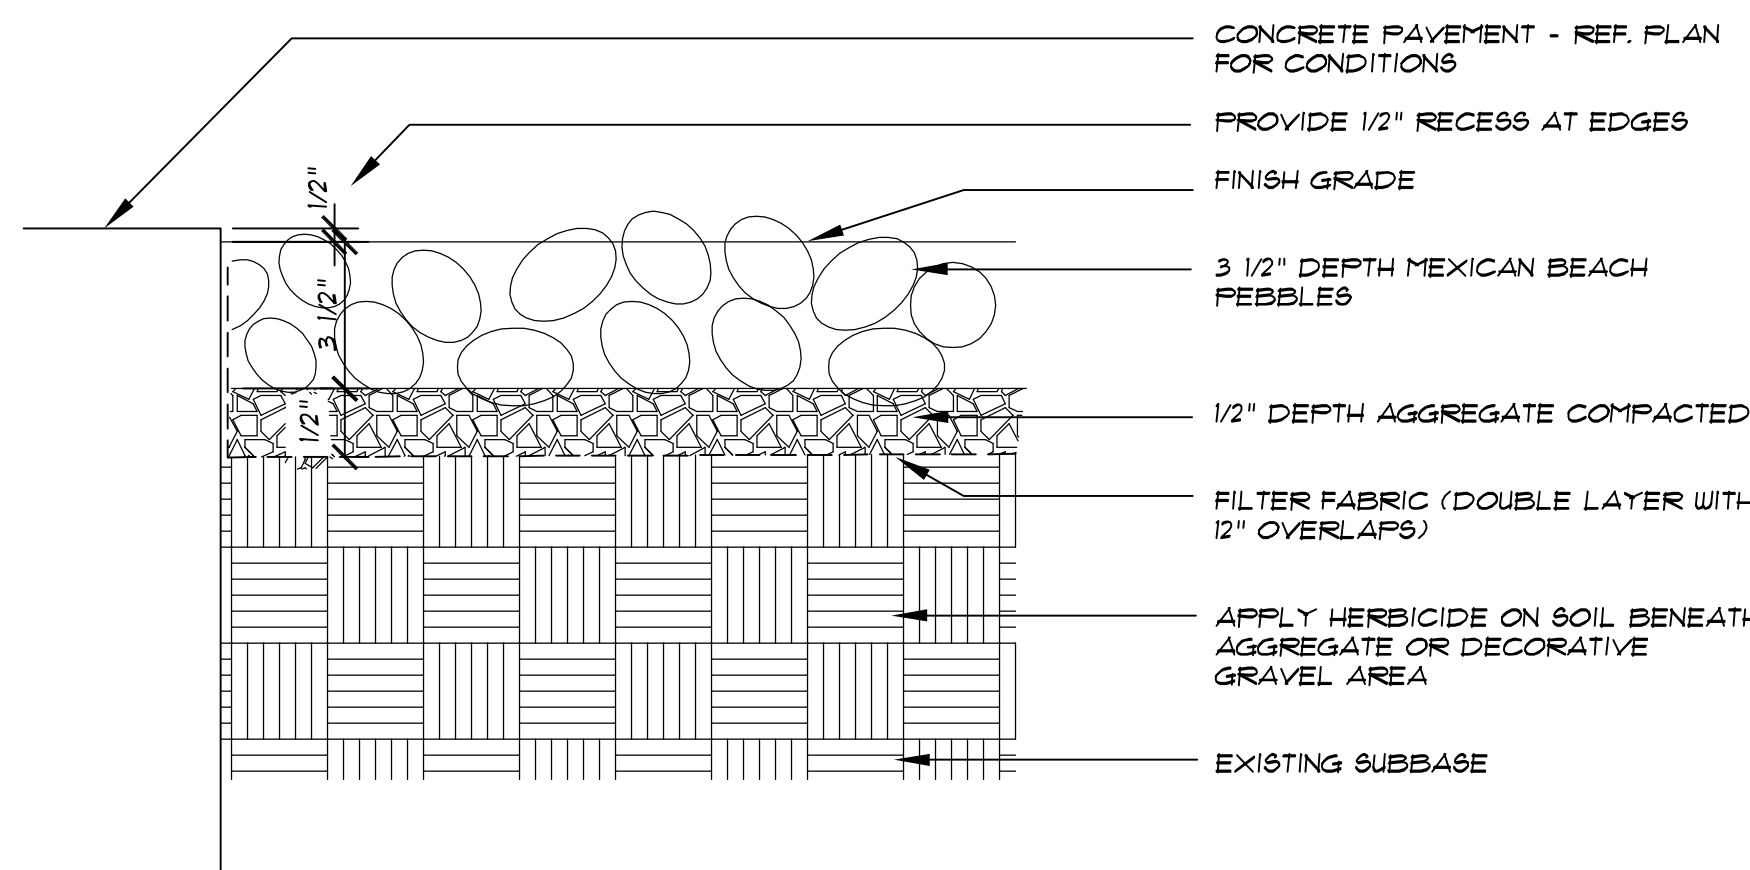


07 DECORATIVE GRAVEL AT PAVING - SECTION
NOT TO SCALE

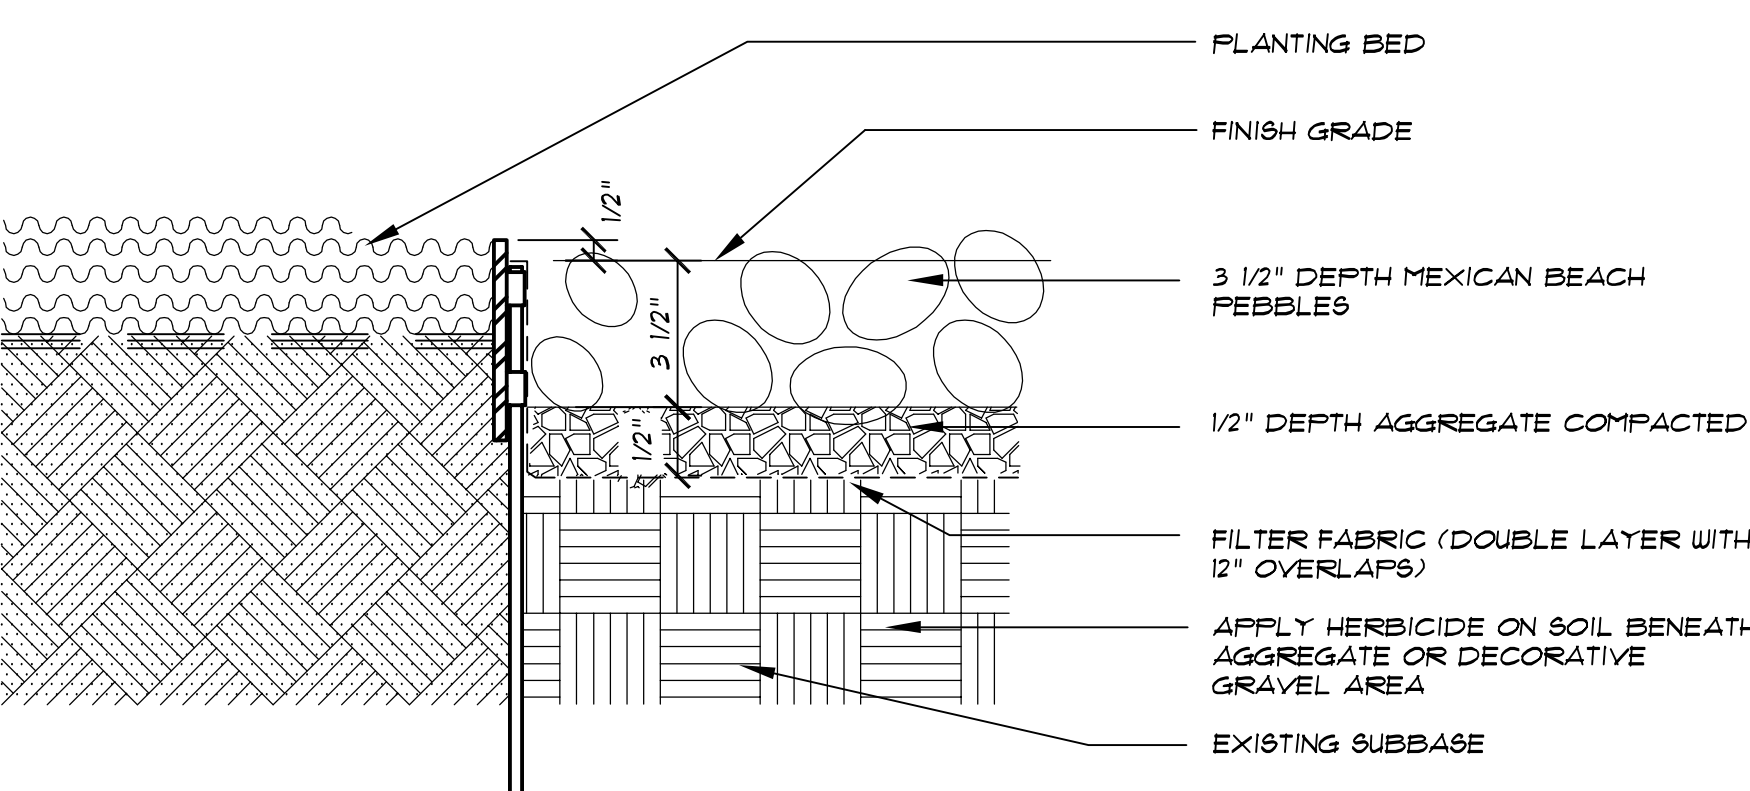


08 DECORATIVE GRAVEL AT PLANTING - SECTION
NOT TO SCALE

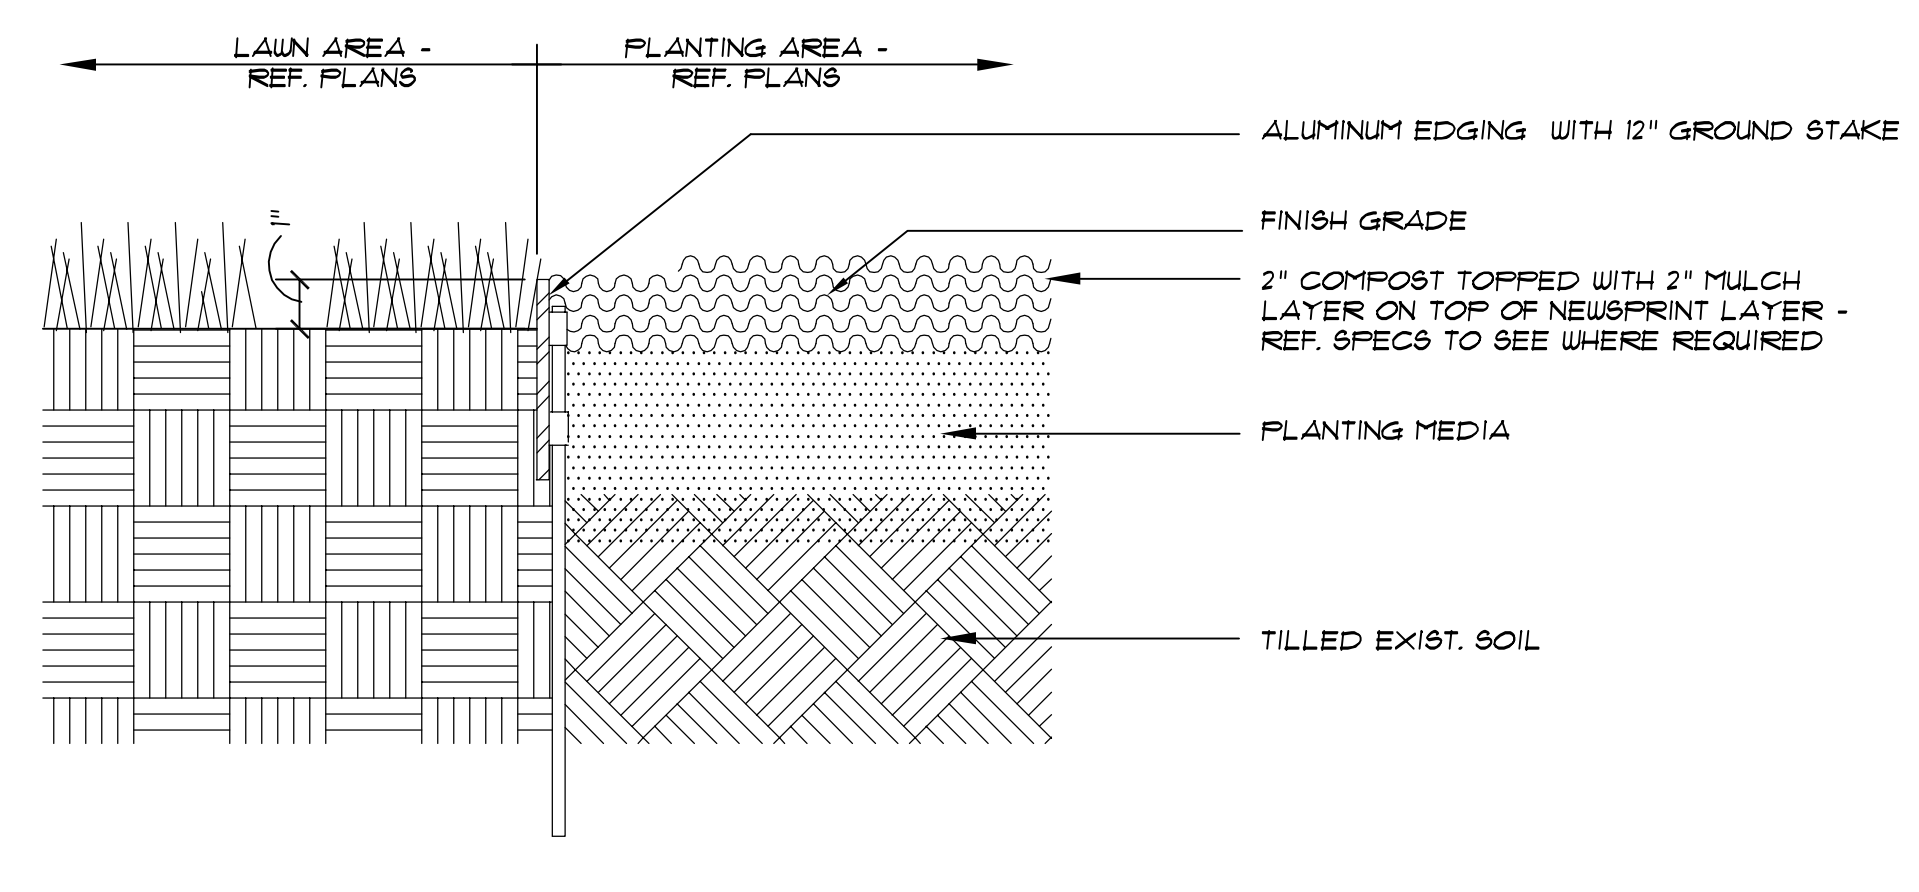


01 EDGING AT LAWN AND PLANTING BED - SECTION
NOT TO SCALE

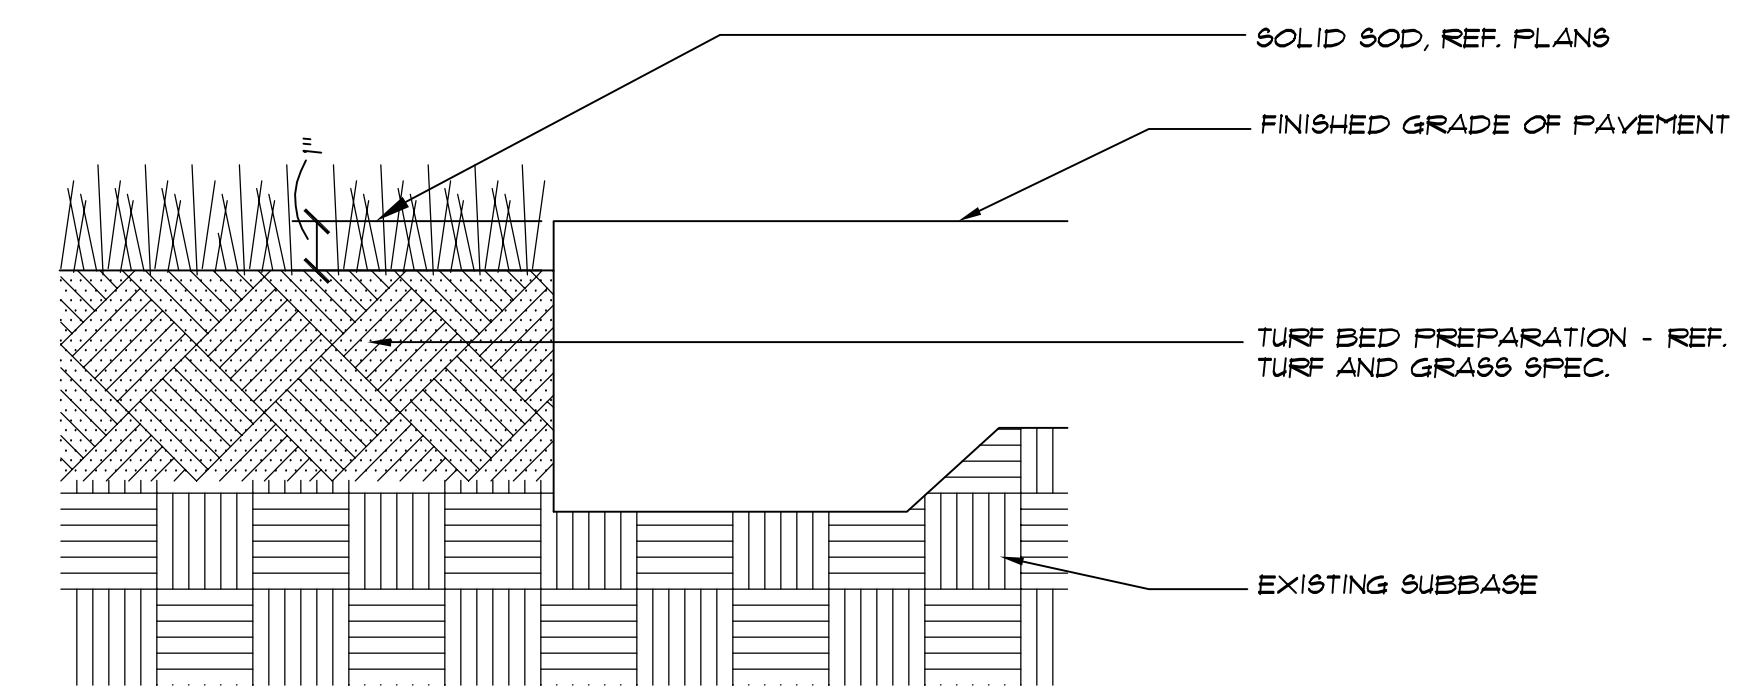


02 LAWN AT PAVING - SECTION
NOT TO SCALE

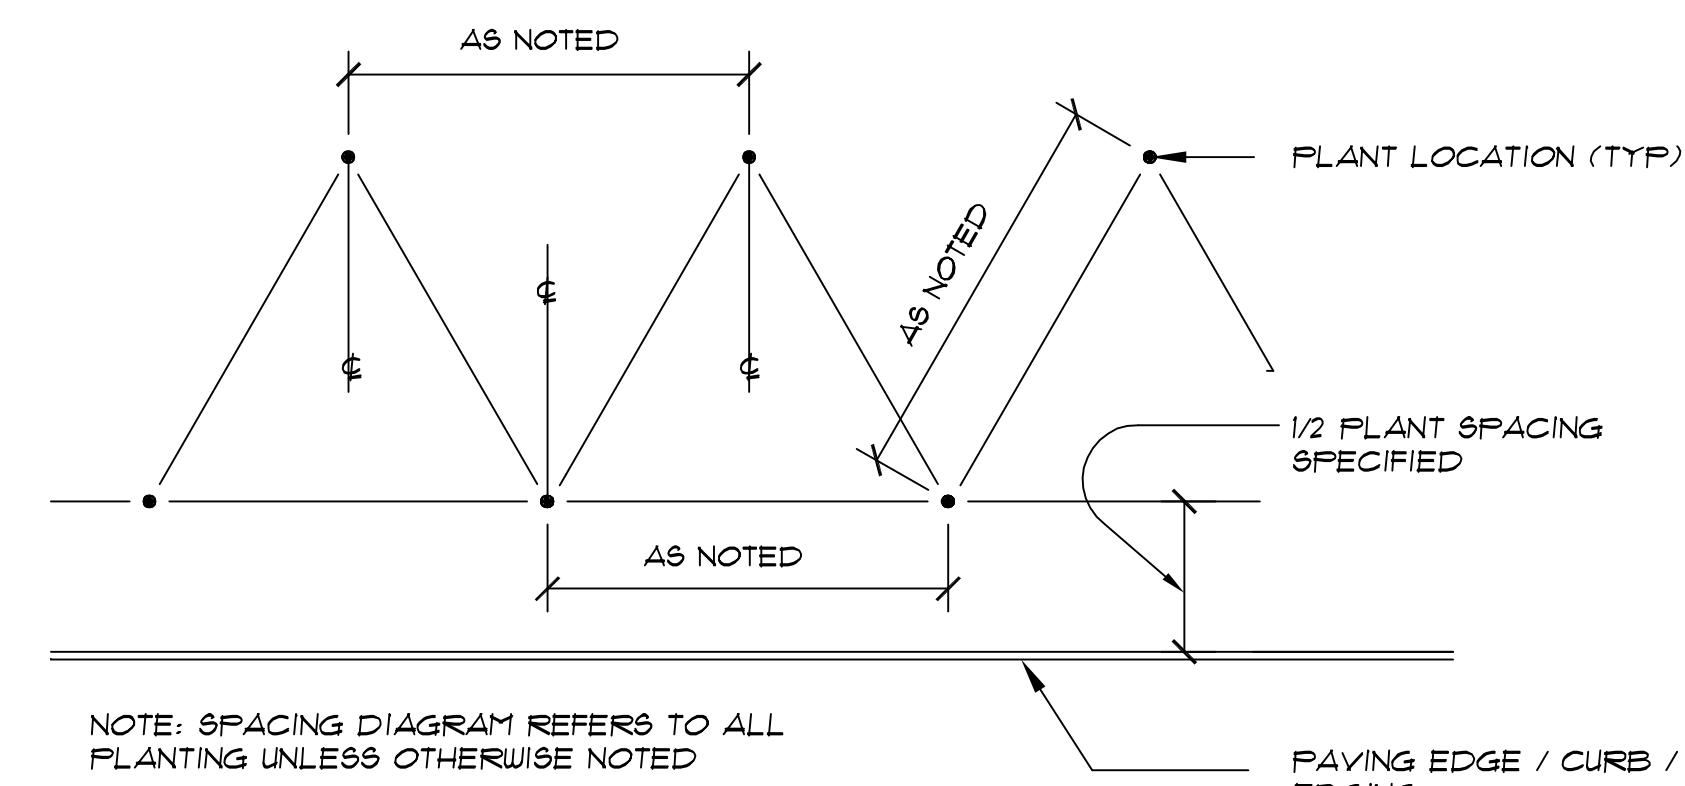

03 TRIANGULAR SPACING - PLAN
NOT TO SCALE

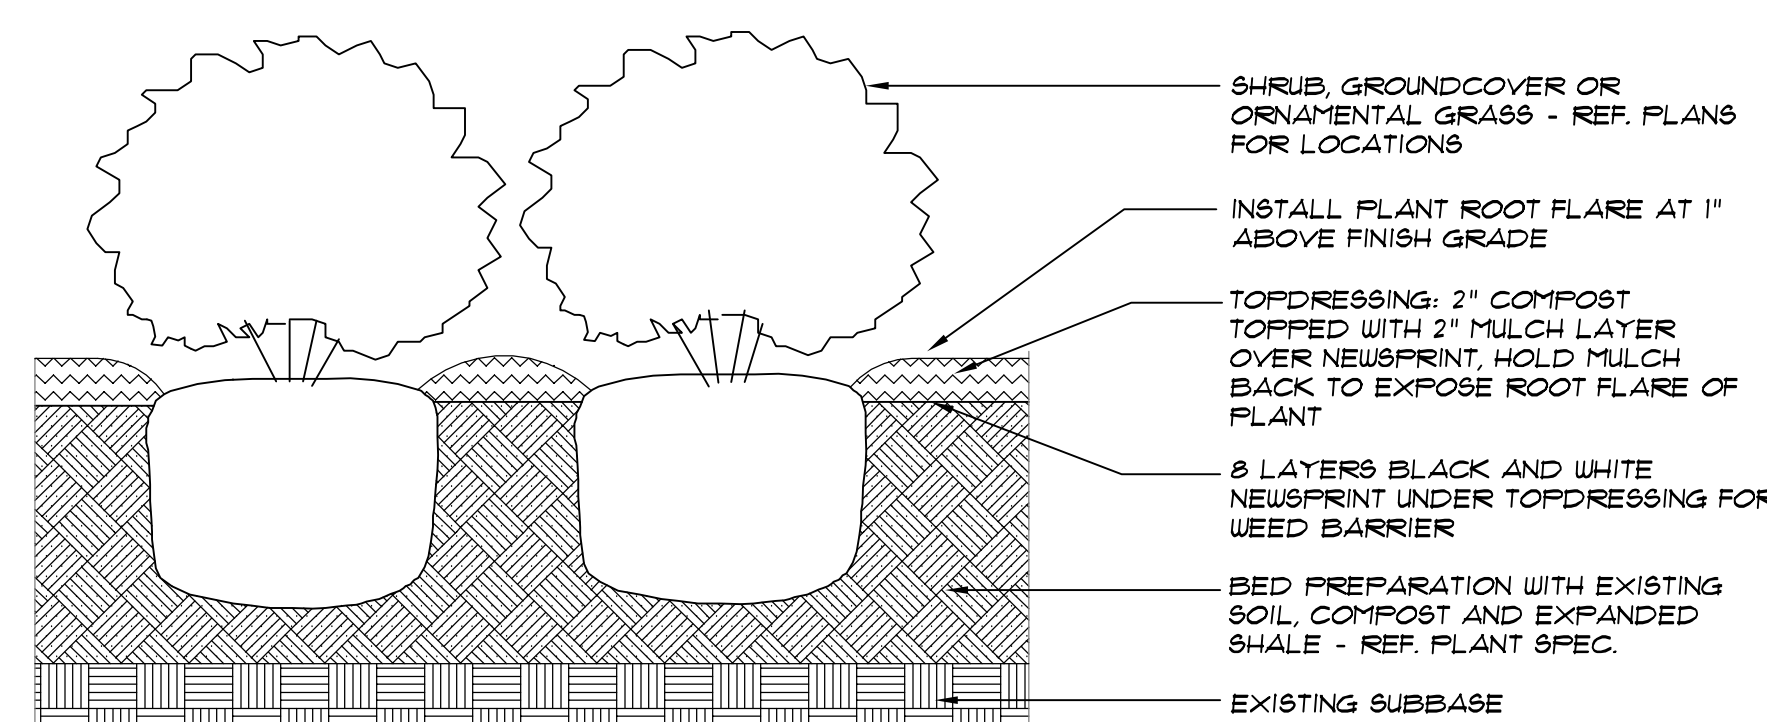

04 SHRUB / GROUNDCOVER / ORN. GRASS - SECTION
NOT TO SCALE

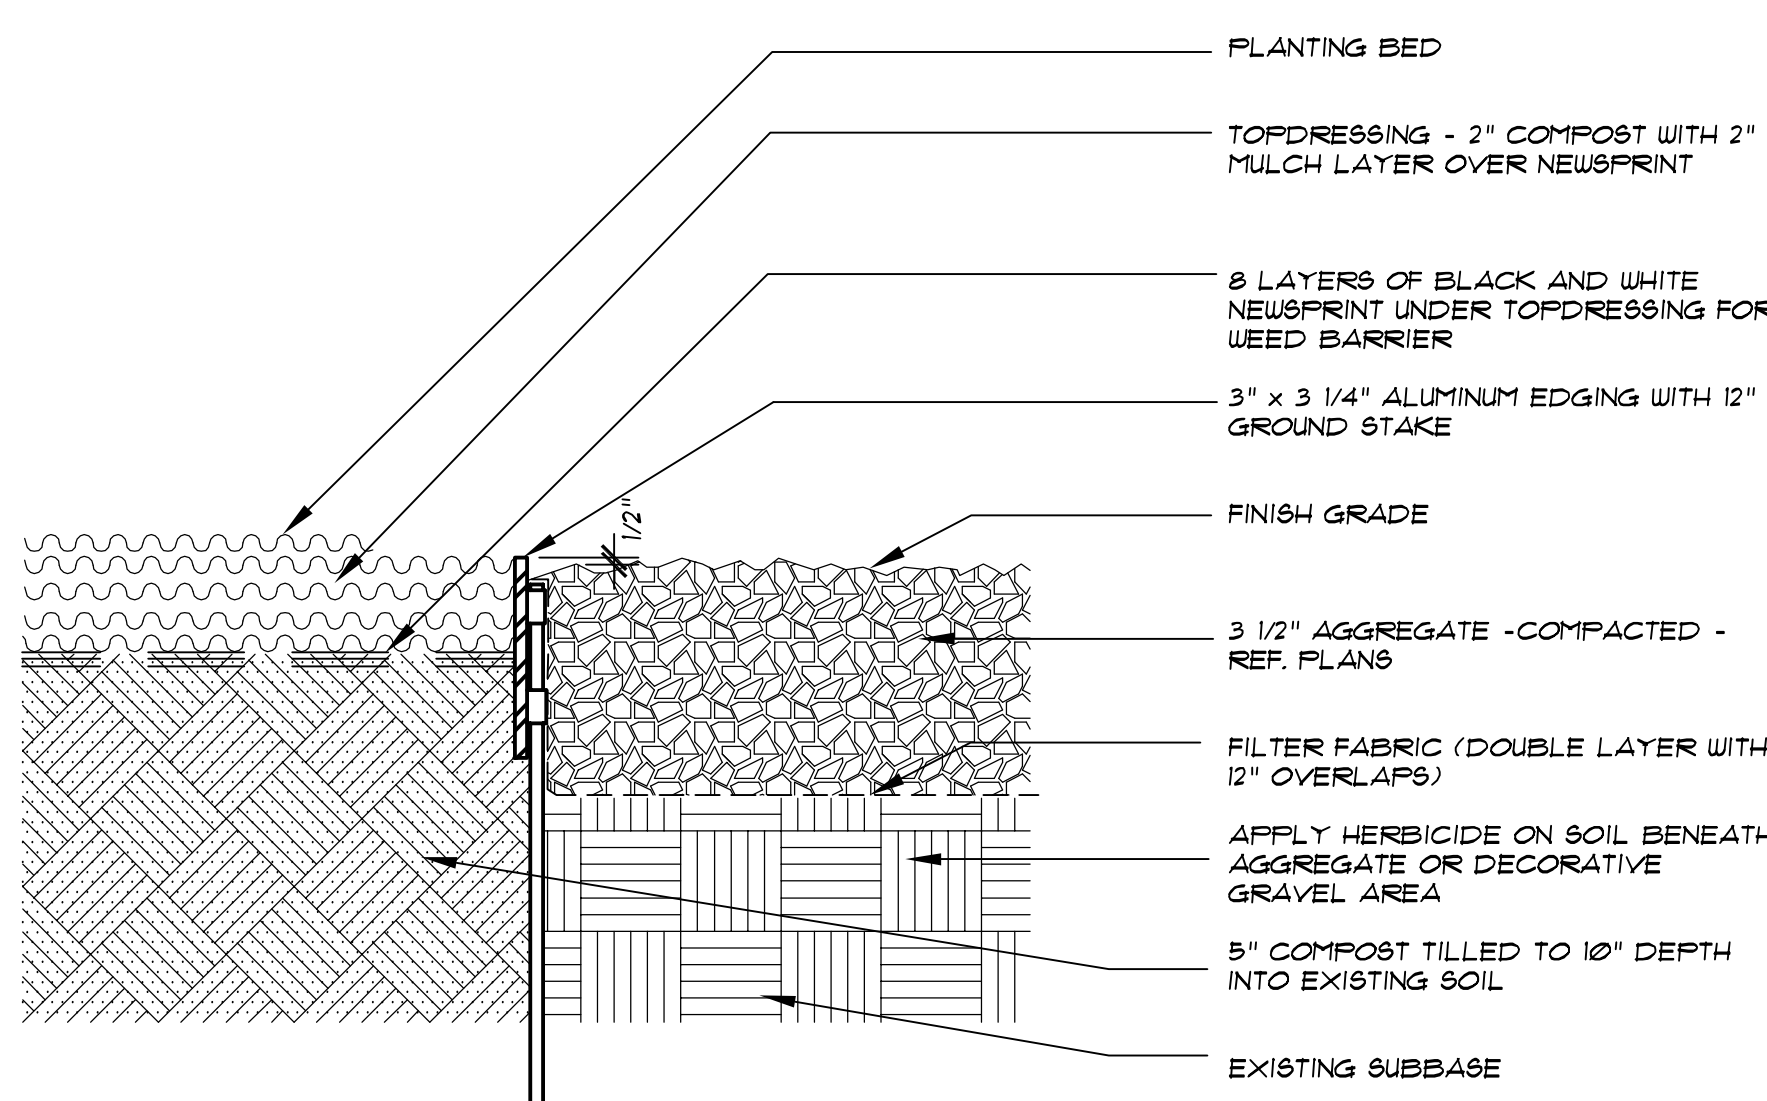

05 AGGREGATE AT PLANTING BED - SECTION
NOT TO SCALE

TITLE

PLANTING DETAILS & NOTES

REVISIONS

05.11.2010 PLANTING MODS.

JOB NO. 26010

Issue Date: 04/23/2010

Drawn By: bb

Checked By: cc

SHEET NO.

AS-BUILTS

L-1.3

ISSUE FOR REVIEW ONLY