


2 PLANTING LAYOUT PLAN - BUILDING ENLARGEMENT
1" = 20' - 0"

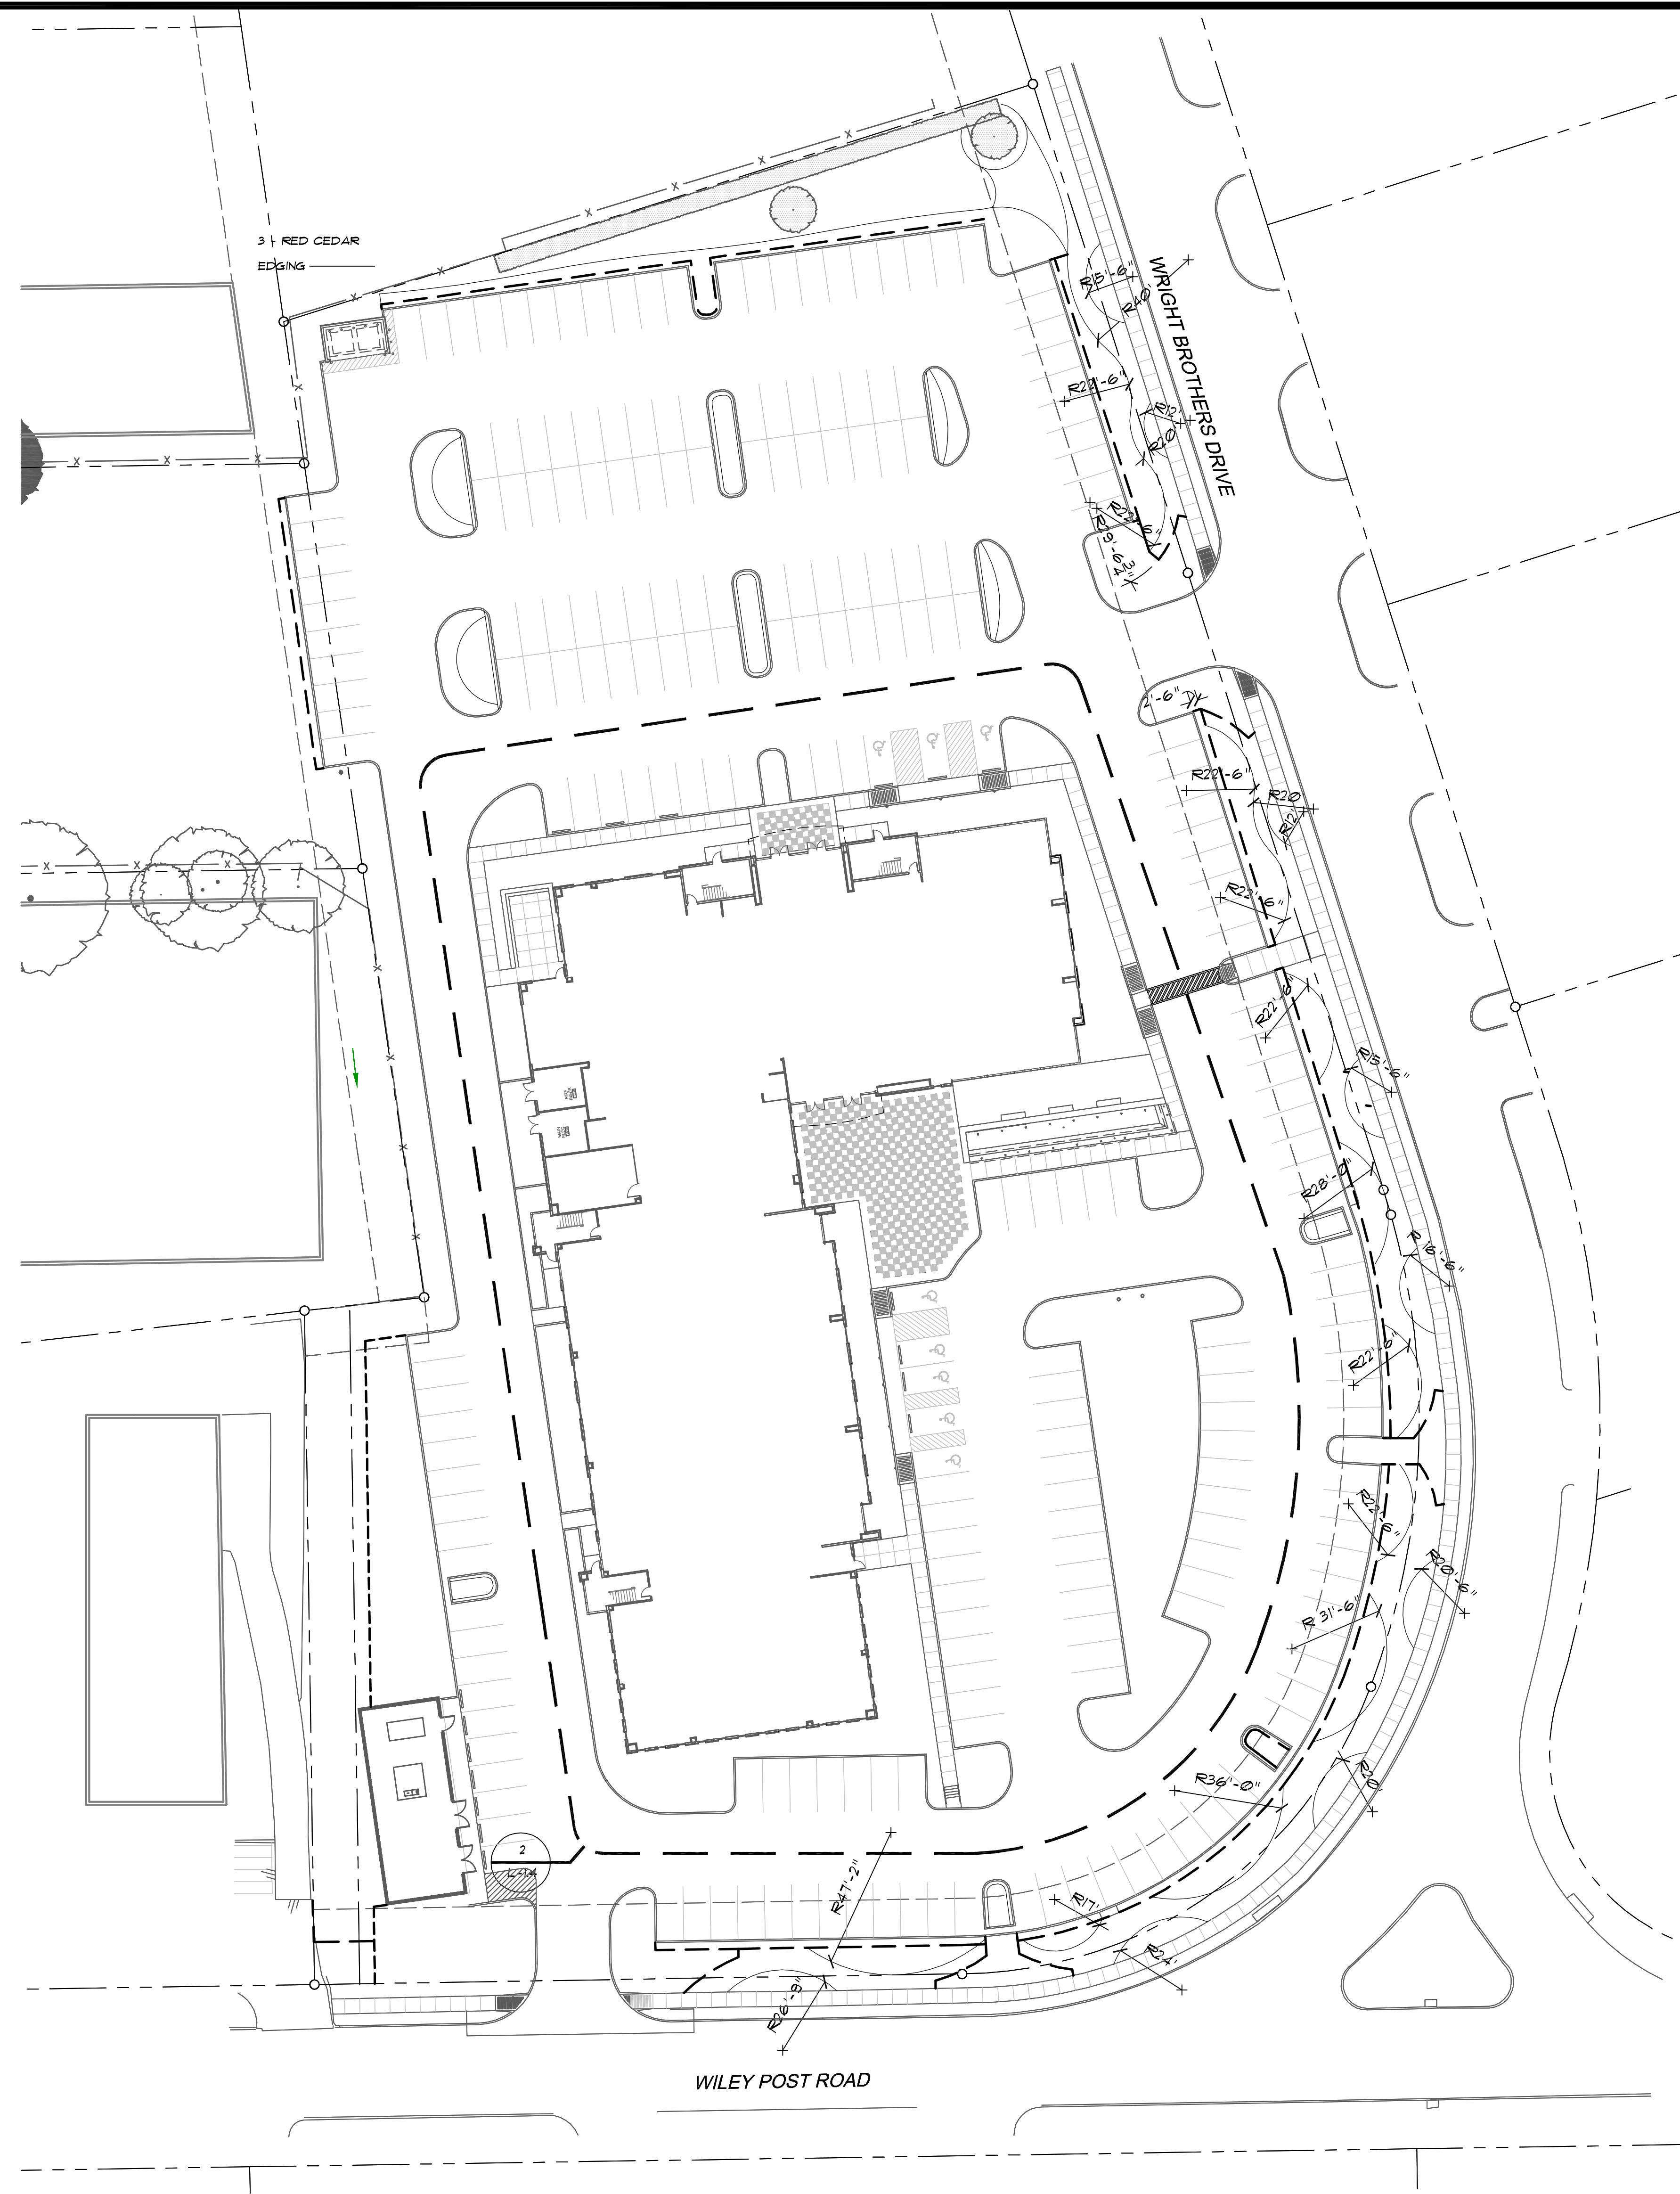

1 PLANTING LAYOUT PLAN - SITE PERIMETER
1" = 30' - 0"

PLANTING LEGEND

- PROPERTY LINE
- STEEL EDGING
- ENLARGEMENT
- 1 DETAIL NO.
- L-1.4 SHEET NO.



ADDISON, TX

HIDELL ASSOCIATES ARCHITECTS

3033 KELLWAY DRIVE, SUITE 120
CARROLLTON, TEXAS 75006 (972) 416-4666
FAX (972) 416-0169 E-MAIL thias@hidell.com



11.06.2009


OWNER
JW OPERATING COMPANY
15508 WRIGHT BROTHERS DR.
ADDISON, TX 75001
PHONE: (972) 233-4191
FAX: (972) 991-0704
ggradick@jwooperating.com

CIVIL ENGINEER
PACHECO KOCH CONSULTING ENGINEERS
8350 N CENTRAL EXPRESSWAY SUITE 1000
DALLAS, TX 75208-1612
PHONE: (972) 235-3031
FAX: (972) 235-9544

STRUCTURAL ENGINEER
R.L. GOODSON
5445 LA SIERRA, SUITE 300-LB 17
DALLAS, TX 75231
PHONE: (214) 739-8100
FAX: (214) 739-6354

MEP ENGINEER
BASHARHAH ENGINEERING
921 INDUSTRIAL BLVD. SUITE 100
DALLAS, TX 75207
PHONE: (214) 720-1005
FAX: (214) 720-1006

LANDSCAPE ARCHITECT
CAYE COOK & ASSOCIATES
12700 HILLCREST ROAD, SUITE 149
DALLAS, TX 75230
PHONE: (214) 739-9105
FAX: (214) 373-0170
barbara@cclandscapearch.com

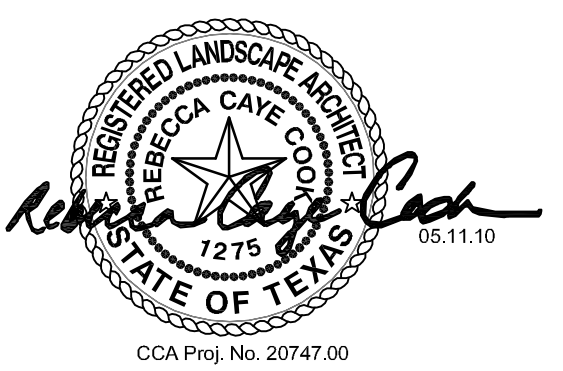

TITLE

PLANTING LAYOUT PLAN

REVISIONS

△ 05.11.2010 PLANTING MODS.

JOB NO. 26010

Issue Date: 04/23/2010

Drawn By: bb

Checked By: cc

SHEET NO.

AS-BUILTS

L-1.4

ISSUE FOR REVIEW ONLY