

B19-8

TNP PROJECT NUMBER: ADD 01333


TOWN OF ADDISON, TEXAS

CONSTRUCTION PLANS FOR

WRIGHT BROTHERS / WILEY POST

WATER LINE REPLACEMENT

ADDISON, TEXAS

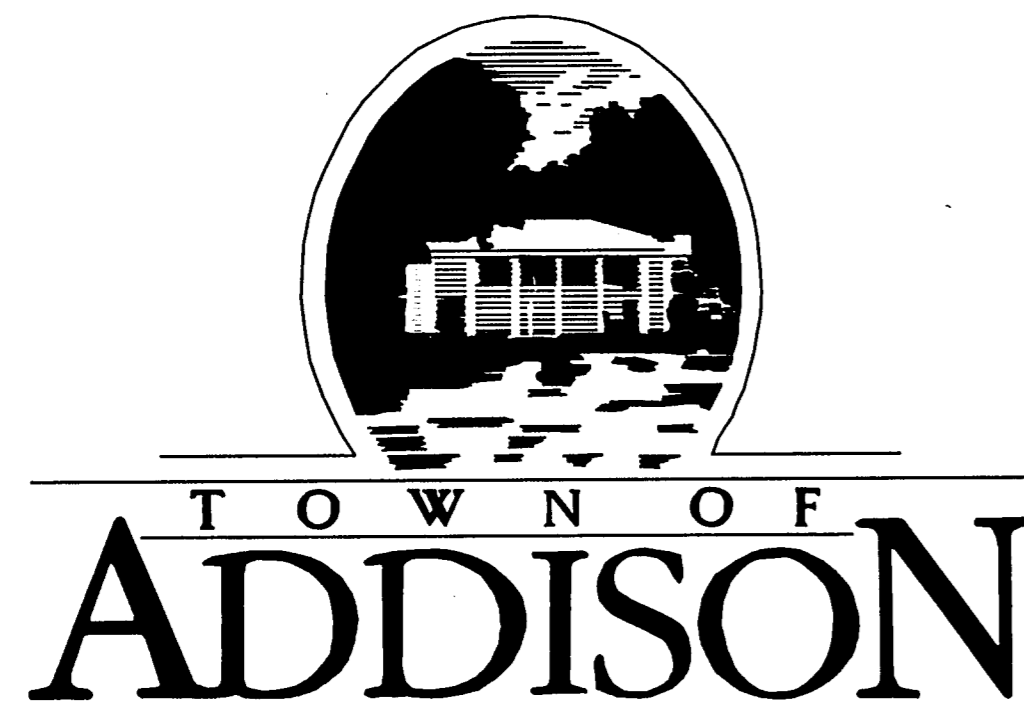

MAYOR

R. SCOTT WHEELER

MAYOR PRO-TEM

CATHY WAYS

DEPUTY MAYOR PRO-TEM

BOB BARRETT

COUNCIL MEMBERS


DIANE MALLORY
 GLYNDA TURNER
 JOE CHOW
 FREDERICK M. SILVER

CITY MANAGER

RON WHITEHEAD

PUBLIC WORKS DIRECTOR

MICHAEL MURPHY, P.E.

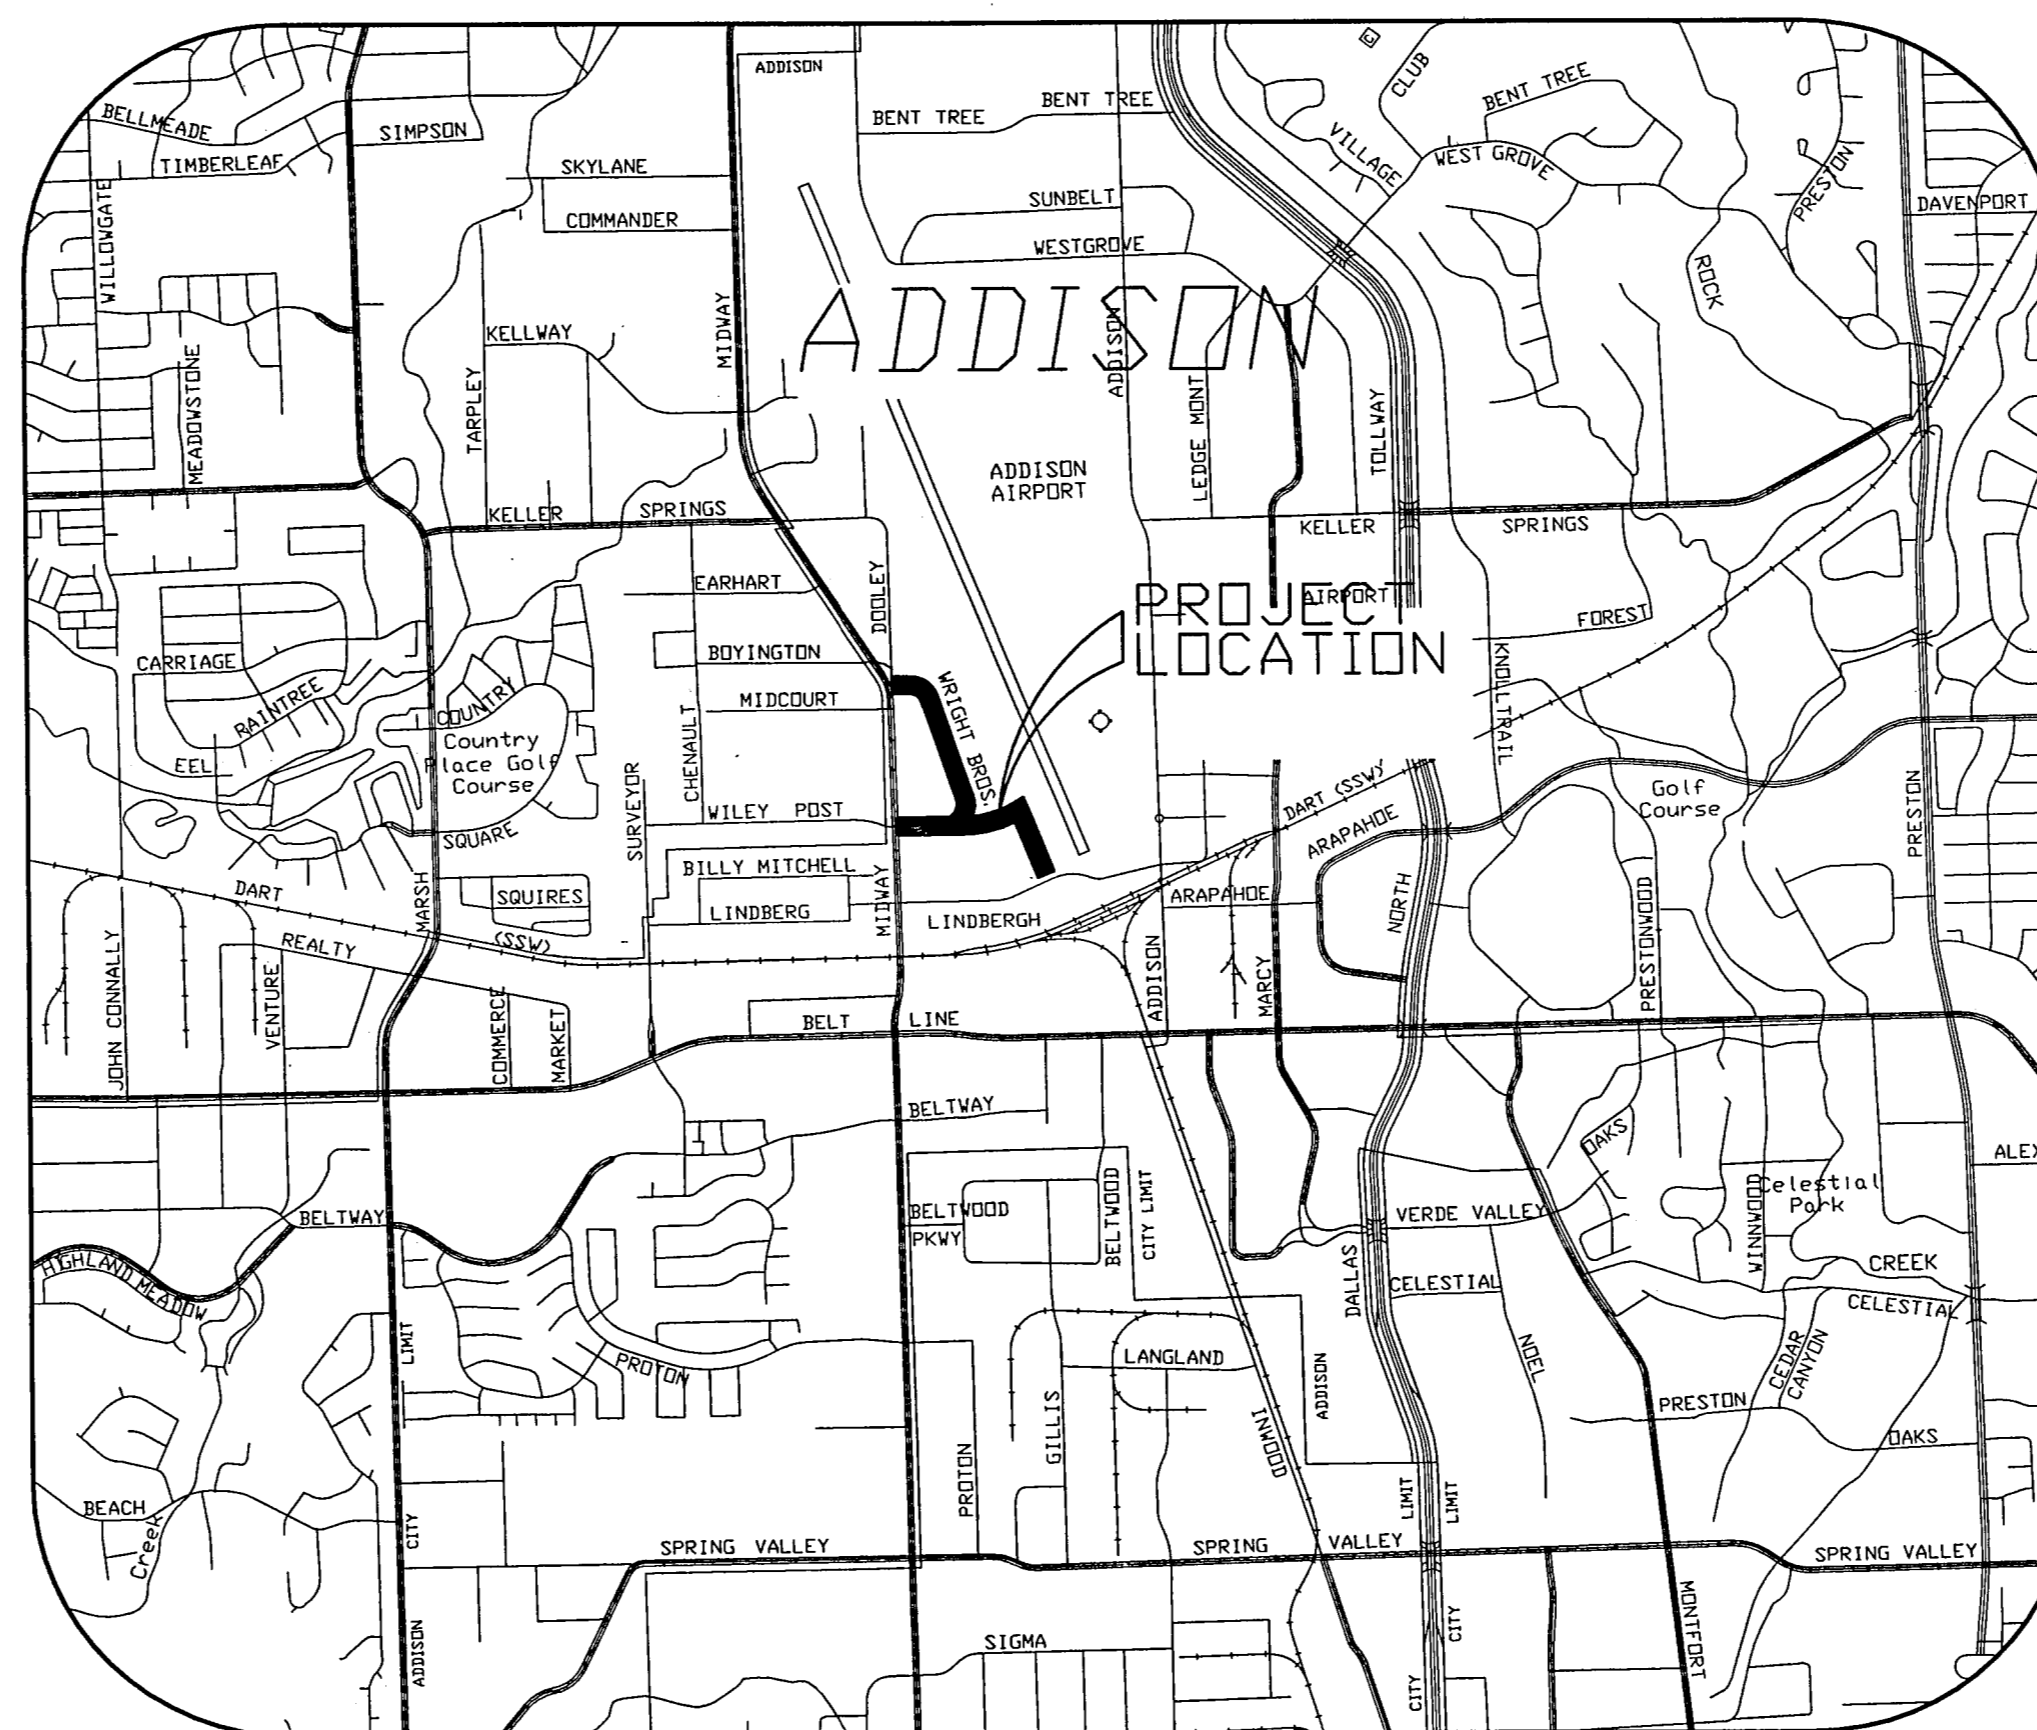

LOCATION MAP

JULY 2002




TEAGUE NALL AND PERKINS
 CONSULTING ENGINEERS

SHEET INDEX

SHEET NO.	DESCRIPTION
1	COVER SHEET
2	GENERAL NOTES & LEGEND
3	WATER LINE PLAN - WRIGHT BROTHERS STA. 0+00.00 TO STA. 5+00.00
4	WATER LINE PLAN - WRIGHT BROTHERS STA. 5+00.00 TO STA. 10+00.00
5	WATER LINE PLAN - WRIGHT BROTHERS STA. 10+00.00 TO STA. 15+00.00
6	WATER LINE PLAN - WRIGHT BROTHERS STA. 15+00.00 TO STA. 17+33.34
7	WATER LINE PLAN - WILEY POST STA. 0+00.00 TO STA. 5+00.00
8	WATER LINE PLAN - WILEY POST STA. 5+00.00 TO STA. 10+00.00
9	WATER LINE PLAN - WILEY POST STA. 10+00.00 TO STA. 15+00.00
10	WATER LINE PLAN - WILEY POST STA. 15+00.00 TO STA. 18+84.98
11	MISCELLANEOUS DETAILS 1
12	MISCELLANEOUS DETAILS 2

Const. mark-up

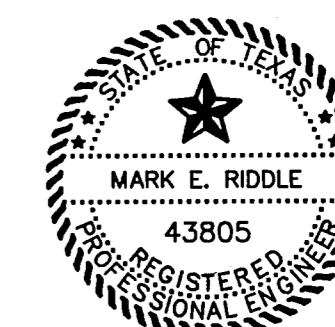

Mark E. Riddle
 MARK E. RIDDLE, P.E.

DATE: 07.10.02

B19-8

TNP PROJECT NO.: ADD 01333

Const. mark-up
WILEY POST WATER LINE REPLACEMENT

Q:\LDV\ADD01333\dwg\sheet\COVER.DWG, 07/11/2002 05:21:16 PM, HP 1050C.pcl