

TOWN OF ADDISON

District ^{size} 8" Zone Mug Number 32 Map Page 25

Location in Addison rd Right lane


10.6" East of curb directly west of meter to 1st woods

Type of Valve gate

Depth Surface to Valve 5'-8" TURNS

Surface Cover Asphalt

Remarks: This is one of two valves to hydrant # 15, also this valve will shut off meter to 1st Woods, 154221 - Restaurant

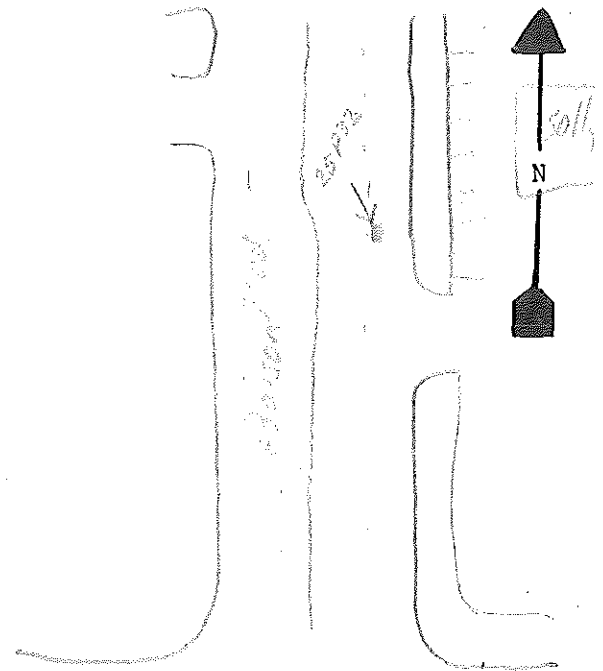

Belt line

TOWN OF ADDISON

District _____ Zone M Number 21 Map Page 25

Location 13' SW from corner of parking area and 2' W from curb

Type of Valve 24" Butterfly

Depth Surface to Valve 6'-8" Type Wrench Short

Surface Cover Asphalt

Remarks: _____

