


KELLER SPRINGS ROAD

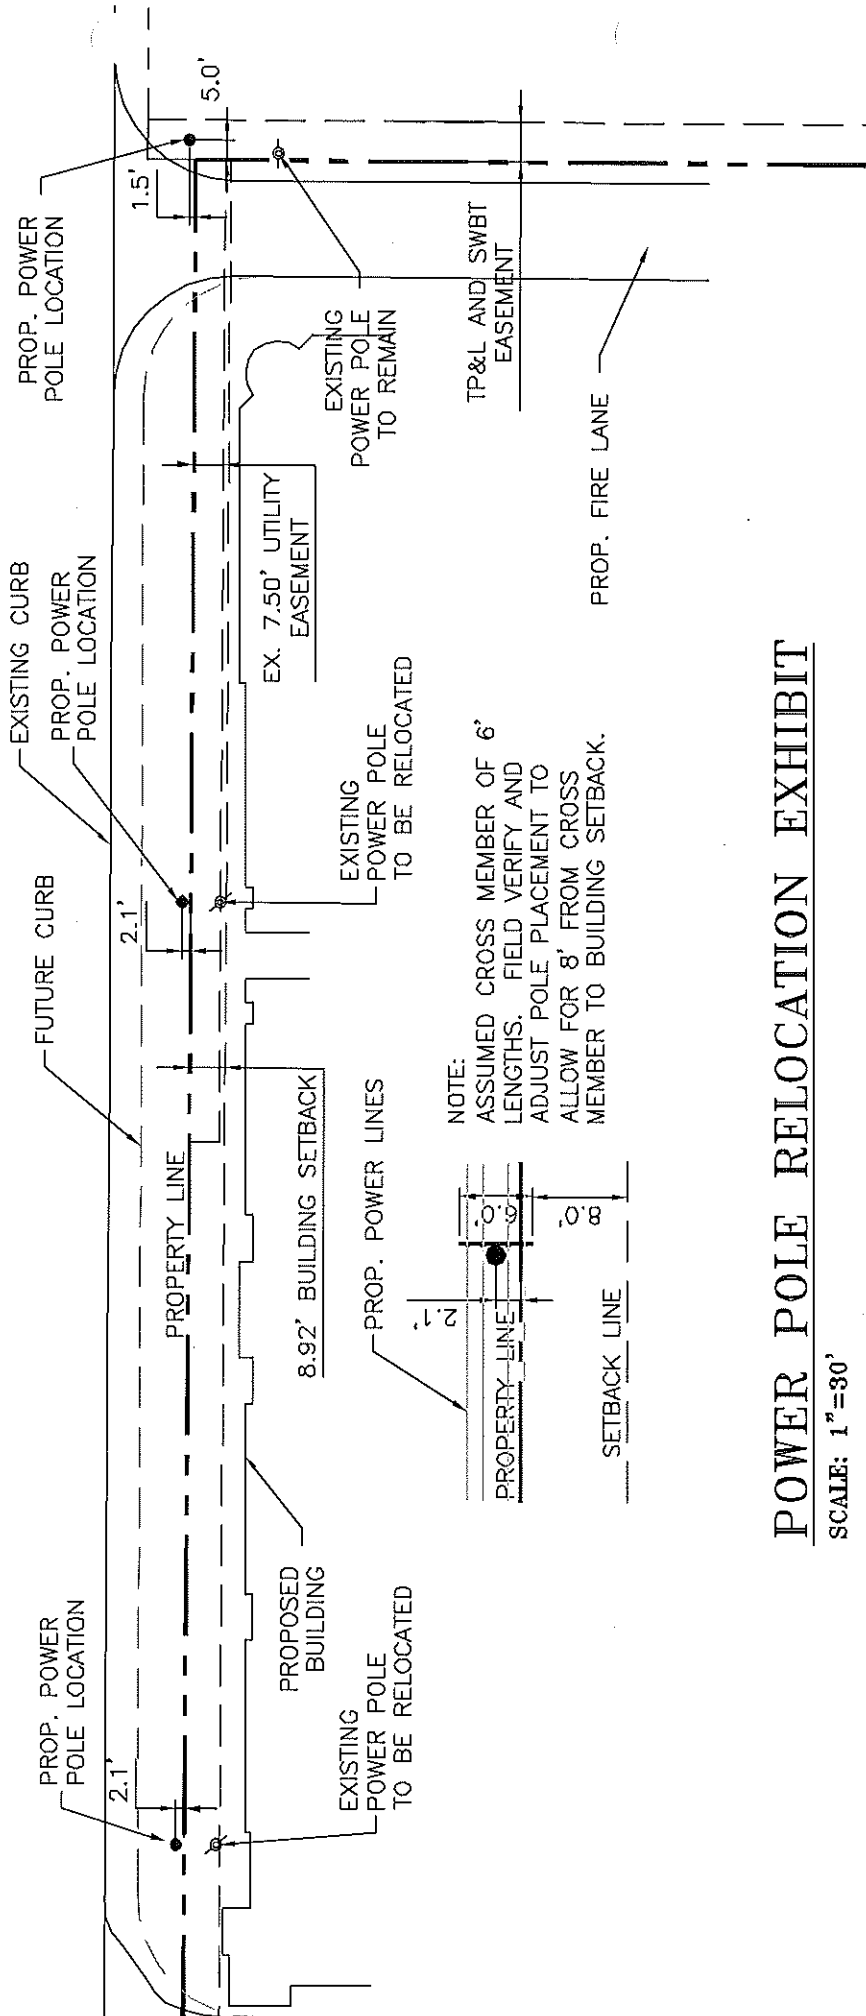

POWER POLE RELOCATION EXHIBIT

SCALE: 1"=30'

2006-01