



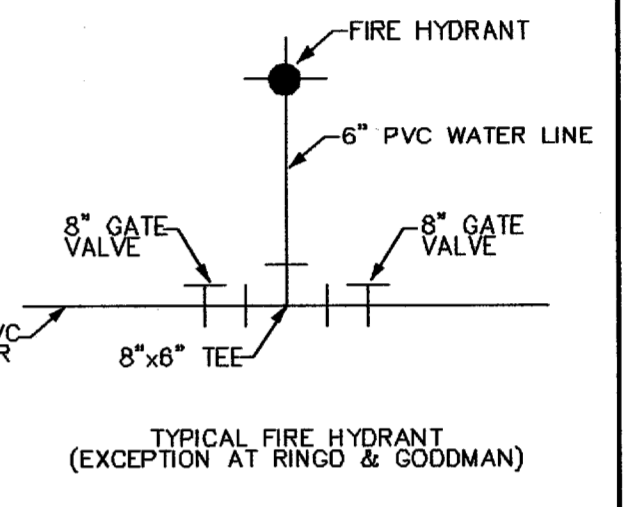

SCALE IN FEET  
SCALE: 1"=40'

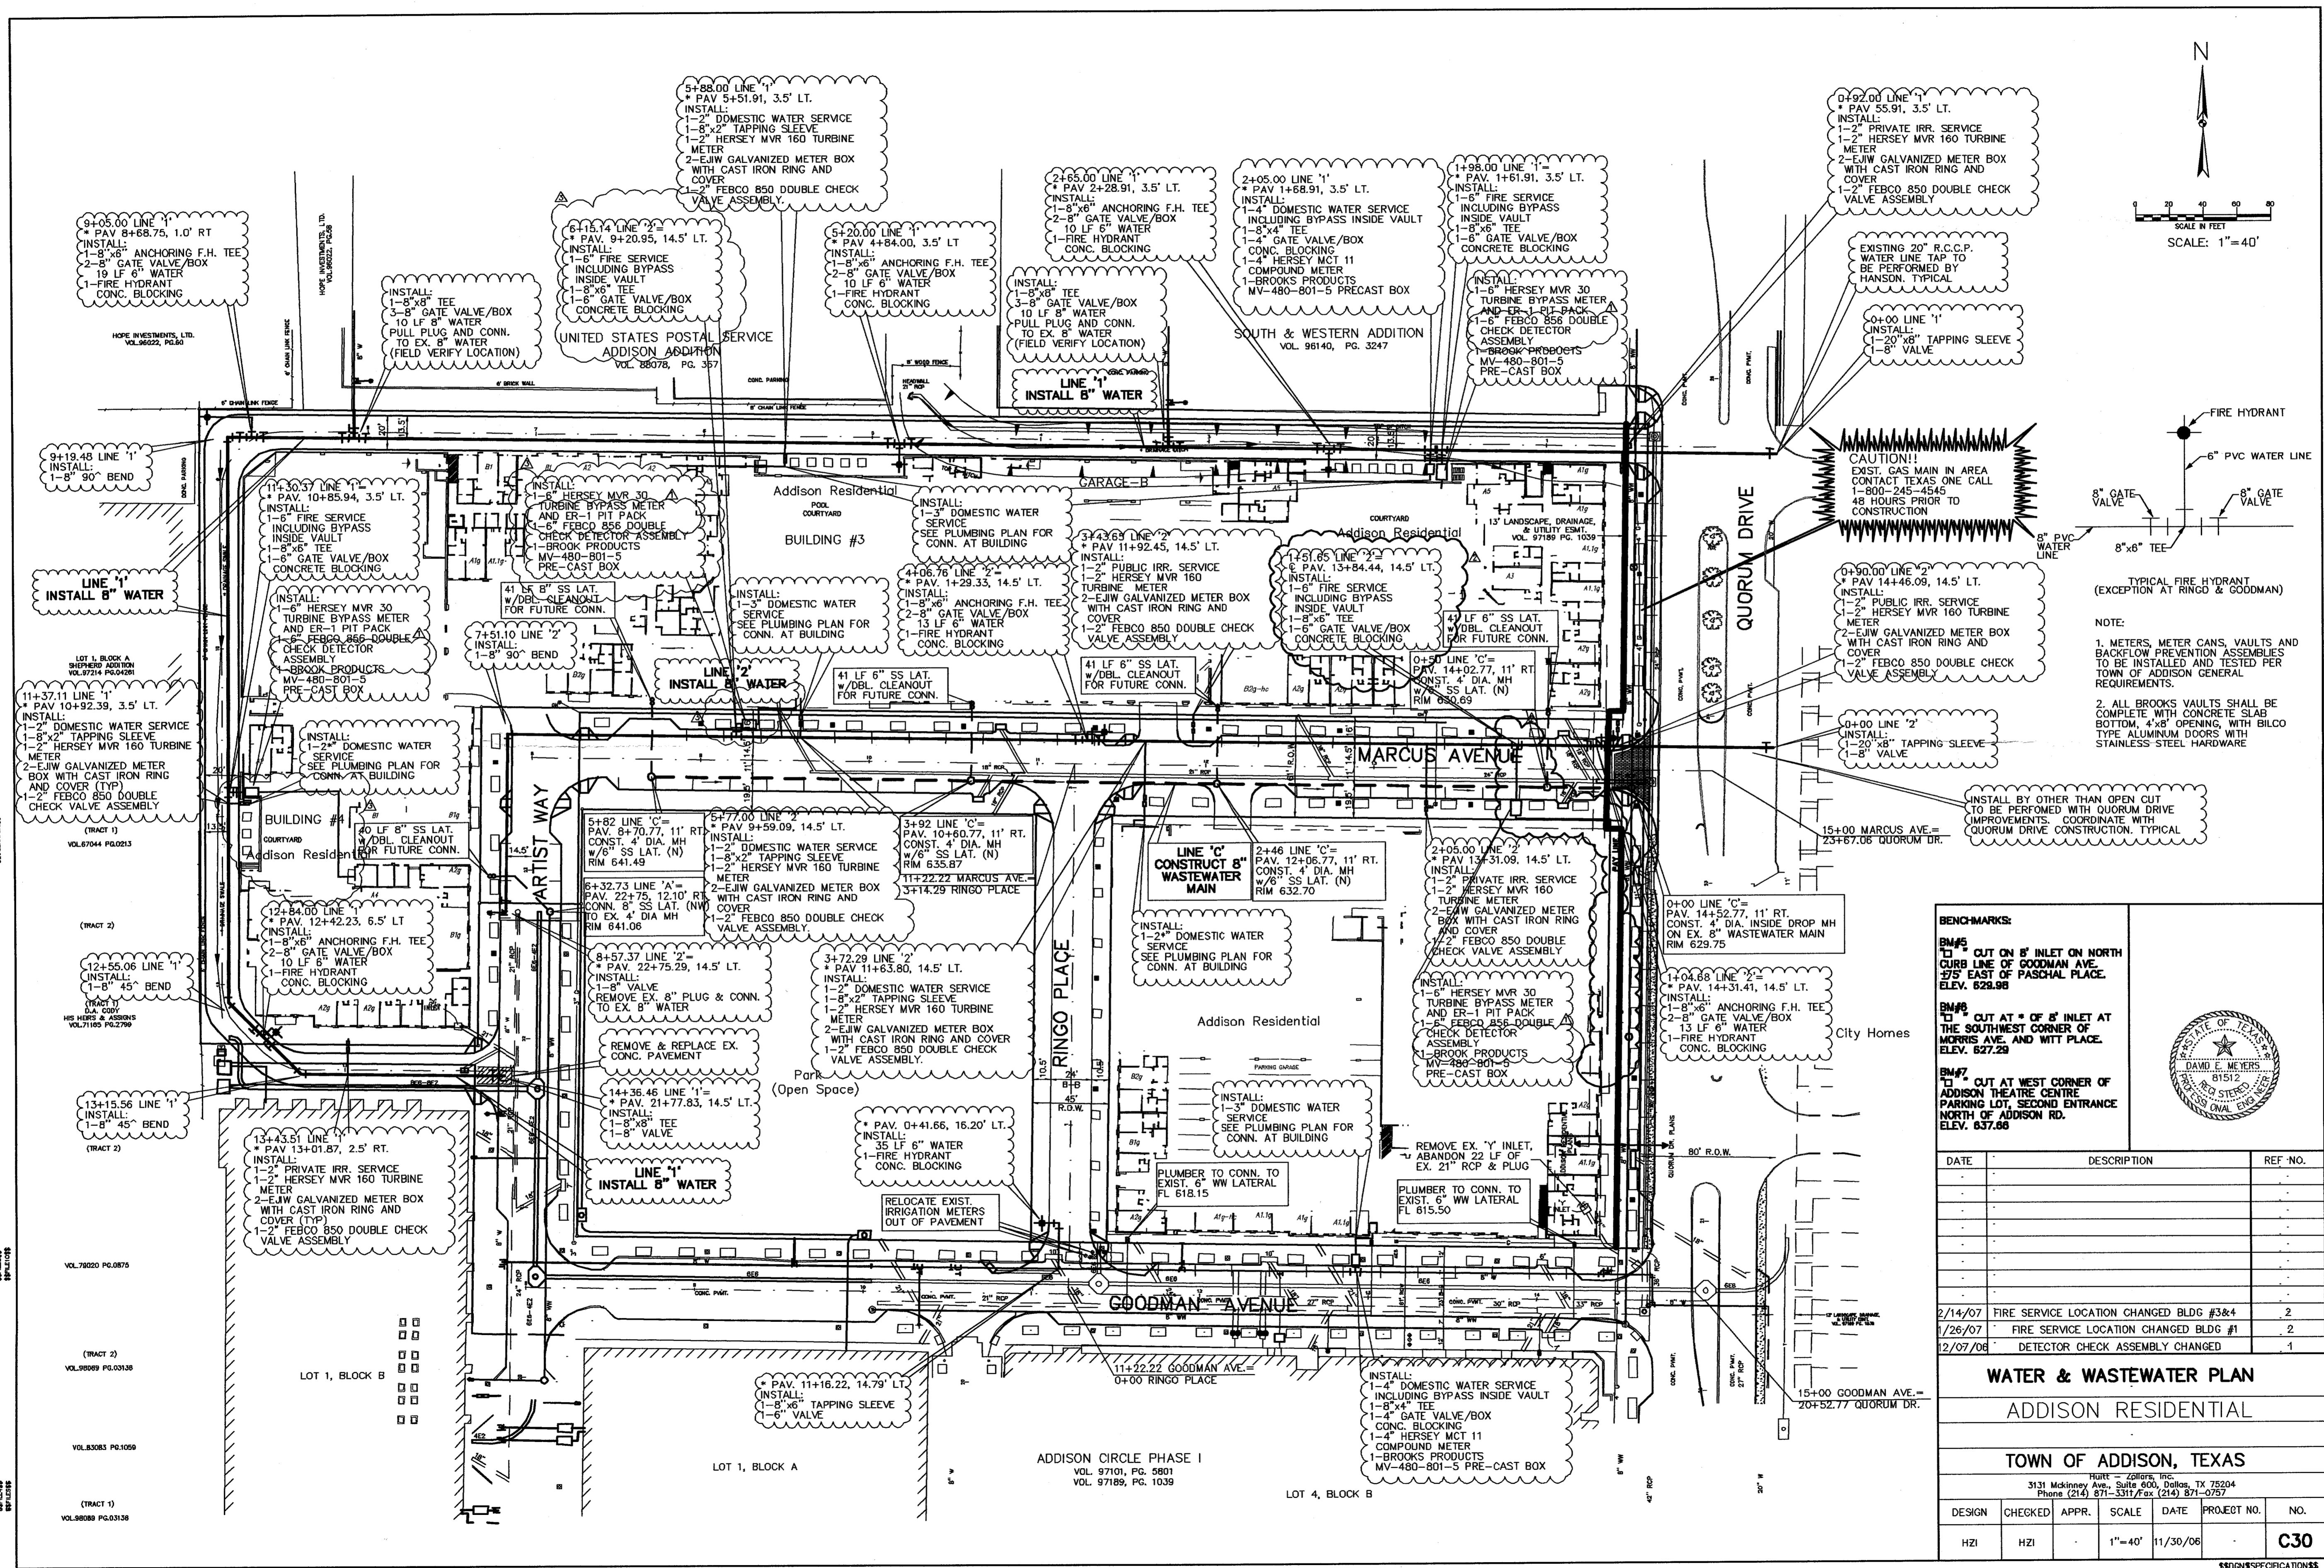

NOTE:  
1. METERS, METER CANS, VAULTS AND BACKFLOW PREVENTION ASSEMBLIES TO BE INSTALLED AND TESTED PER TOWN OF ADDISON GENERAL REQUIREMENTS.  
2. ALL BROOKS VAULTS SHALL BE COMPLETE WITH CONCRETE SLAB BOTTOM, 4x8" OPENING WITH BILCO TYPE ALUMINUM DOORS WITH STAINLESS STEEL HARDWARE

**BENCHMARKS:**  
BM#5  
"1" OUT ON 8" INLET ON NORTH CURB LINE OF GOODMAN AVE. 75' EAST OF PASCAL PLACE. ELEV. 629.98  
BM#6  
"1" OUT AT \* OF 8" INLET AT THE SOUTHWEST CORNER OF MORRIS AVE. AND WITT PLACE. ELEV. 627.29  
BM#7  
"1" OUT AT WEST CORNER OF ADDISON THEATRE CENTRE PARKING LOT, SECOND ENTRANCE NORTH OF ADDISON RD. ELEV. 637.68



DATE	DESCRIPTION	REF. NO.
2/14/07	FIRE SERVICE LOCATION CHANGED BLDG #3&4	2
1/26/07	FIRE SERVICE LOCATION CHANGED BLDG #1	2
2/07/06	DETECTOR CHECK ASSEMBLY CHANGED	1

**WATER & WASTEWATER PLAN**  
**ADDISON RESIDENTIAL**  
**TOWN OF ADDISON, TEXAS**  
HURT & ZIGLIDIS, INC.  
3131 McKinney Ave., Suite 600, Dallas, TX 75204  
Phone (214) 871-3311 Fax (214) 871-0757

DESIGN	CHECKED	APPR.	SCALE	DATE	PROJECT NO.	NO.
H21	H21		1"=40'	11/30/06		<b>C30</b>

\$\$\$DN\$SPECIFICATIONS