

REMOVE BRICK PAVERS AND REPLACE WITH 6" 4200 p.s.i. REINFORCED CONCRETE PAVEMENT. SEE TYPICAL PAVING SECTION ON SHEET C5


ROLL DOWN CURB @ BFR
13+91.07 MATCH EX. CURB TC 640.30

ARTIST WAY

SAWCUT FULL DEPTH BREAKOUT & REMOVE EX. CONCRETE CURB & GUTTER

ROLL DOWN CURB @ BFR

13+91.07 MATCH EX. CURB TC 639.60

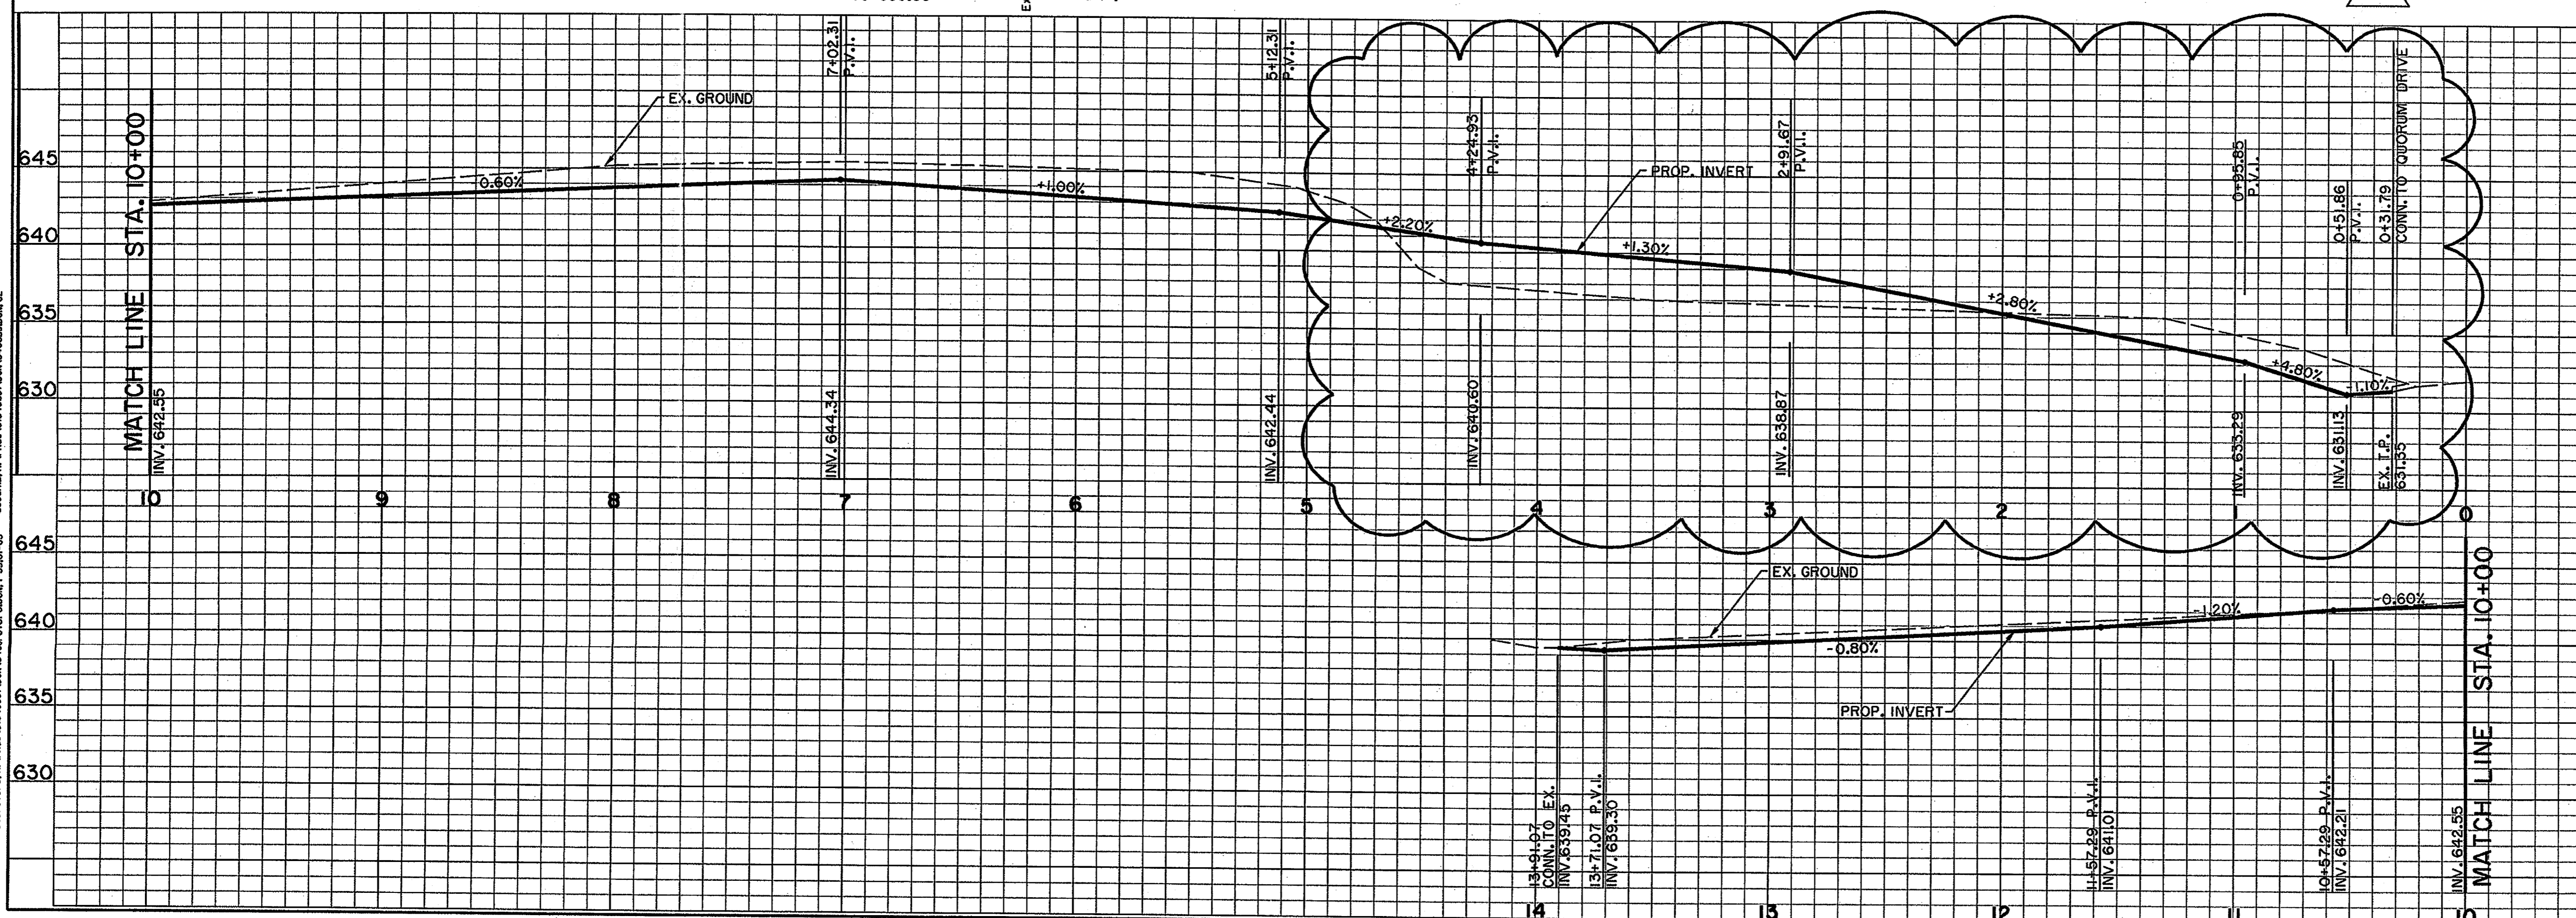

BENCHMARKS:

BM#5
"I" CUT ON 8" INLET ON NORTH CURB LINE OF GOODMAN AVE. ±75' EAST OF PASCHAL PLACE. ELEV. 629.98

BM#6
"I" CUT AT C OF 8" INLET AT THE SOUTHWEST CORNER OF MORRIS AVE. AND WITT PLACE. ELEV. 627.29

BM#7
"I" CUT AT WEST CORNER OF ADDISON THEATRE CENTRE PARKING LOT, SECOND ENTRANCE NORTH OF ADDISON RD. ELEV. 637.66



DATE	DESCRIPTION	REF NO.
10/10/07	REVISED HC RAMPS AT FIRELANE	▲
9/13/07	REVISED FIRELANE GRADING	▲

PAVING PLAN & PROFILE
20' FIRE LANE
ADDISON RESIDENTIAL

TOWN OF ADDISON, TEXAS

Null - 2011ers inc.
3131 McKinney Ave, Suite 600, Dallas, TX 75204
Phone (214) 871-3311 / Fax (214) 871-0757

DESIGN	CHECKED	APPR.	SCALE	DATE	PROJECT NO.	NO.
HZ1	HZ1		H _v 1"=40' V _v 1"=6'	9/13/07		C12

PLS SEE: H:\PROJ\01340801\DWG\3629P\05.DWG
 REF: H:\PROJ\01340801\DWG\3629P\05.DWG
 SCALE: 1"=40'
 DATE: 9/13/07
 PROJECT NO.:
 NO.: