


(15502) BLOCK B LOT 13 / 1.076 ACS
 PROTECH COLLISION CENTER

ZONNING I-1

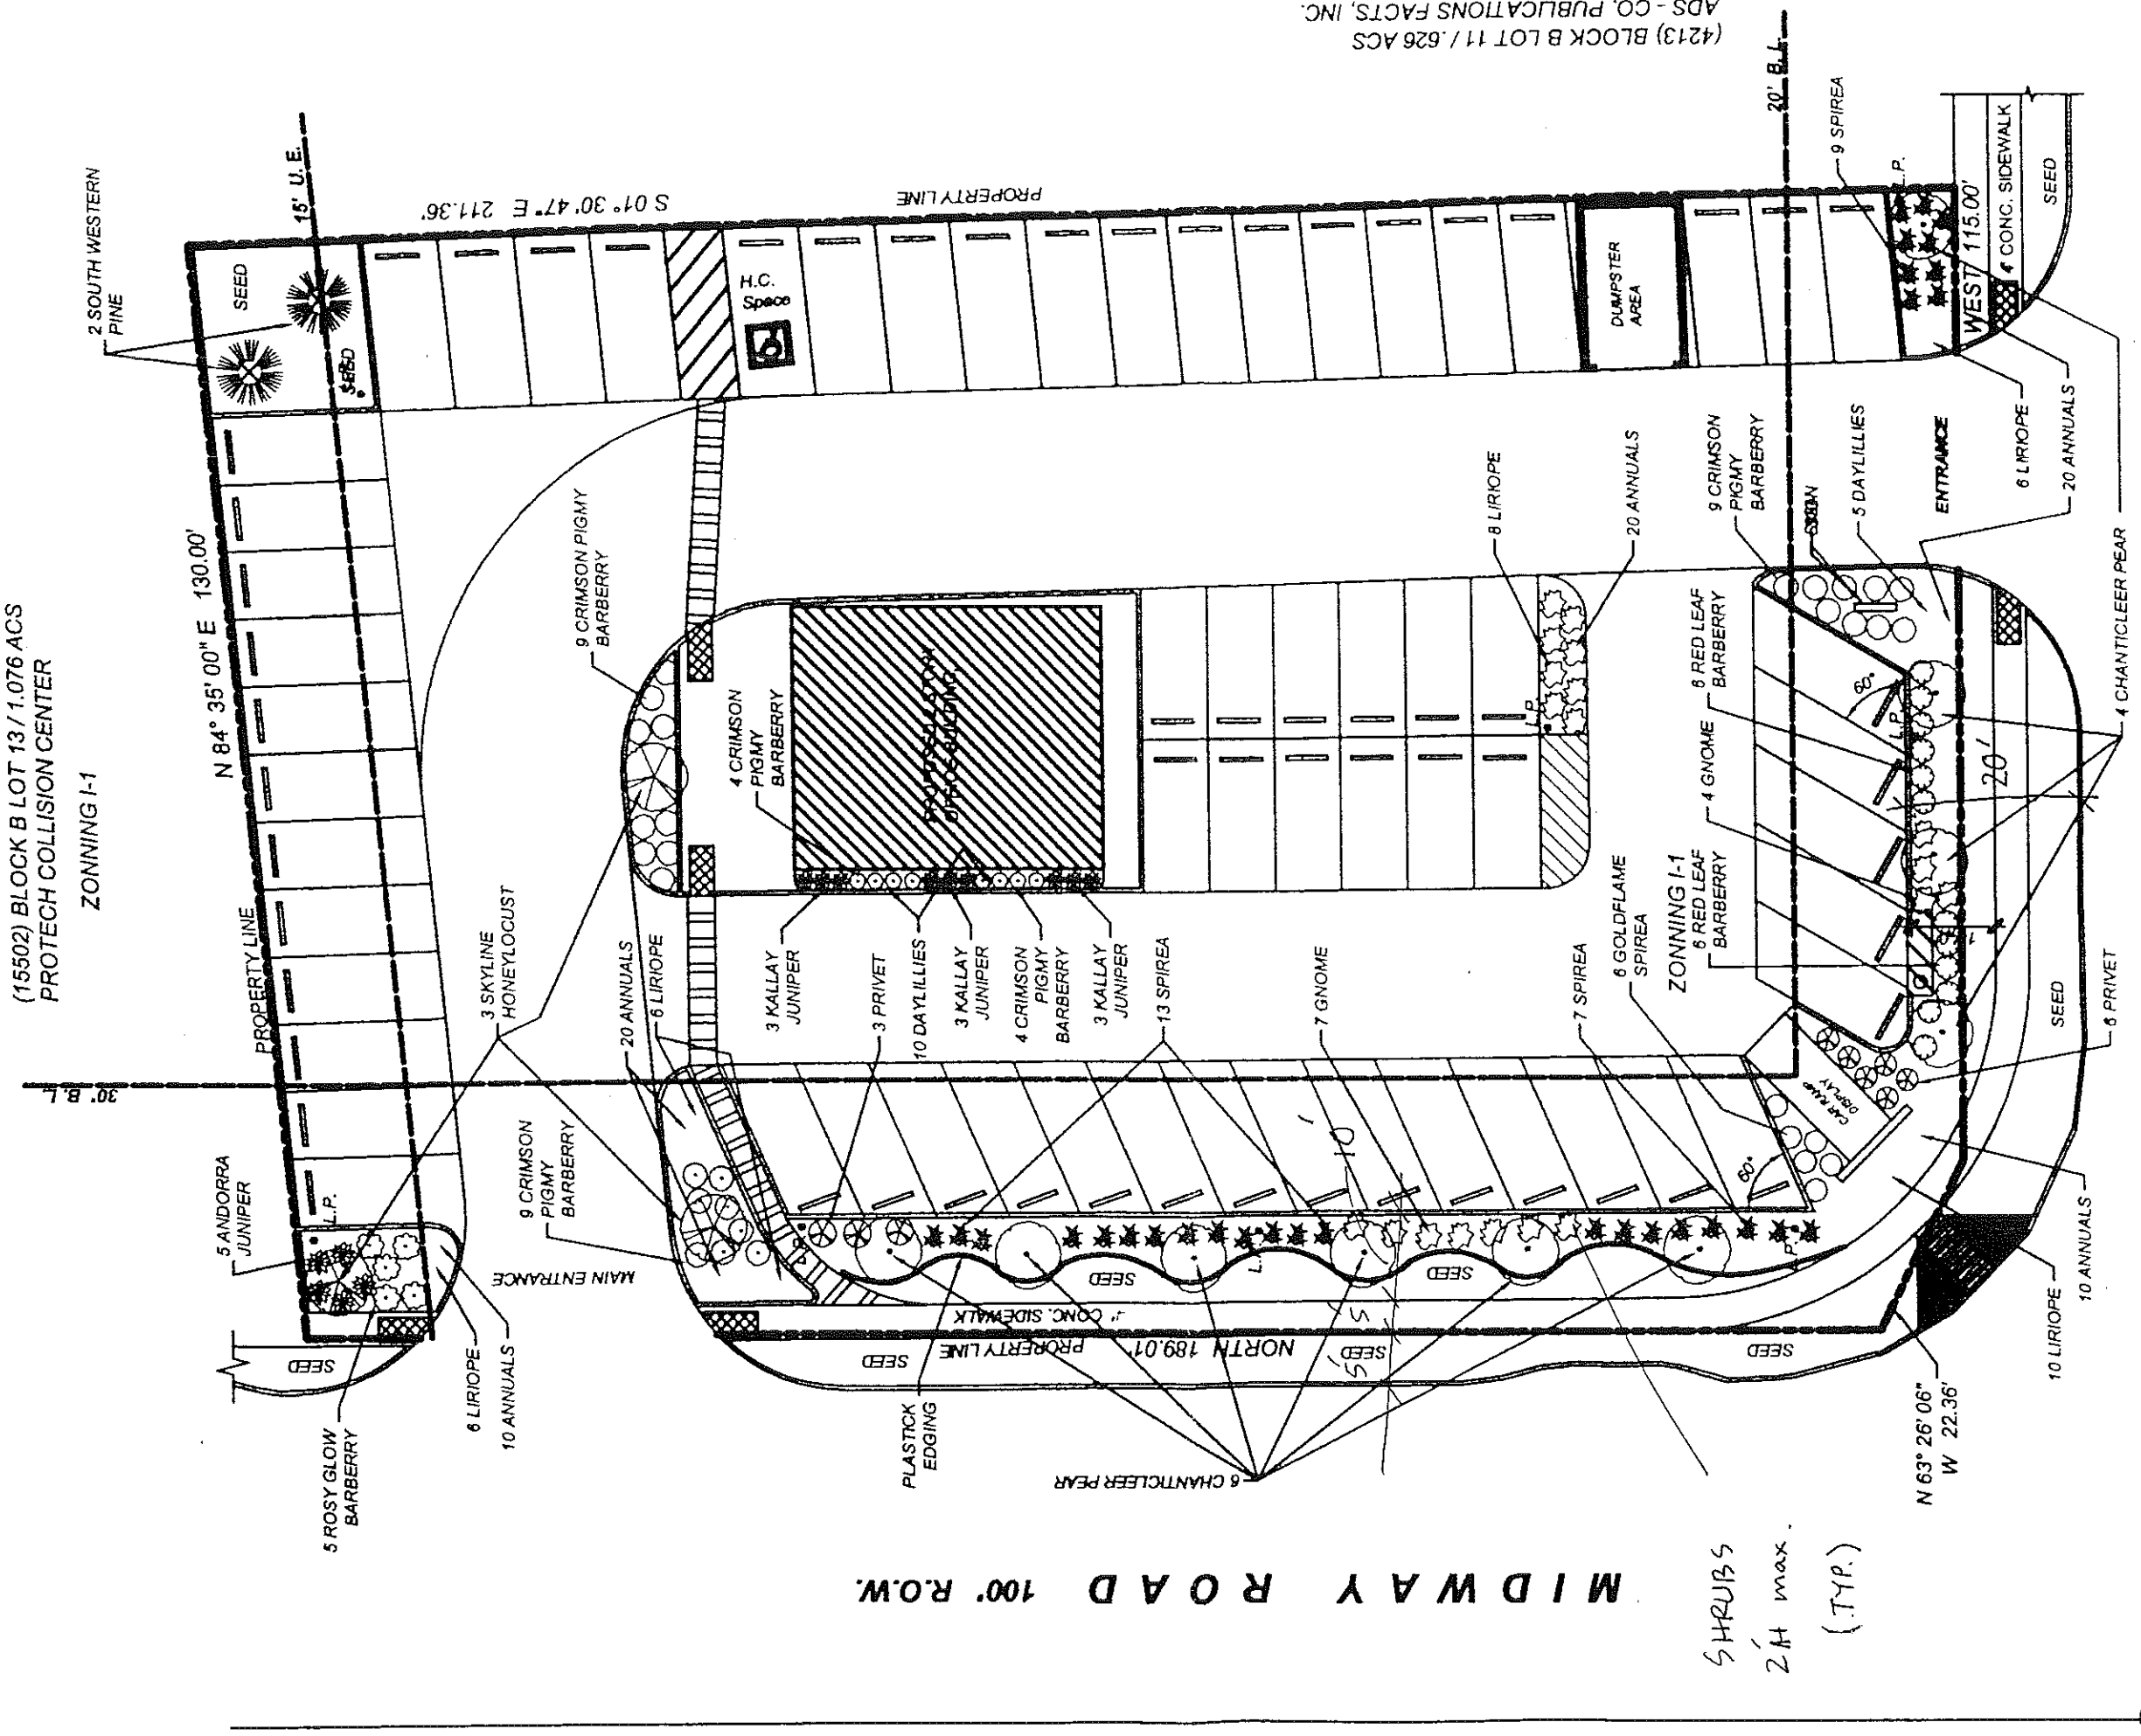

MIDWAY ROAD 100' R.O.W.

SHRUBS
 2 1/4 max.
 (TYP.)

WILEY POST 60' R.O.W.

(15402) BLOCK C LOT 8 / 1.436 ACS
 I - XPEDX PAPER & GRAPHICS
 ZONNING I-1

(4213) BLOCK B LOT 11 / .626 ACS
 ADS - CO. PUBLICATIONS FACTS, INC.