


LOCATION MAP  
N.T.S.

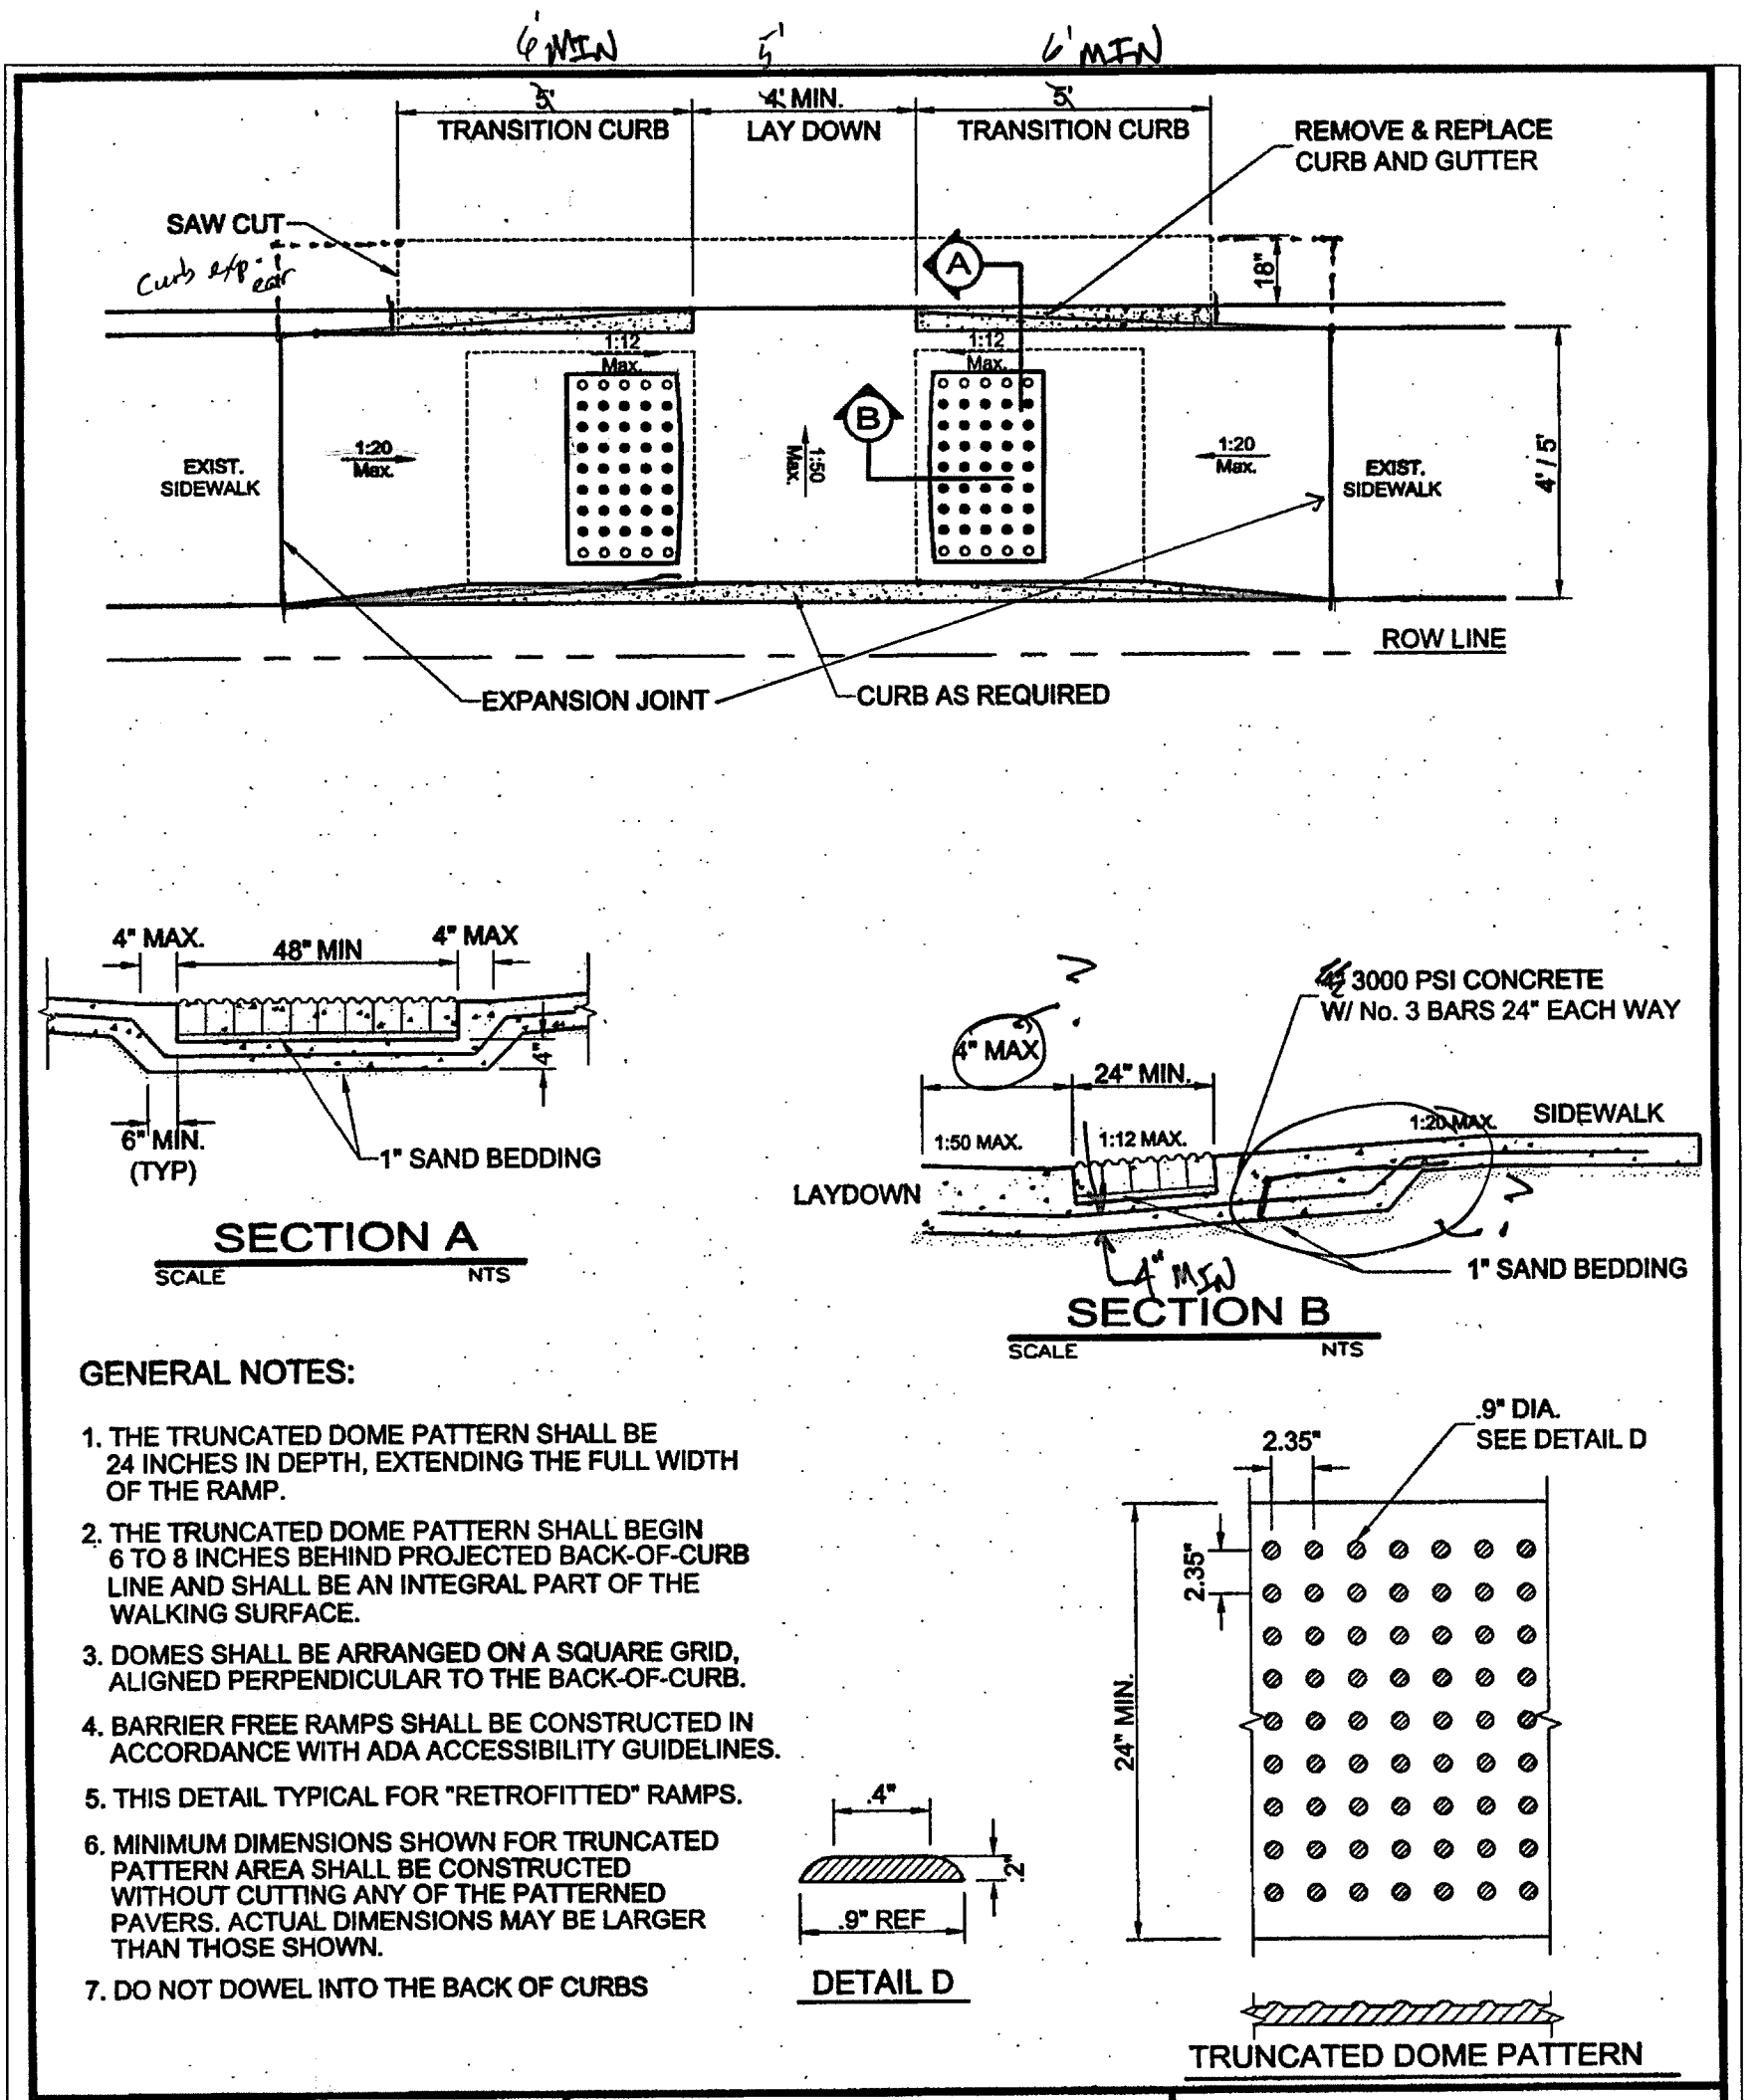

GENERAL NOTES

1. A 10-FOOT WIDE CROSSWALK, MARKED WITH HIGH CONSPICUITY REFLECTIVE MARKINGS IN A LADDER CONFIGURATION CONSISTING OF 24" SOLID STRIPE, 24" GAP, 24" SOLID STRIPE. *show on plan*
2. AN S1-1 CROSSWALK WARNING SIGN WITH A W16-7PR PLAQUE IS TO BE PLACED AT LEAST 2 FEET OFF THE CURB IMMEDIATELY ADJACENT TO THE CROSSWALK. *show on plan*

RECEIVED

*cmOut*

REVISIONS	DATE

**NDM** NATHAN D. MAIER  
 CONSULTING ENGINEERS, INC.  
WWW.NDMCE.COM

Two Northpark 8080 Park Lane Suite 600  
 Dallas, Texas 75231 214.739.4741

**SIDEWALK CONSTRUCTION PLAN**  
 TRINITY CHRISTIAN ACADEMY  
 CITY OF ADDISON, DALLAS COUNTY, TEXAS

DESIGN	DRAWN	SCALE	DATE	NOTES	JOB NUMBER
NDMCE	NDMCE	1" = 30'	SEP. 05, 2007	07074.A-PL01	07-08-074

SHEET NO. 1 / 1

9-5-07

2006-13