



10-2002

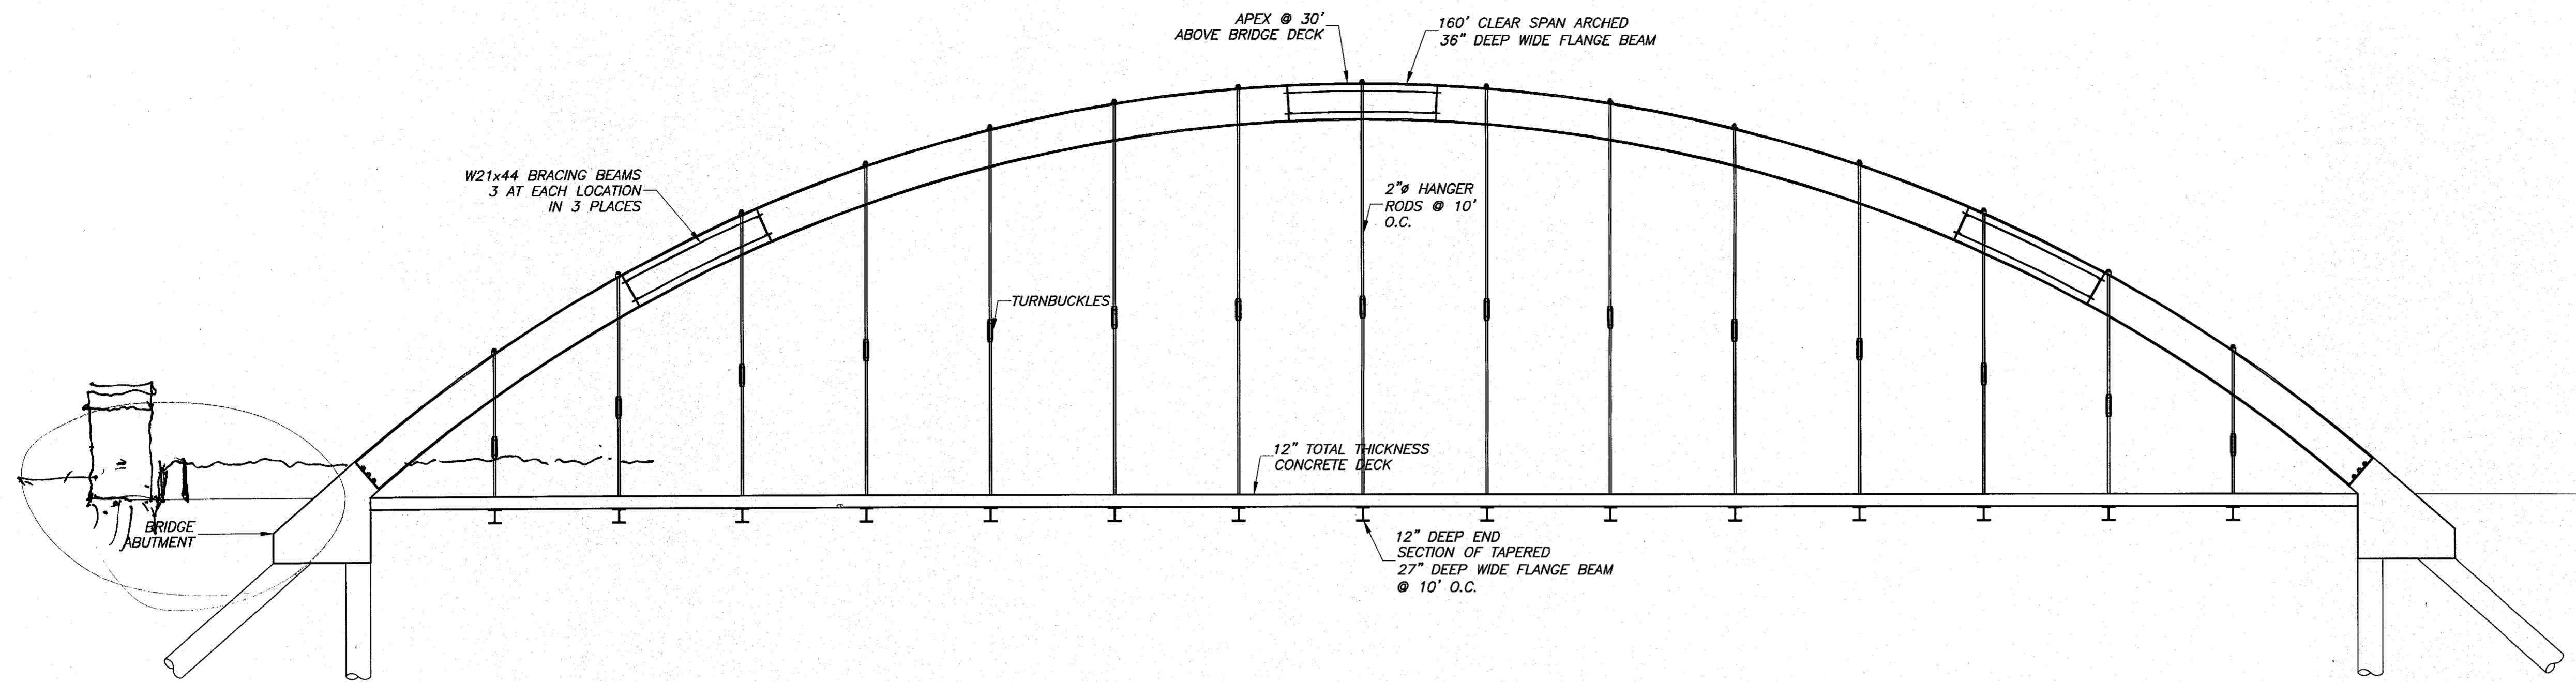

01 ELEVATION VIEW
1/8" = 1'-0"

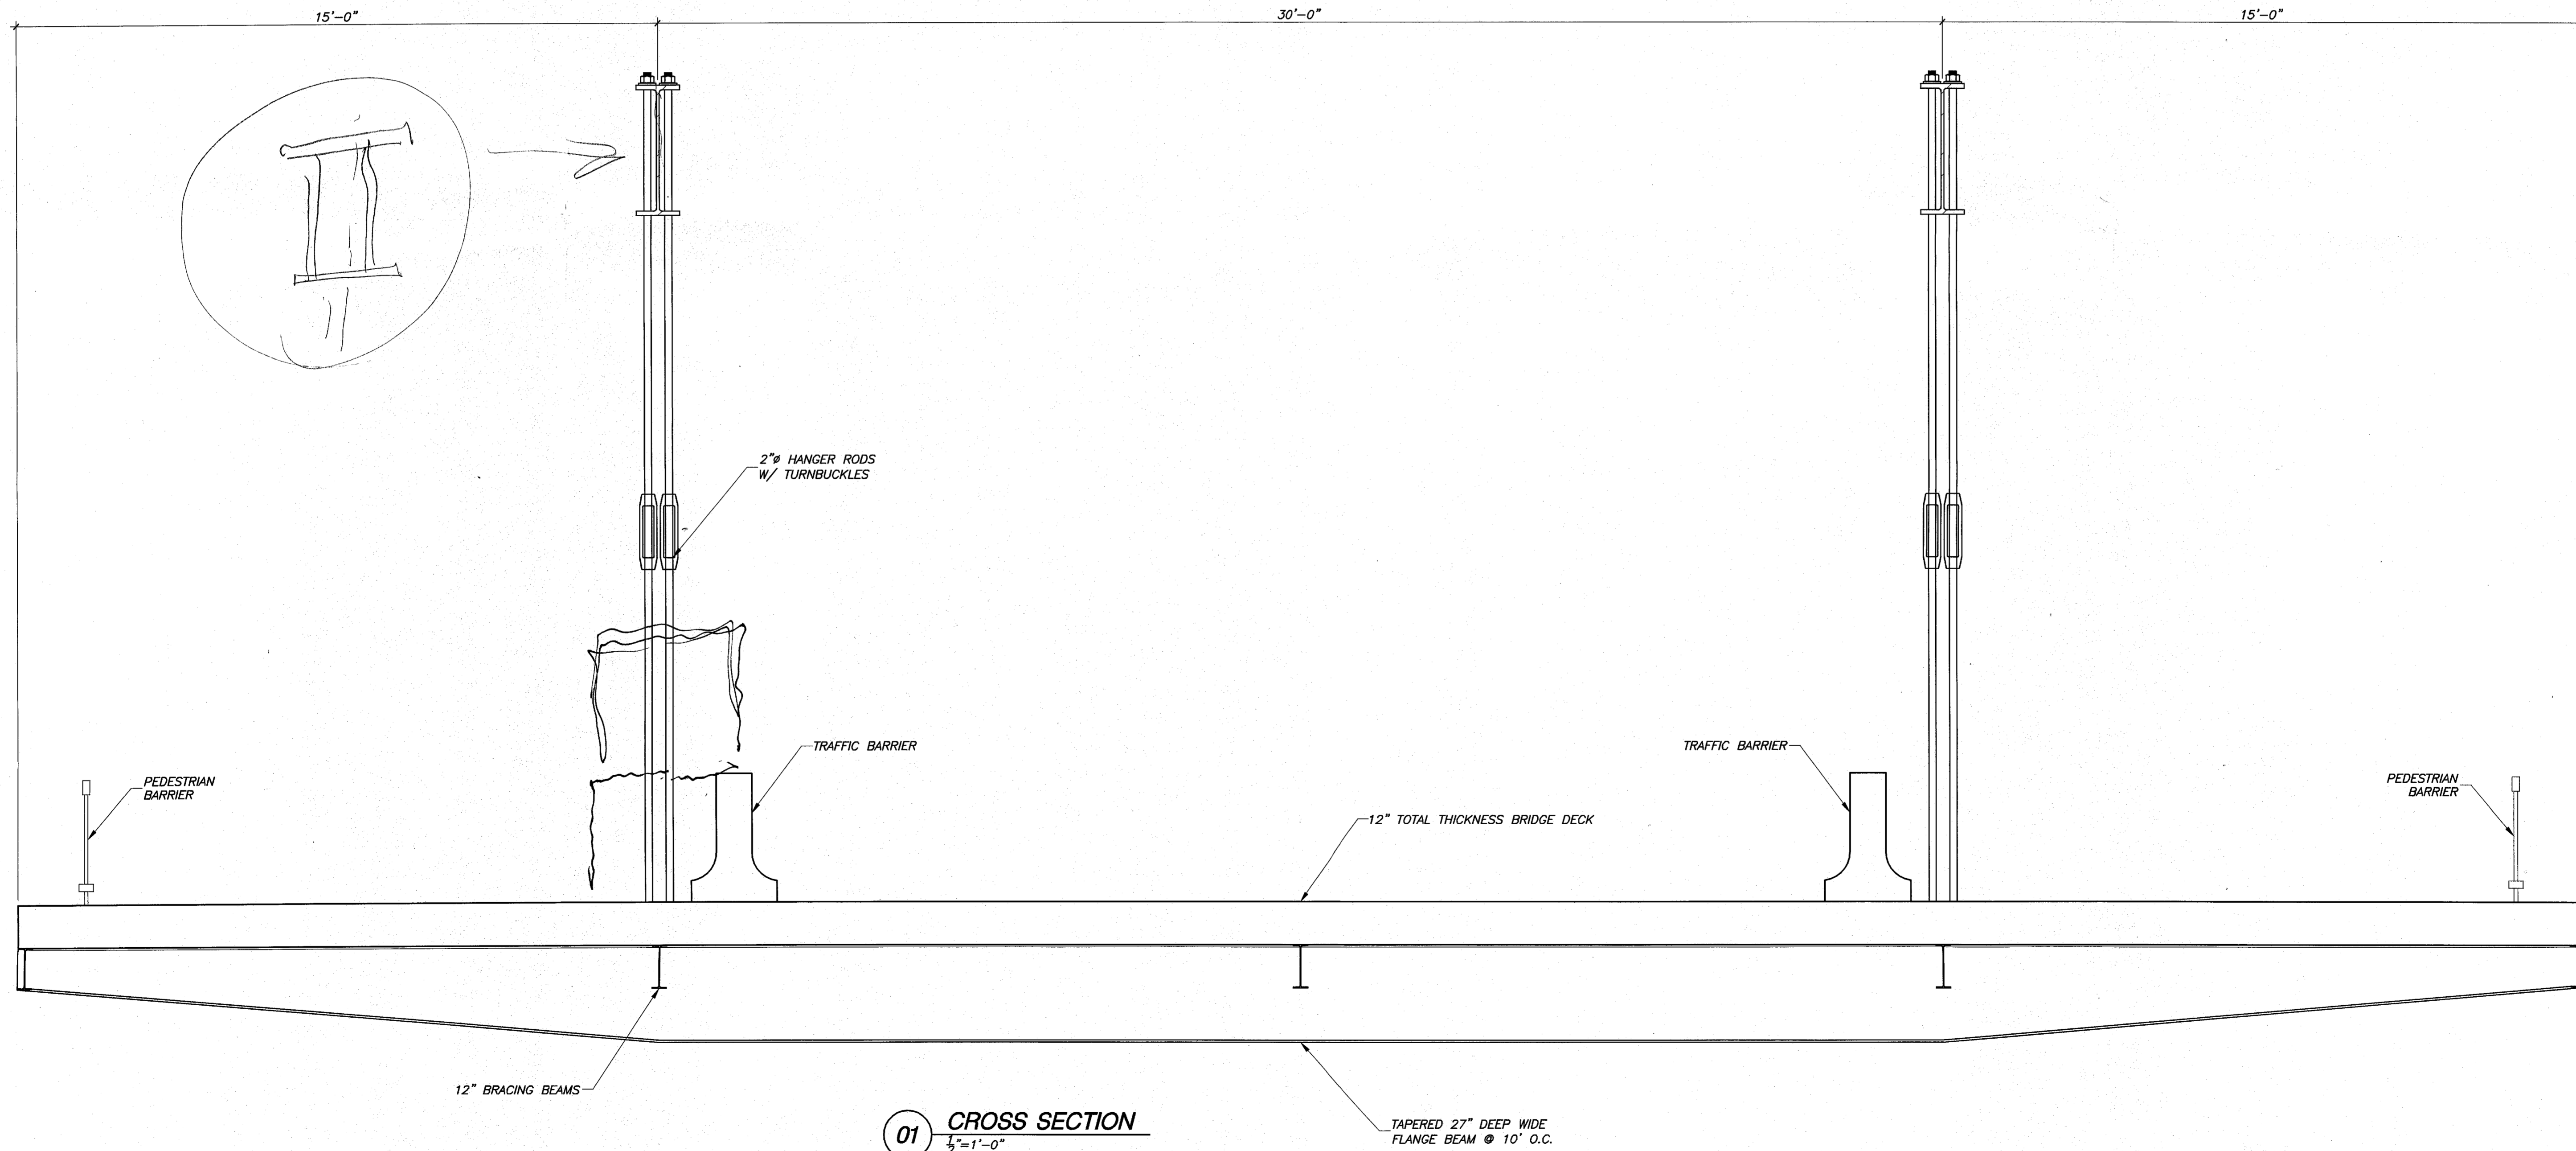

01 CROSS SECTION
1/2" = 1'-0"