


50-1008

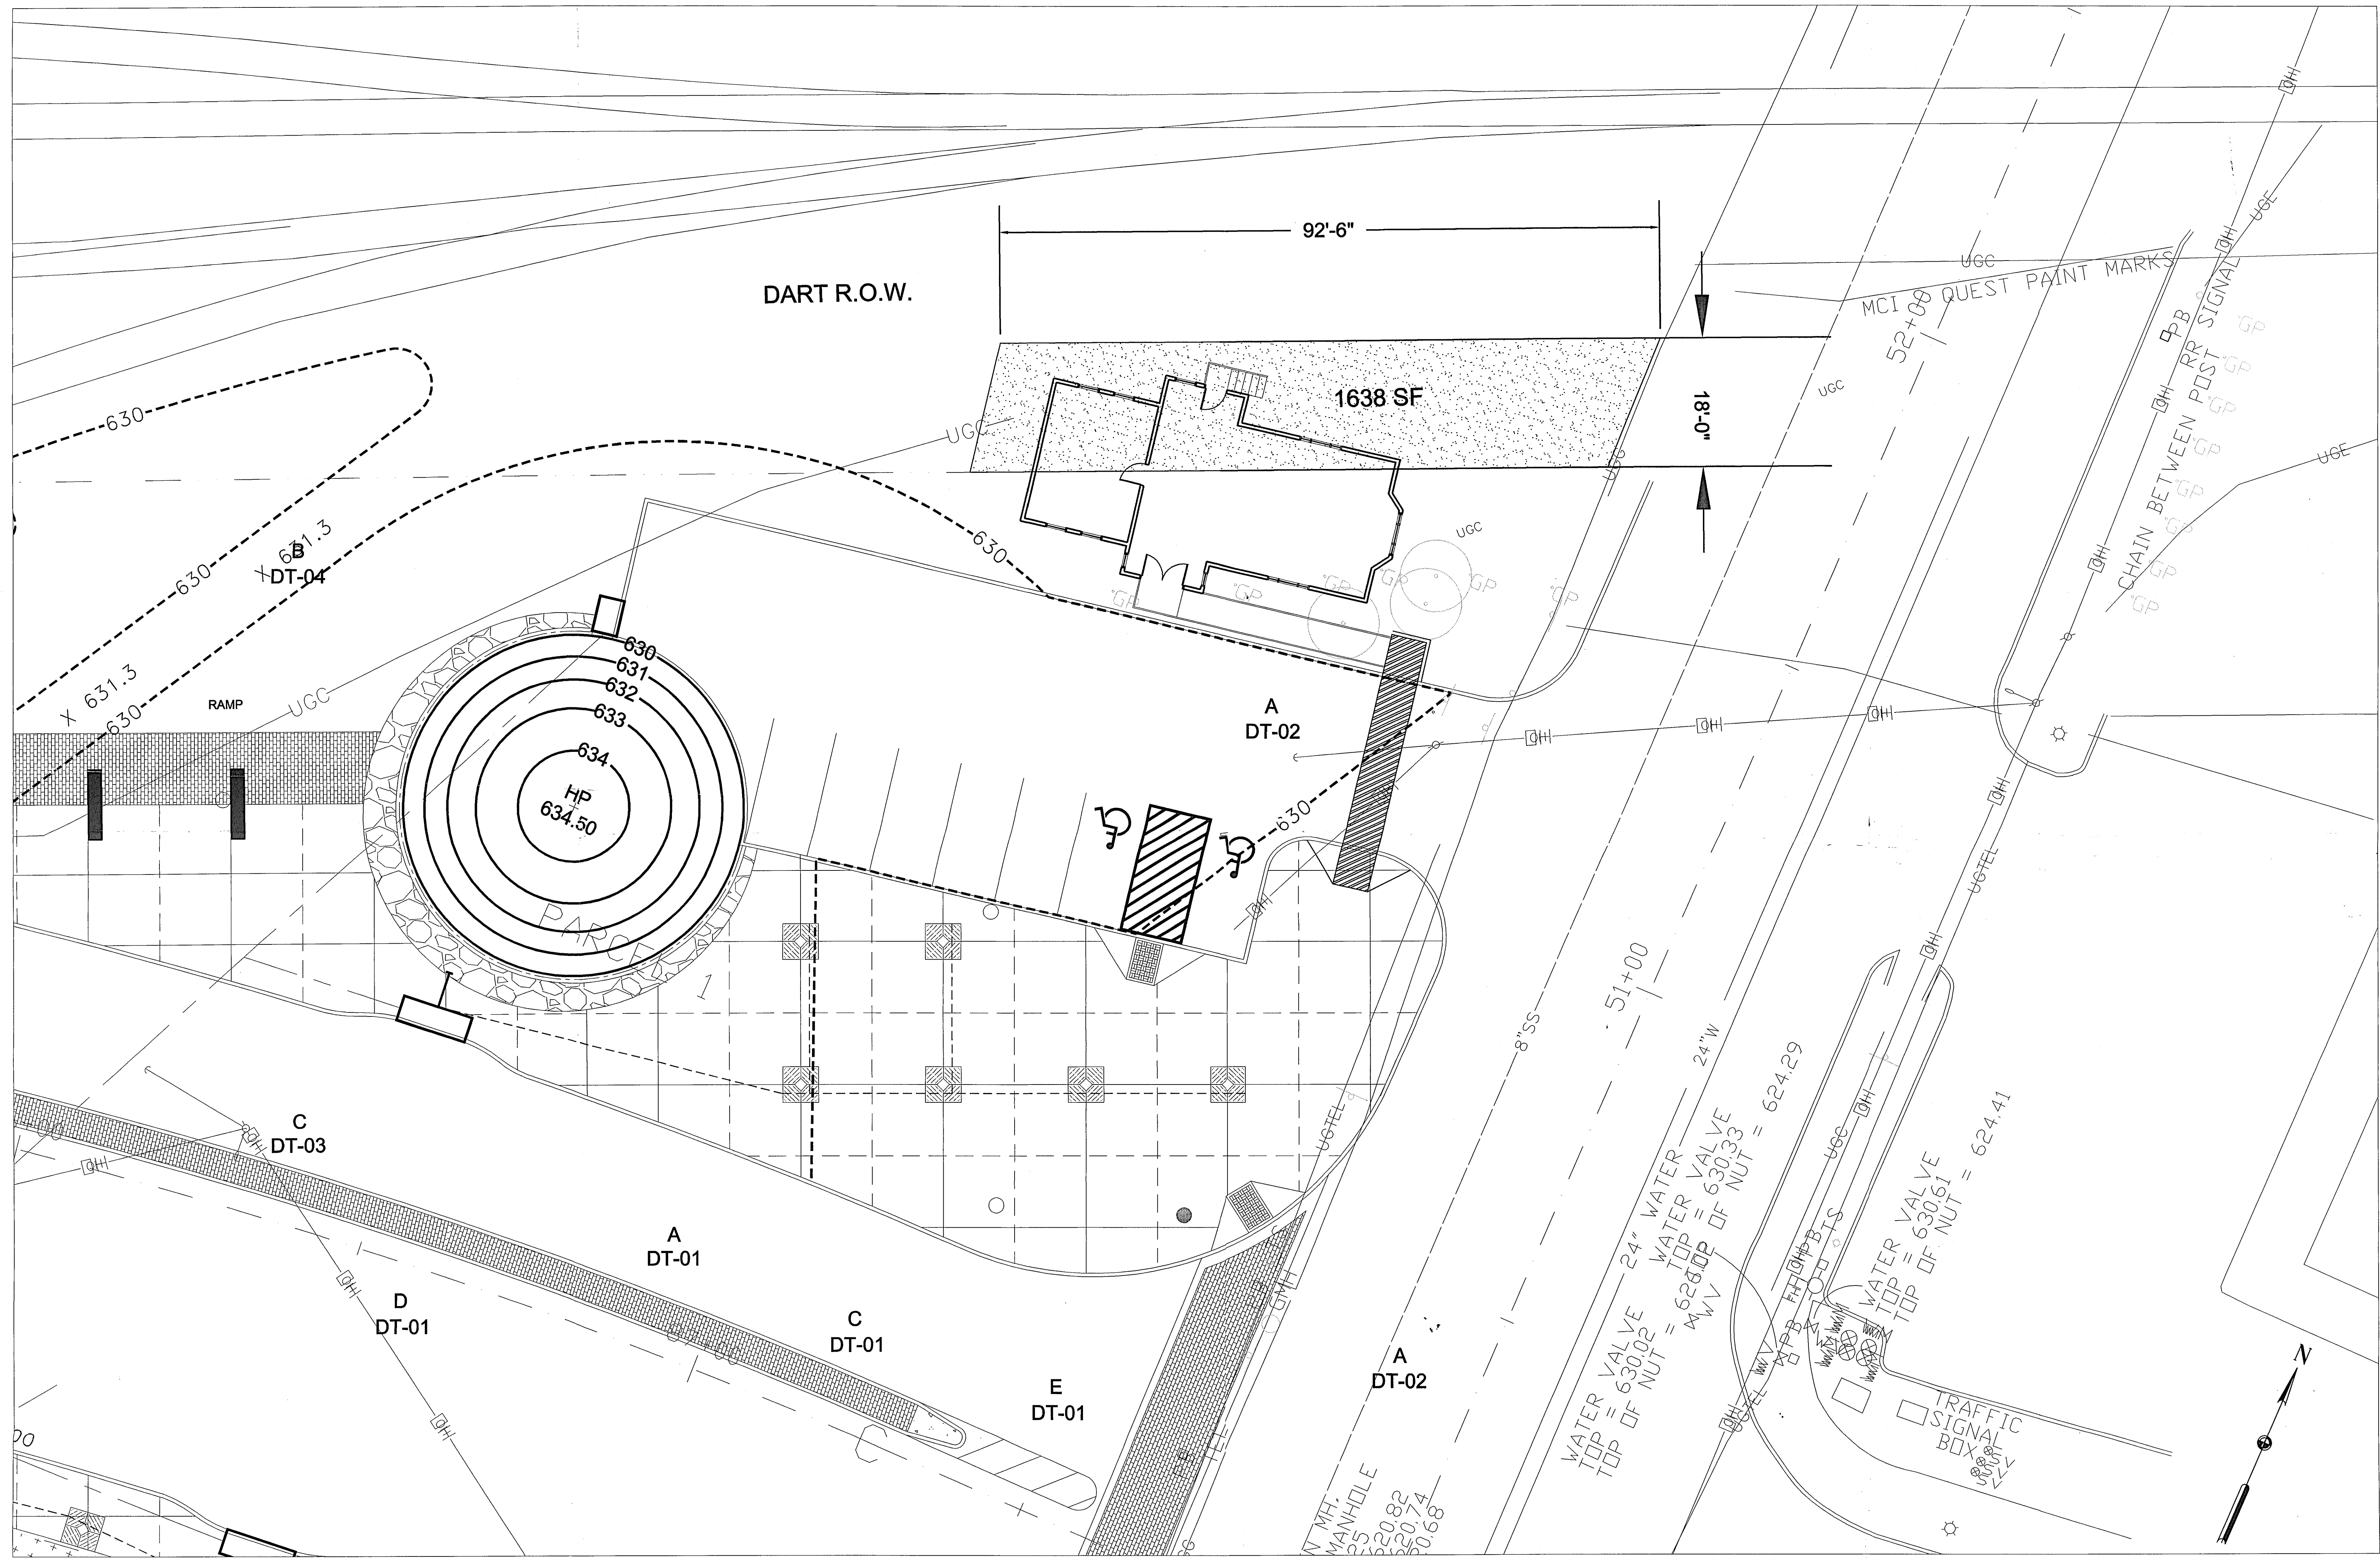

SITE PLAN scale: 1" = 10'-0"