


Site Plan 10 August 2007

Gensler

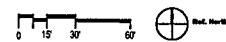

MARY KAY.