
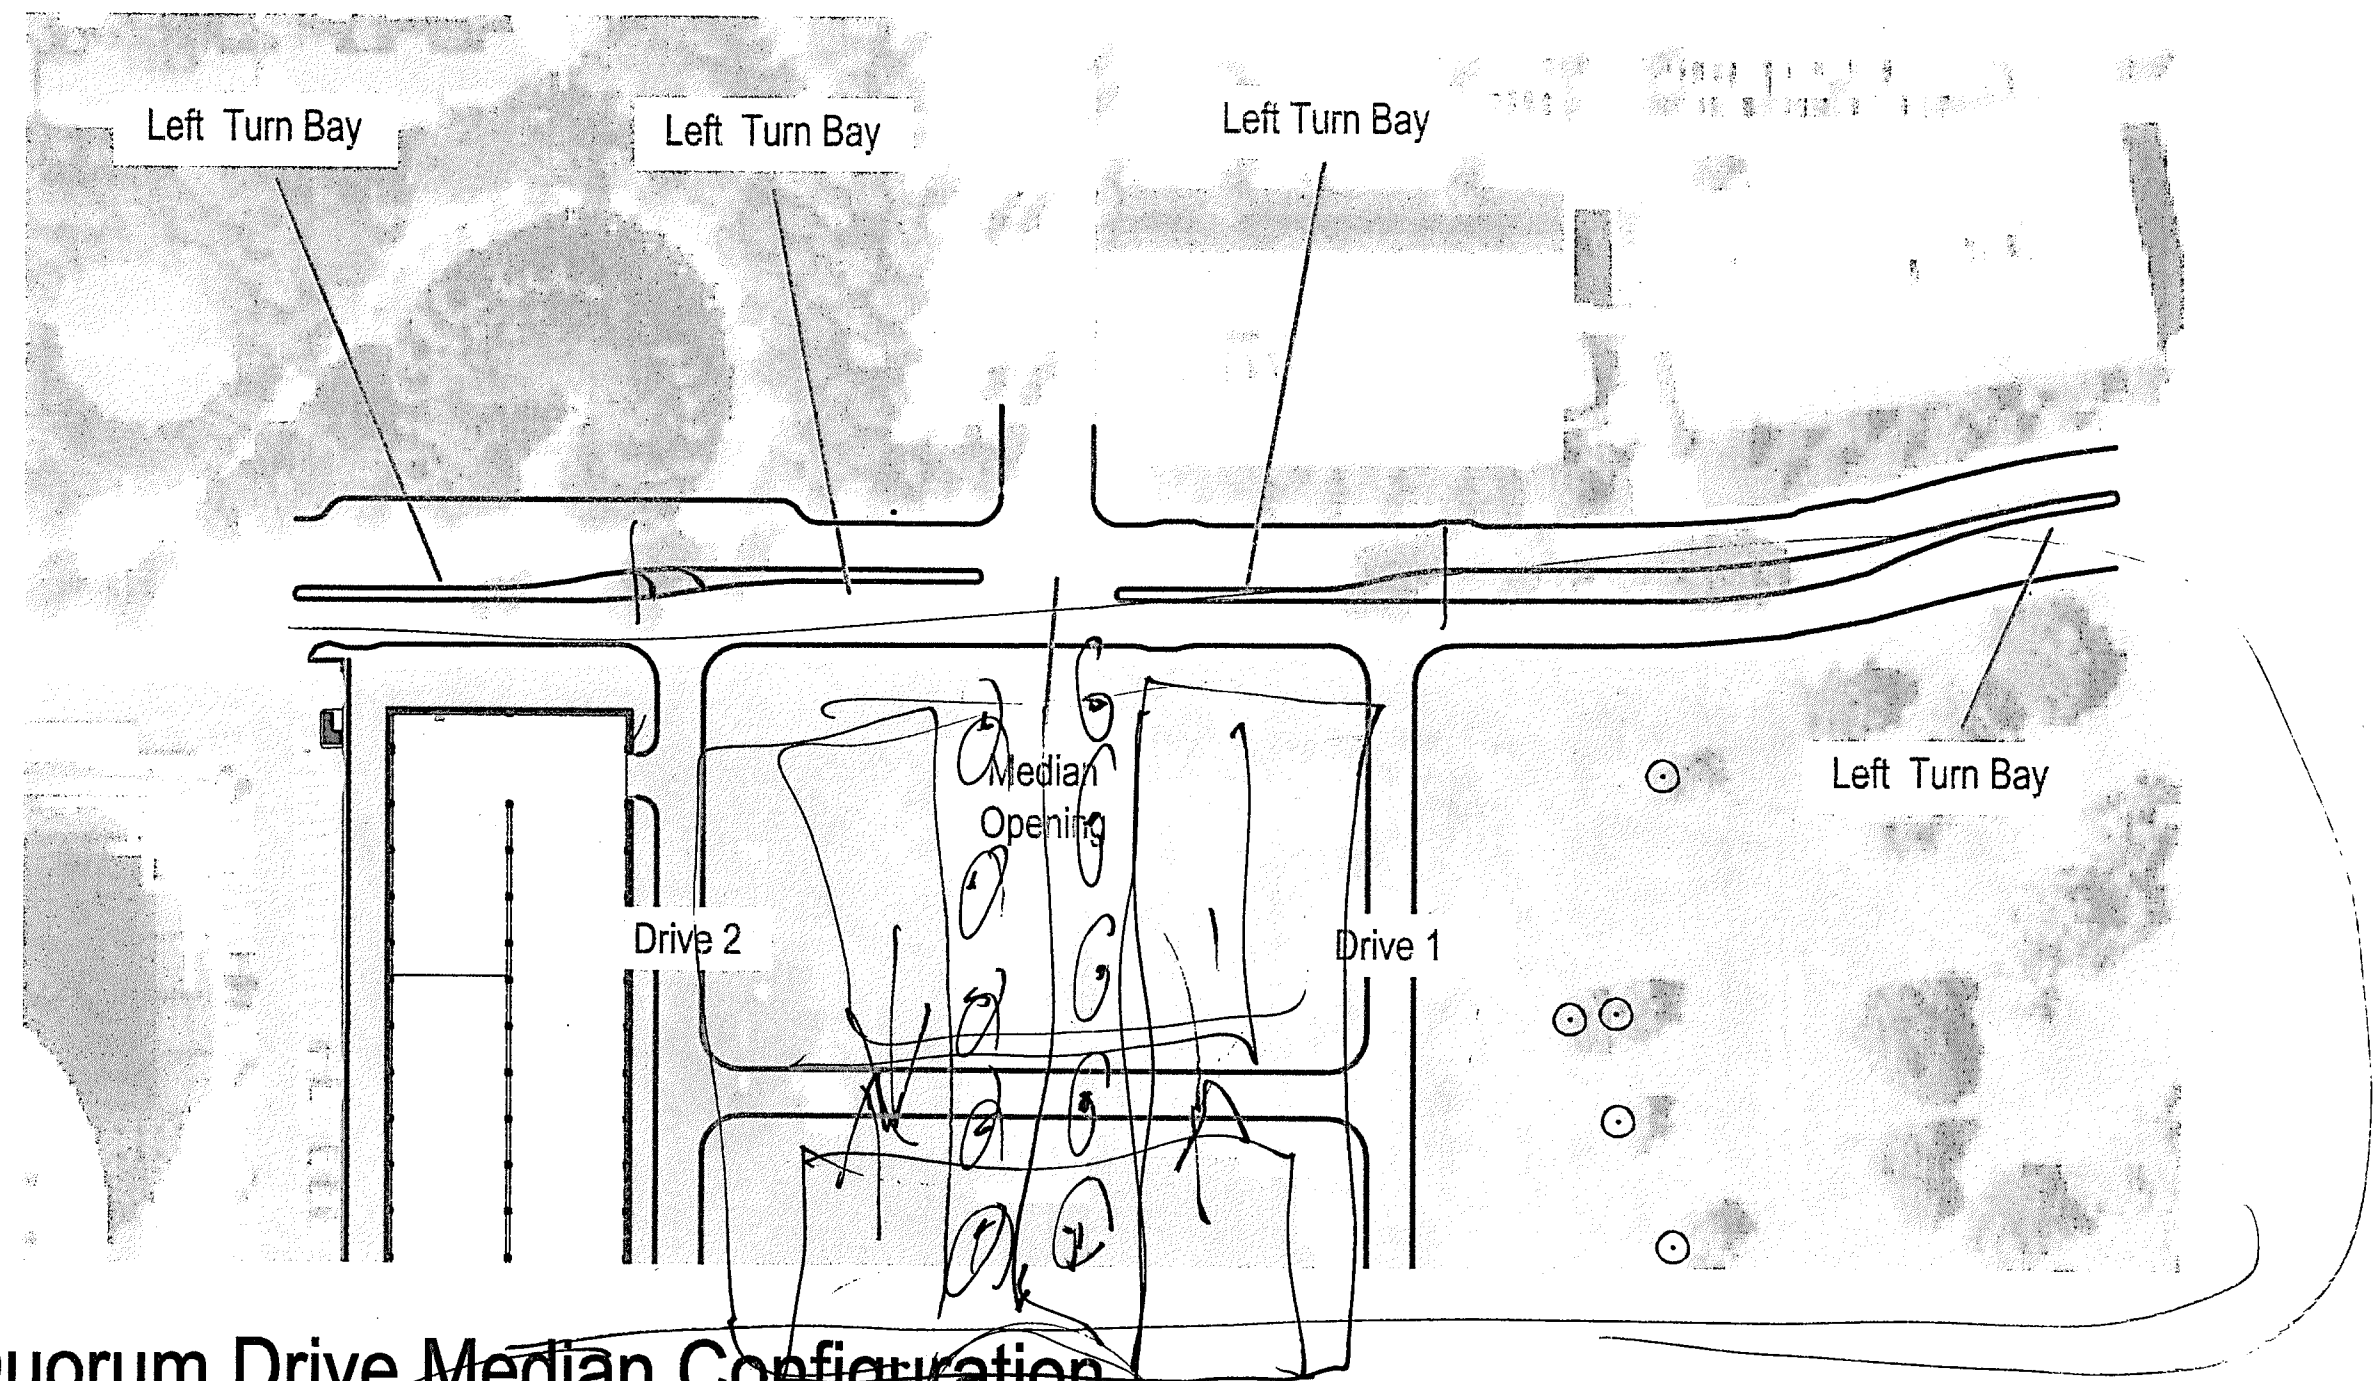


SCALE:  
1" = 100'

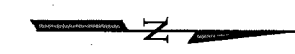

Existing Quorum Drive Median Configuration