
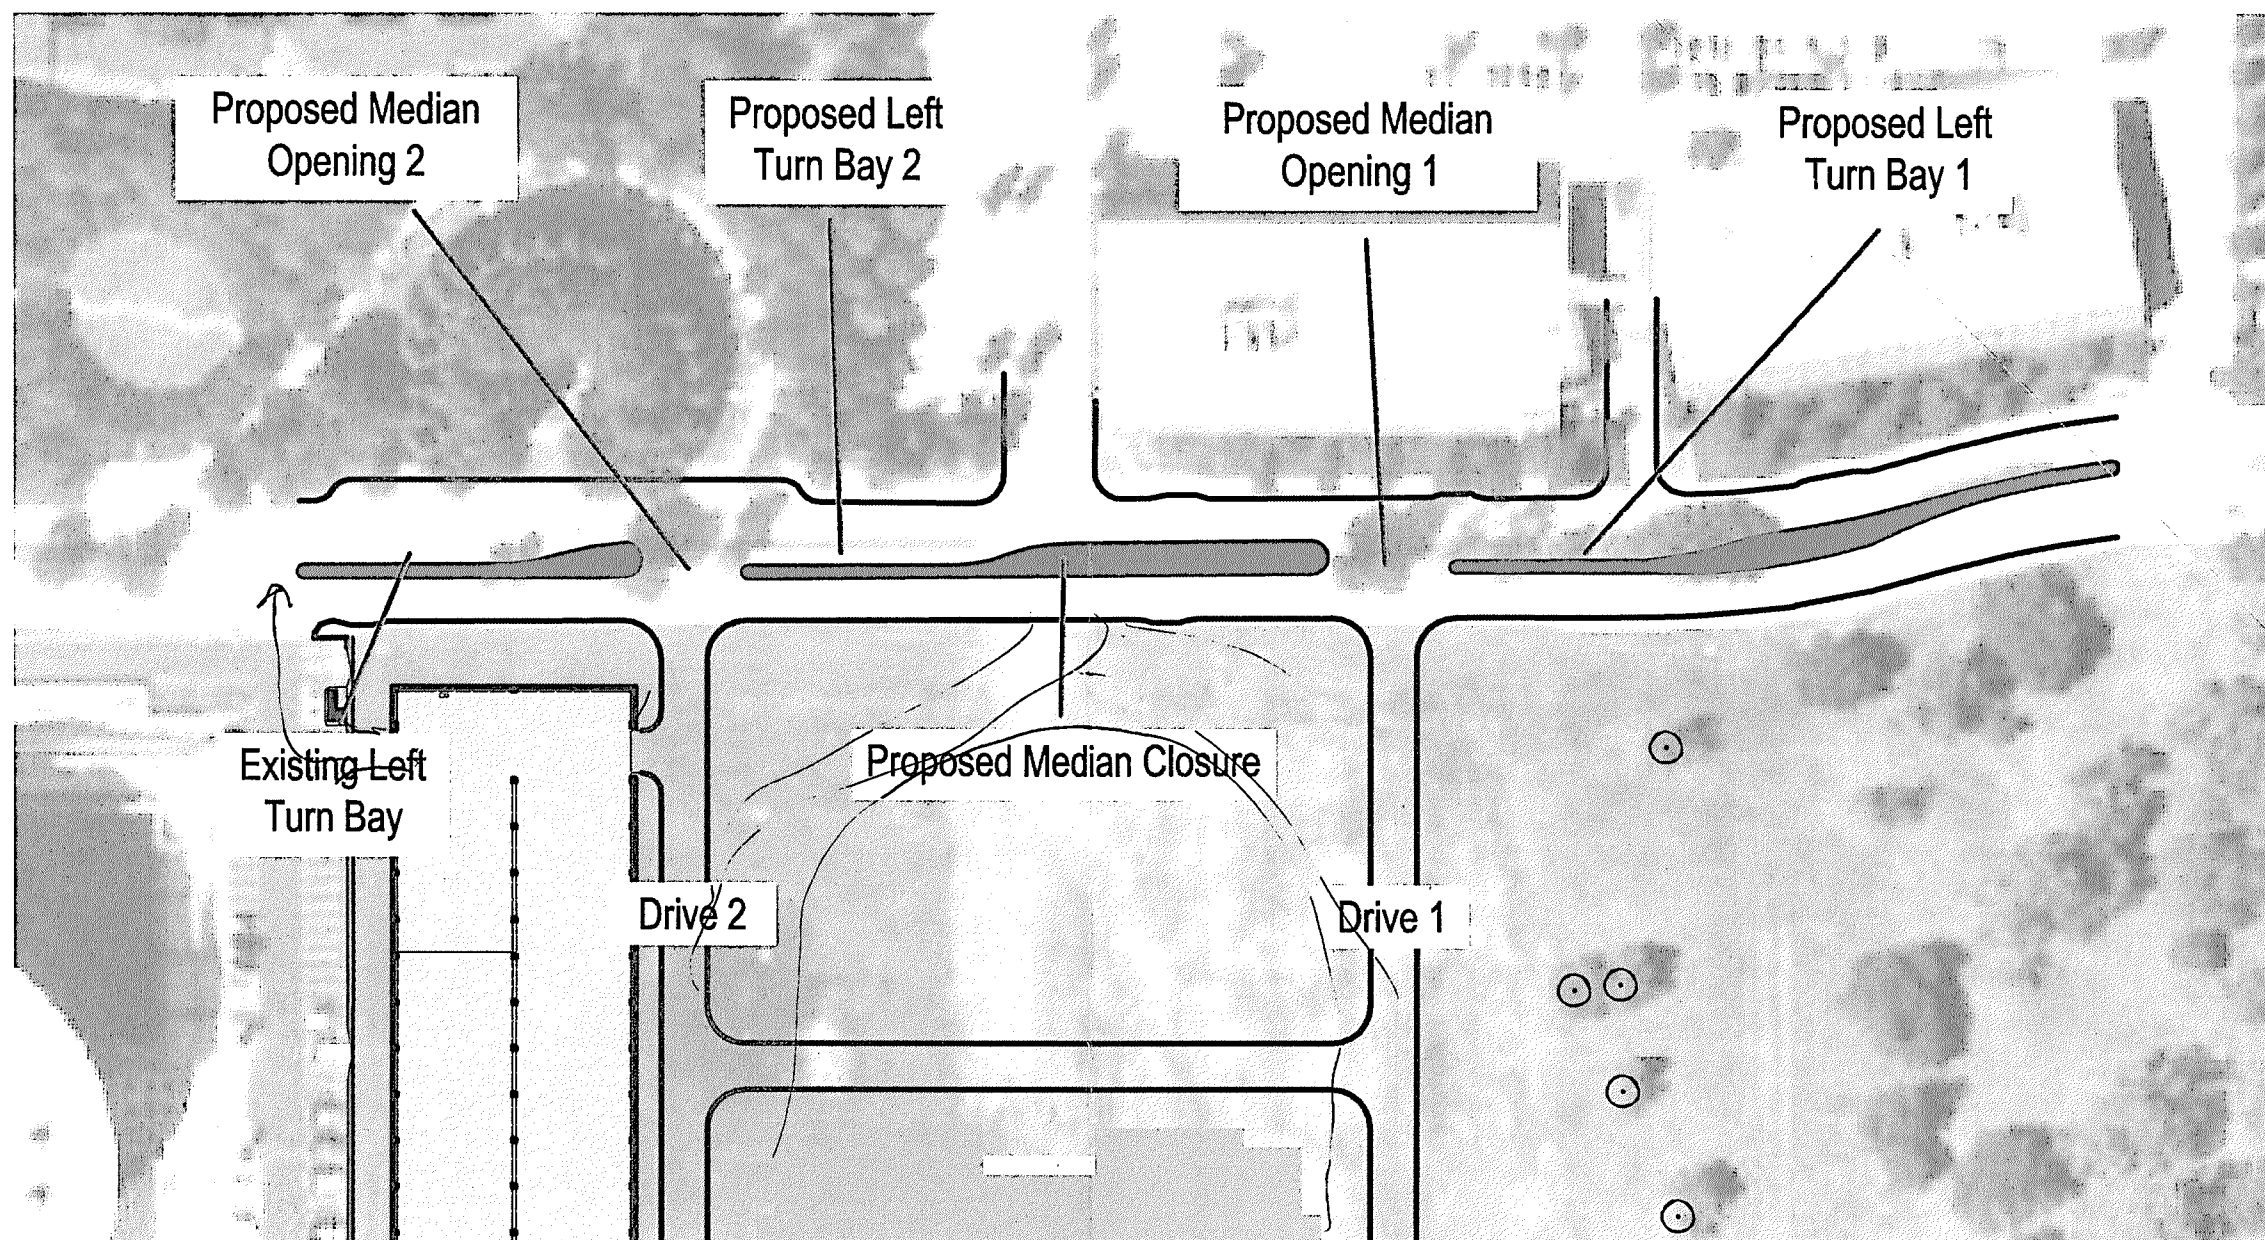


SCALE:
1" = 100'

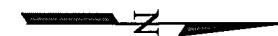

Proposed Quorum Drive - Full Site Access