
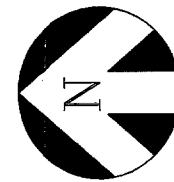


POINT OF BEGINNING

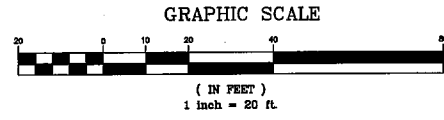

OWNER'S CERTIFICATE
State of Texas
County of Dallas

WHEREAS, **OTB PARTNERS, LTD.** is the owner of a 2.275 acre tract of land situated in the ELISHA FIKE SURVEY, Abst. No. 478, Dallas County, Texas being a portion of Lot 4, BELTWAY OFFICE PARK, III-R, an addition to the Town of Addison, Dallas County, Texas according to the plat recorded in Volume 92213, Page 321, Map Records, Dallas County, Texas and Lot 2, Beltway Office Park, Tract III, an addition to the Town of Addison, Dallas County, Texas according to the plat recorded in Volume 81087, Page 2713, Map Records, Dallas County, Texas and Lot 1, VICTORIA STATION ADDITION, an addition to the Town of Addison, Dallas County, Texas according to the plat recorded in Volume 79075, Page 1111, Map Records, Dallas County, Texas also being those certain tracts of land conveyed to OTB Partners, Ltd. by deed recorded in Volume 97223, Page 52, Deed Records, Dallas County, Texas and being more particularly described, as follows:

Beginning at a 1/2" iron found in the south line of Belt Line Road at the northeast corner of said Lot 1 and the northwest corner of Lot 1 BELTWAY OFFICE PARK, TRACT III, an addition to the Town of Addison, Dallas County, Texas according to the plat recorded in Volume 77086, Page 26, Map Records, Dallas County, Texas;

THENCE South 00 degrees 01 minutes 37 seconds East, along the common line of said Lot 1, VICTORIA STATION and said Lot 1, BELTWAY OFFICE PARK, TRACT III, 497.71 feet to a 1/2" iron set;

THENCE South 89 degrees 59 minutes 17 seconds West, 192.36 feet to a capped 5/8" iron found at the southeast corner of Lot 3, BELTWAY OFFICE PARK 111-R, an addition to the City of Addison, Dallas County, Texas according to the plat recorded in Volume 92213, Page 321, Map Records, Dallas County, Texas;

THENCE North 00 degrees 01 minutes 48 seconds West, along the common line of said Lot 4 and Lot 3, a distance of 471.21 feet to a 1/2" iron set;

THENCE South 89 degrees 59 minutes 16 seconds West, 9.95 feet to a pin nail found at the beginning of a curve to the right whose radius is 32.50 feet and whose long chord bears North 42 degrees 26 minutes 07 seconds West, 47.98 feet;

THENCE Along said curve in a northwesterly direction through a central angle of 95 degrees 09 minutes 31 seconds, a distance of 53.98 feet to an "X" cut in concrete found;

THENCE North 05 degrees 08 minutes 21 seconds East, 12.06 feet to a 1/2" iron set in the south line of said Belt Line Road;

THENCE South 84 degrees 53 minutes 38 seconds East, along the south line of said Belt Line Road, 234.55 feet to the POINT OF BEGINNING and containing 2.275 acres of land.


Now, therefore, know all men by these presents:

That, **OTB PARTNERS, LTD.** does hereby adopt this plat designating the herein above property as **LOT 1R, VICTORIA STATION**, an addition to the Town of Addison, Texas and subject to the conditions, restrictions and reservations stated hereinafter, owner dedicates to the public use forever the streets and alleys shown thereon.


THE EASEMENT SHOWN ON THIS PLAT ARE HEREBY RESERVED FOR THE PURPOSES AS INDICATED, INCLUDING, BUT NOT LIMITED TO, THE INSTALLATION AND MAINTENANCE OF WATER, SANITARY SEWER, STORM SEWER, DRAINAGE, TELEPHONE, GAS AND CABLE TELEVISION. OWNER SHALL HAVE THE RIGHT TO USE THESE EASEMENTS, PROVIDED, HOWEVER, THAT IT DOES NOT UNREASONABLY INTERFERE OR IMPEDE WITH THE PROVISION OF THE SERVICES TO OTHERS. SAID UTILITY EASEMENTS ARE HEREBY RESERVED BY MUTUAL USE AND ACCOMMODATION OF ALL PUBLIC UTILITIES USING OR DESIRING TO USE THE SAME. AN EXPRESS EASEMENT OF INGRESS AND EGRESS IS HEREBY EXPRESSLY GRANTED ON, OVER AND ACROSS ALL SUCH EASEMENTS FOR THE BENEFIT OF THE PROVIDER OF SERVICES FOR WHICH EASEMENTS ARE GRANTED.

ANY DRAINAGE AND FLOODWAY EASEMENT SHOWN HEREON IS HEREBY DEDICATED TO THE PUBLIC'S USE FOREVER, BUT INCLUDING THE FOLLOWING COVENANTS WITH REGARD TO MAINTENANCE RESPONSIBILITIES. THE EXISTING CHANNELS OR CREEKS TRAVERSING THE DRAINAGE AND FLOODWAY EASEMENT WILL REMAIN AS AN OPEN CHANNEL, UNLESS REQUIRED TO BE ENCLOSED BY ORDINANCE. AT ALL TIMES SHALL BE MAINTAINED BY THE INDIVIDUAL OWNERS OF THE LOT OR LOTS THAT ARE TRAVERSED BY OR ADJACENT TO THE DRAINAGE AND FLOODWAY EASEMENT. THE TOWN WILL NOT BE RESPONSIBLE FOR THE MAINTENANCE AND OPERATION OF SAID CREEK OR CREEKS OR FOR ANY DAMAGE OR INJURY OF PRIVATE PROPERTY OR PERSON THAT RESULTS FROM THE FLOW OF WATER ALONG SAID CREEK, OR FOR THE CONTROL OF EROSION, NO OBSTRUCTION TO THE NATURAL FLOW OF WATER RUNOFF SHALL BE PERMITTED BY CONSTRUCTION OF ANY TYPE BUILDING, FENCE OR ANY OTHER STRUCTURE WITHIN THE DRAINAGE AND FLOODWAY EASEMENT. PROVIDED, HOWEVER, IT IS UNDERSTOOD THAT IN THE EVENT IT BECOMES NECESSARY FOR THE TOWN TO CHANNELIZE OR CONSIDER ERECTING ANY TYPE OF DRAINAGE STRUCTURE IN ORDER TO IMPROVE THE STORM DRAINAGE, THEN IN SUCH EVENT, THE TOWN SHALL HAVE THE RIGHT, BUT NOT THE OBLIGATION, TO ENTER UPON DRAINAGE AND FLOODWAY EASEMENT AT ANY POINT, OR POINTS, WITH ALL RIGHTS OF INGRESS AND EGRESS TO INVESTIGATE, SURVEY, ERECT, CONSTRUCT OR MAINTAIN ANY DRAINAGE FACILITY DEEMED NECESSARY BY THE TOWN FOR MAINTENANCE OR EFFICIENCY OF ITS RESPECTIVE SYSTEM OR SERVICE.

WATER MAIN AND SANITARY SEWER EASEMENTS SHALL ALSO INCLUDE ADDITIONAL AREA OF WORKING SPACE FOR CONSTRUCTION AND MAINTENANCE OF THE SYSTEMS. ADDITIONAL EASEMENT AREA IS ALSO CONVEYED FOR INSTALLATION AND MAINTENANCE OF MANHOLES, CLEANOUTS, FIRE HYDRANTS, WATER SERVICE AND SEWER SERVICES FROM THE MAIN TO CURB OR PAVEMENT LINE, AND THE DESCRIPTIONS OF SUCH ADDITIONAL EASEMENTS HEREIN GRANTED SHALL BE DETERMINED BY THEIR LOCATIONS AS INSTALLED.

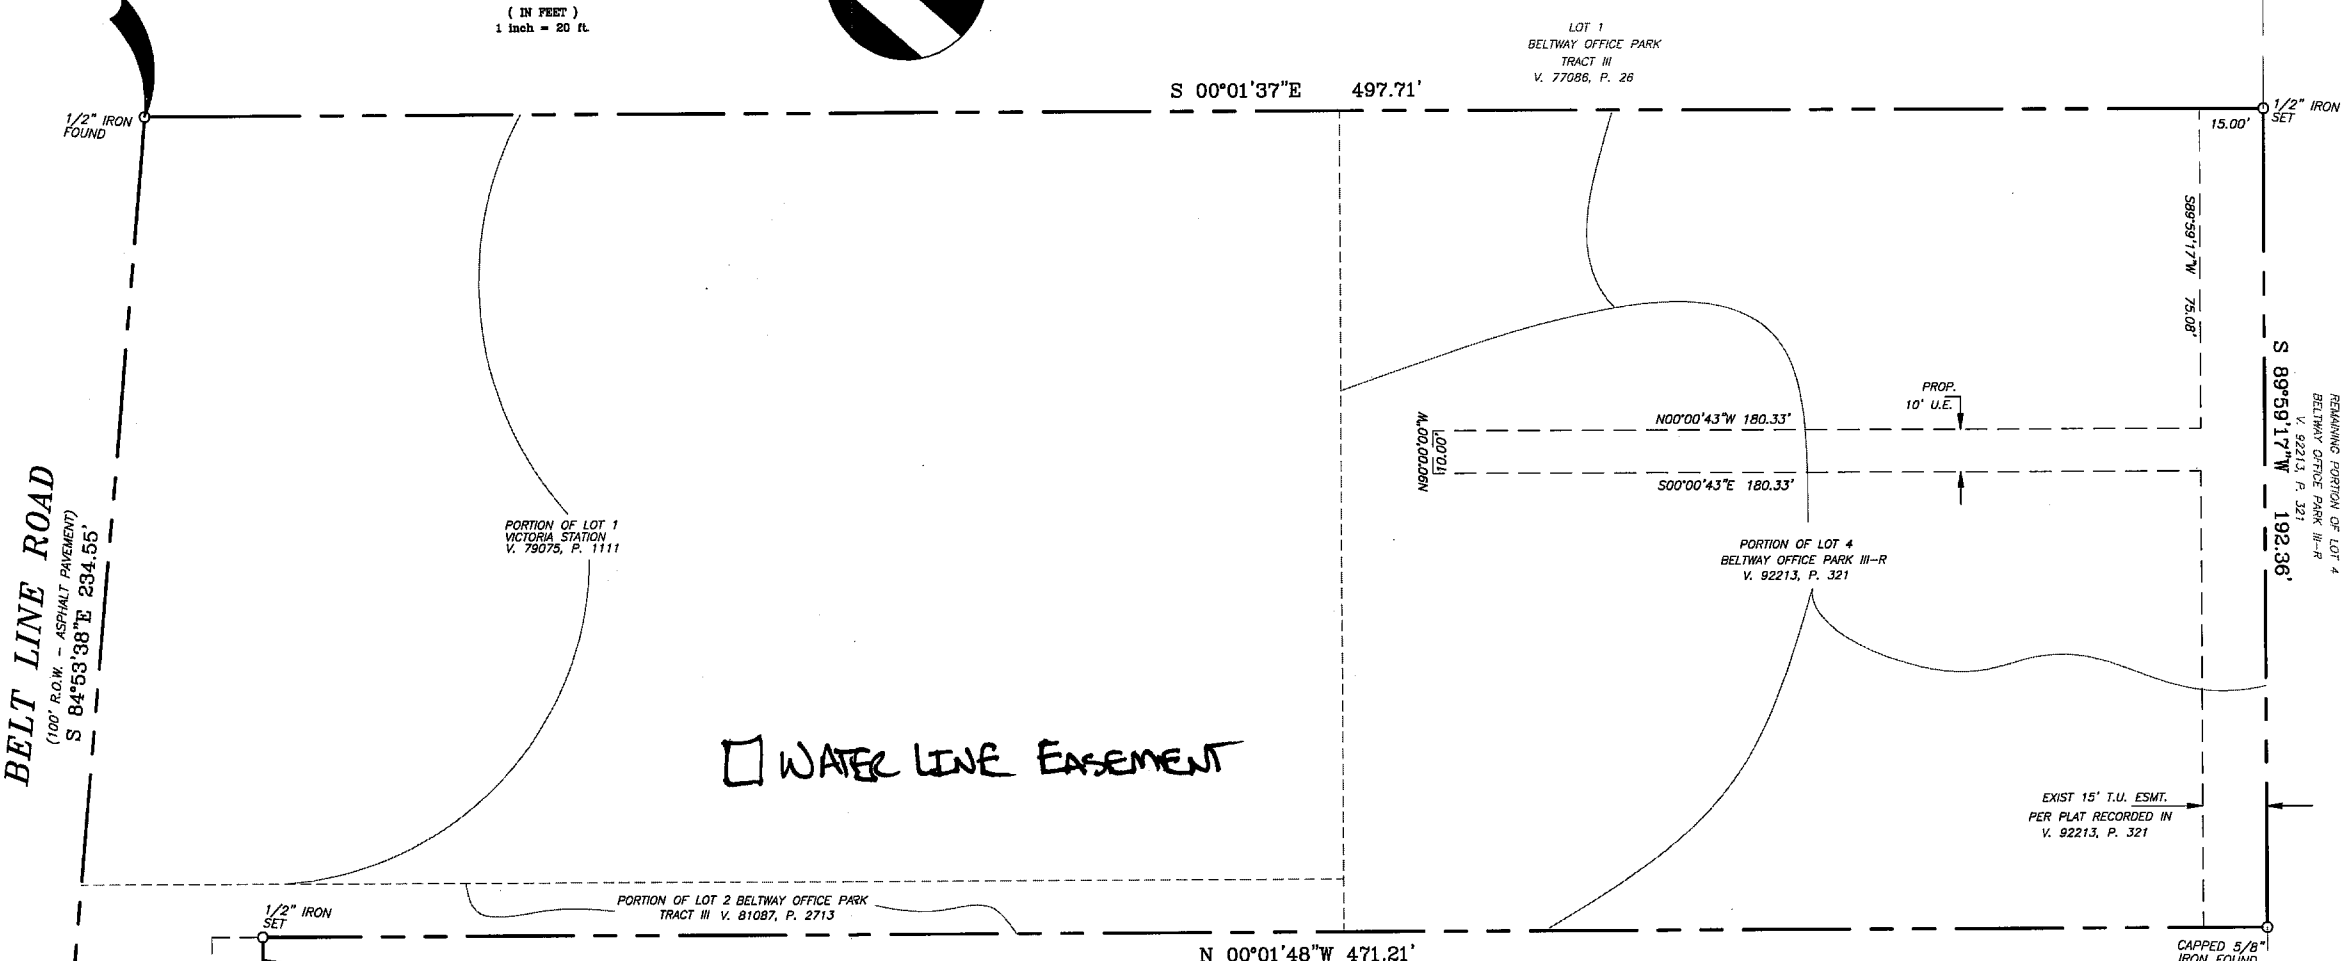

BELT LINE ROAD
(100' R.O.W. - ASPHALT PAVEMENT)
S 84°53'38"E 234.55'

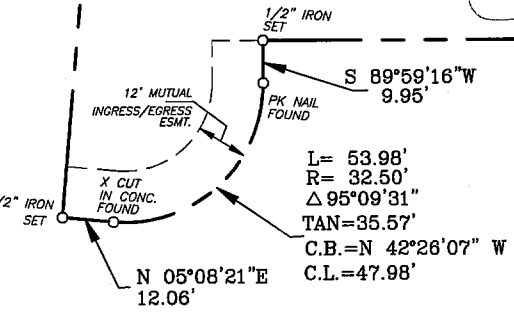

LOT 3
BELTWAY OFFICE
PARK III-R
V. 92213, P. 321

TOWN OF ADDISON, TEXAS
CITY PLANNING COMMISSION
THIS PLAT IS VALID ONLY IF RECORDED WITHIN
SIX (6) MONTHS AFTER DATE OF APPROVAL

Approved by the City Council of the Town of Addison,
Texas on the ____ day of _____, 2007.

BY: _____
CITY SECRETARY
BY: _____
MAYOR

THIS PLAT IS APPROVED SUBJECT TO ALL PLANNING ORDINANCES, RULES, REGULATIONS AND RESOLUTIONS OF THE TOWN OF ADDISON, TEXAS.

THE CONSTRUCTION PLANS SHALL BE PREPARED BY OR UNDER THE SUPERVISION OF A REGISTERED PROFESSIONAL ENGINEER IN THE STATE OF TEXAS AND SHALL BEAR HIS SEAL ON EACH SHEET.

THE PLANS SHALL CONTAIN ALL NECESSARY INFORMATION FOR CONSTRUCTION OF THE PROJECT, INCLUDING SCREENING WALLS. ALL MATERIALS SPECIFIED SHALL CONFORM TO THE STANDARD SPECIFICATIONS OF THE TOWN OF ADDISON.

EACH SHEET OF THE PLANS SHALL CONTAIN A TITLE BLOCK INCLUDING SPACE FOR THE NOTATION OF REVISIONS. THIS SPACE IS TO BE COMPLETED WITH EACH REVISION TO THE PLAN SHEET AND SHALL CLEARLY SHOW THE NATURE OF THE REVISION AND THE DATE THE REVISION WAS MADE.

AFTER REVIEW OF THE PLANS AND PLANS BY THE PUBLIC WORKS DEPARTMENT AND TOWN ENGINEER, THE PLANS SHALL BE SUBMITTED TO THE PLANNING AND ZONING COMMISSION AND THE CITY COUNCIL FOR THEIR CONSIDERATION. IF APPROVED BY THOSE BODIES SUBJECT TO CHANGES, THE ENGINEER FOR THE OWNER SHALL MAKE ALL CHANGES REQUIRED. THE DIRECTOR OF PUBLIC WORKS OR HIS DESIGNATED AGENT WILL APPROVE ALL PLANS AND RETURN SUFFICIENT APPROVED SETS OF THE PLANS TO THE ENGINEER FOR THE OWNER FOR USE BY THE CONTRACTORS. EACH CONTRACTOR SHALL MAINTAIN ONE SET OF THE PLANS, STAMPED WITH TOWN APPROVAL, ON THE PROJECT ALL TIMES DURING CONSTRUCTION.

STATE OF TEXAS
COUNTY OF DALLAS

BEFORE ME, THE UNDERSIGNED AUTHORITY, ON THIS DAY PERSONALLY APPEARED **DARYL SNADON**, KNOWN TO ME TO BE THE PERSON WHOSE NAME IS SUBSCRIBED TO THE FOREGOING INSTRUMENT AN ACKNOWLEDGED TO ME THAT HE EXECUTED THE SAME FOR THE PURPOSES AND CONSIDERATIONS THEREIN EXPRESSED AND IN THE CAPACITY THEREIN STATED.

GIVEN UNDER MY HAND AND SEAL OF OFFICE, THIS ____ DAY OF _____, 2007

NOTARY PUBLIC IN AND FOR THE STATE OF TEXAS

SURVEYOR'S CERTIFICATE:

I, **ANDREW E. STEVENS** A REGISTERED PROFESSIONAL LAND SURVEYOR OF THE STATE OF TEXAS DO HEREBY CERTIFY THAT THIS PLAT WAS PREPARED FROM AN ACTUAL ON THE GROUND SURVEY AND THAT THIS PLAT CORRECTLY REPRESENTS THAT SURVEY WAS MADE UNDER MY SUPERVISION.

ANDREW E. STEVENS
REGISTERED PROFESSIONAL LAND SURVEYOR
TEXAS REGISTRATION # 5395
STEVENS LAND SURVEYING, INC.
7300-B WEATHERFORD HWY.
FORT WORTH, TEXAS 76116
(817) 696-9775



STATE OF TEXAS
COUNTY OF DALLAS

BEFORE ME, THE UNDERSIGNED AUTHORITY, ON THIS DAY PERSONALLY APPEARED **ANDREW E. STEVENS**, KNOWN TO ME TO BE THE PERSON WHOSE NAME IS SUBSCRIBED TO THE FOREGOING INSTRUMENT AN ACKNOWLEDGED TO ME THAT HE EXECUTED THE SAME FOR THE PURPOSES AND CONSIDERATIONS THEREIN EXPRESSED AND IN THE CAPACITY THEREIN STATED.

GIVEN UNDER MY HAND AND SEAL OF OFFICE, THIS ____ DAY OF _____, 2007

NOTARY PUBLIC STATE OF TEXAS

SURVEYOR
STEVENS LAND SURVEYING, INC.
7300-B WEATHERFORD HWY.
FORT WORTH, TEXAS 76116
(817) 696-9775

ENGINEER
McINNIS LAND CONSULTANTS, LLC
108 W. 8TH STREET, STE 300
FORT WORTH, TX 76102
OFFICE: 817-877-4200
FAX: 817-877-4201

FINAL PLAT
OF
VICTORIA STATION
LOT 1R

BEING A REPLAT OF
PORTION OF LOT 1, VICTORIA STATION
V. 79075, P. 1111
AND
PORTION OF LOT 2 BELTWAY OFFICE PARK
TRACT III V. 81087, P. 2713
AND
PORTION OF LOT 4, BELTWAY OFFICE PARK III-R
V. 92213, P. 321

IN ALL BEING 2.275 ACRES LOCATED IN THE
ELISHA FIKE SURVEY, Abst. No. 478,
AN ADDITION TO THE TOWN OF ADDISON
DALLAS COUNTY, TEXAS
SEPTEMBER 10, 2007



Revised 9/10/2007 per Public Works Review dated 8/24/2007
Revised 8/20/2007 per Public Works Review dated 8/14/2007

2007-06