


ARTHUR'S RESTUARANT

QUORUM DRIVE
ADDISON, TEXAS


TOWN OF ADDISON PUBLIC WORKS
No. 2007-014

TITLE SHEET

- FP-1 FINAL PLAT
- CE-1 DIMENSION CONTROL PLAN
- CE-2 GRADING PLAN
- CE-3 STORM SEWER & UTILITIES
- CE-4 PAVING PLAN & DETAILS
- DA-1 DRAINAGE AREA MAP
- EC-1 EROSION CONTROL PLAN

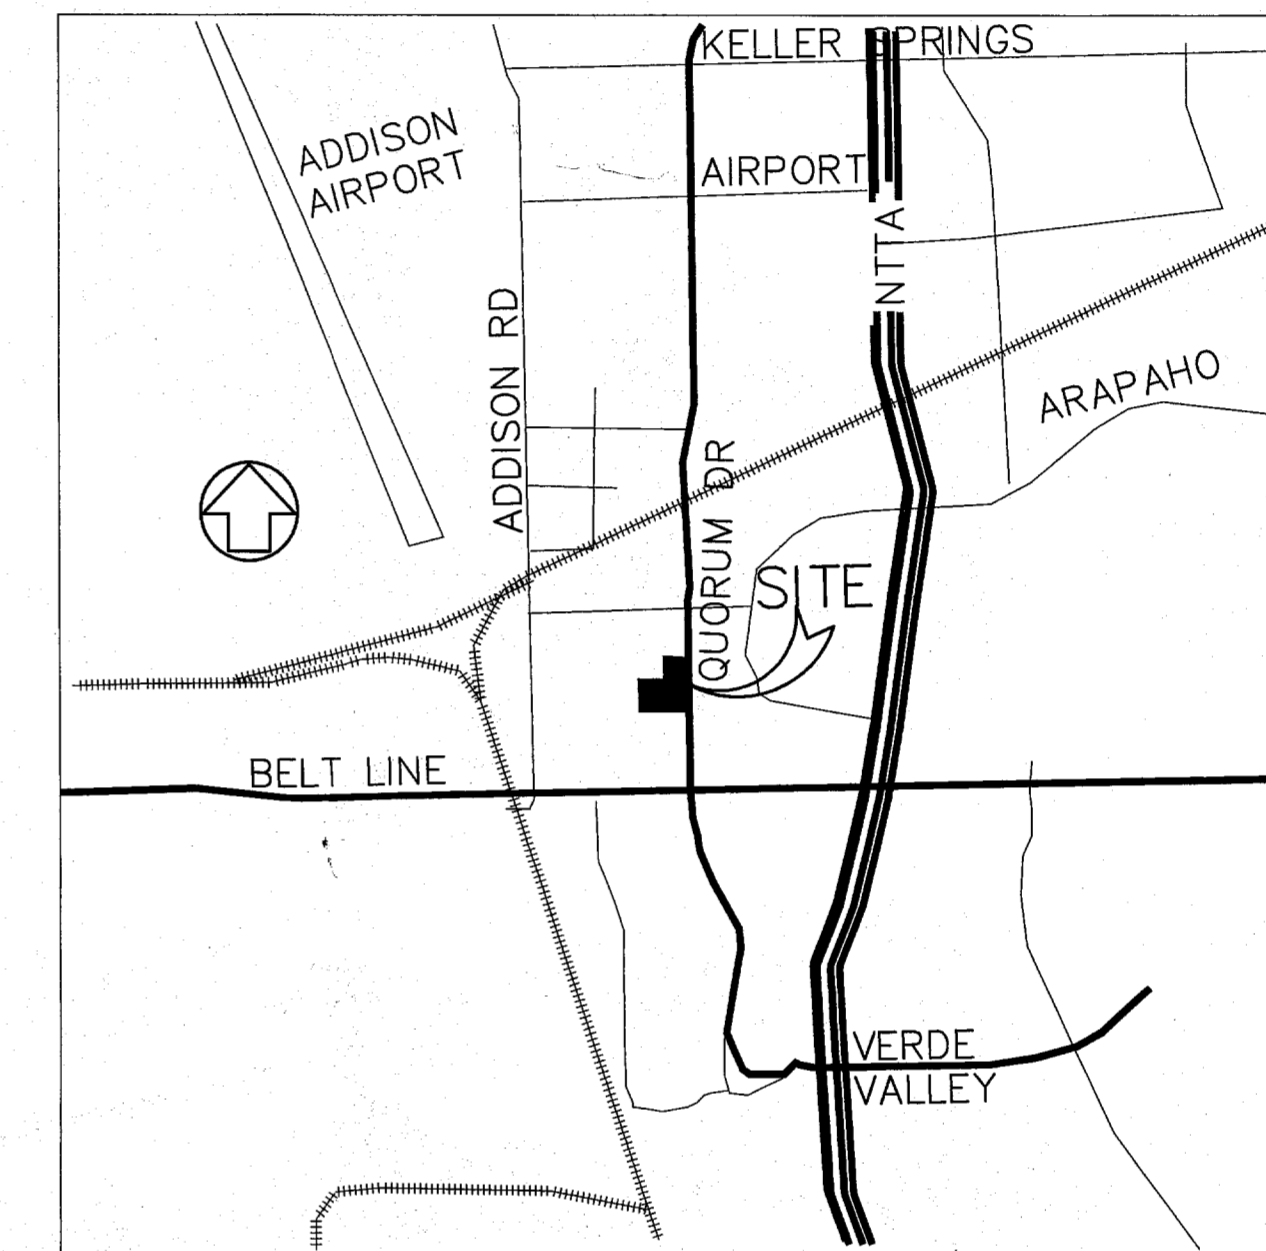


VICINITY MAP
N.T.S.

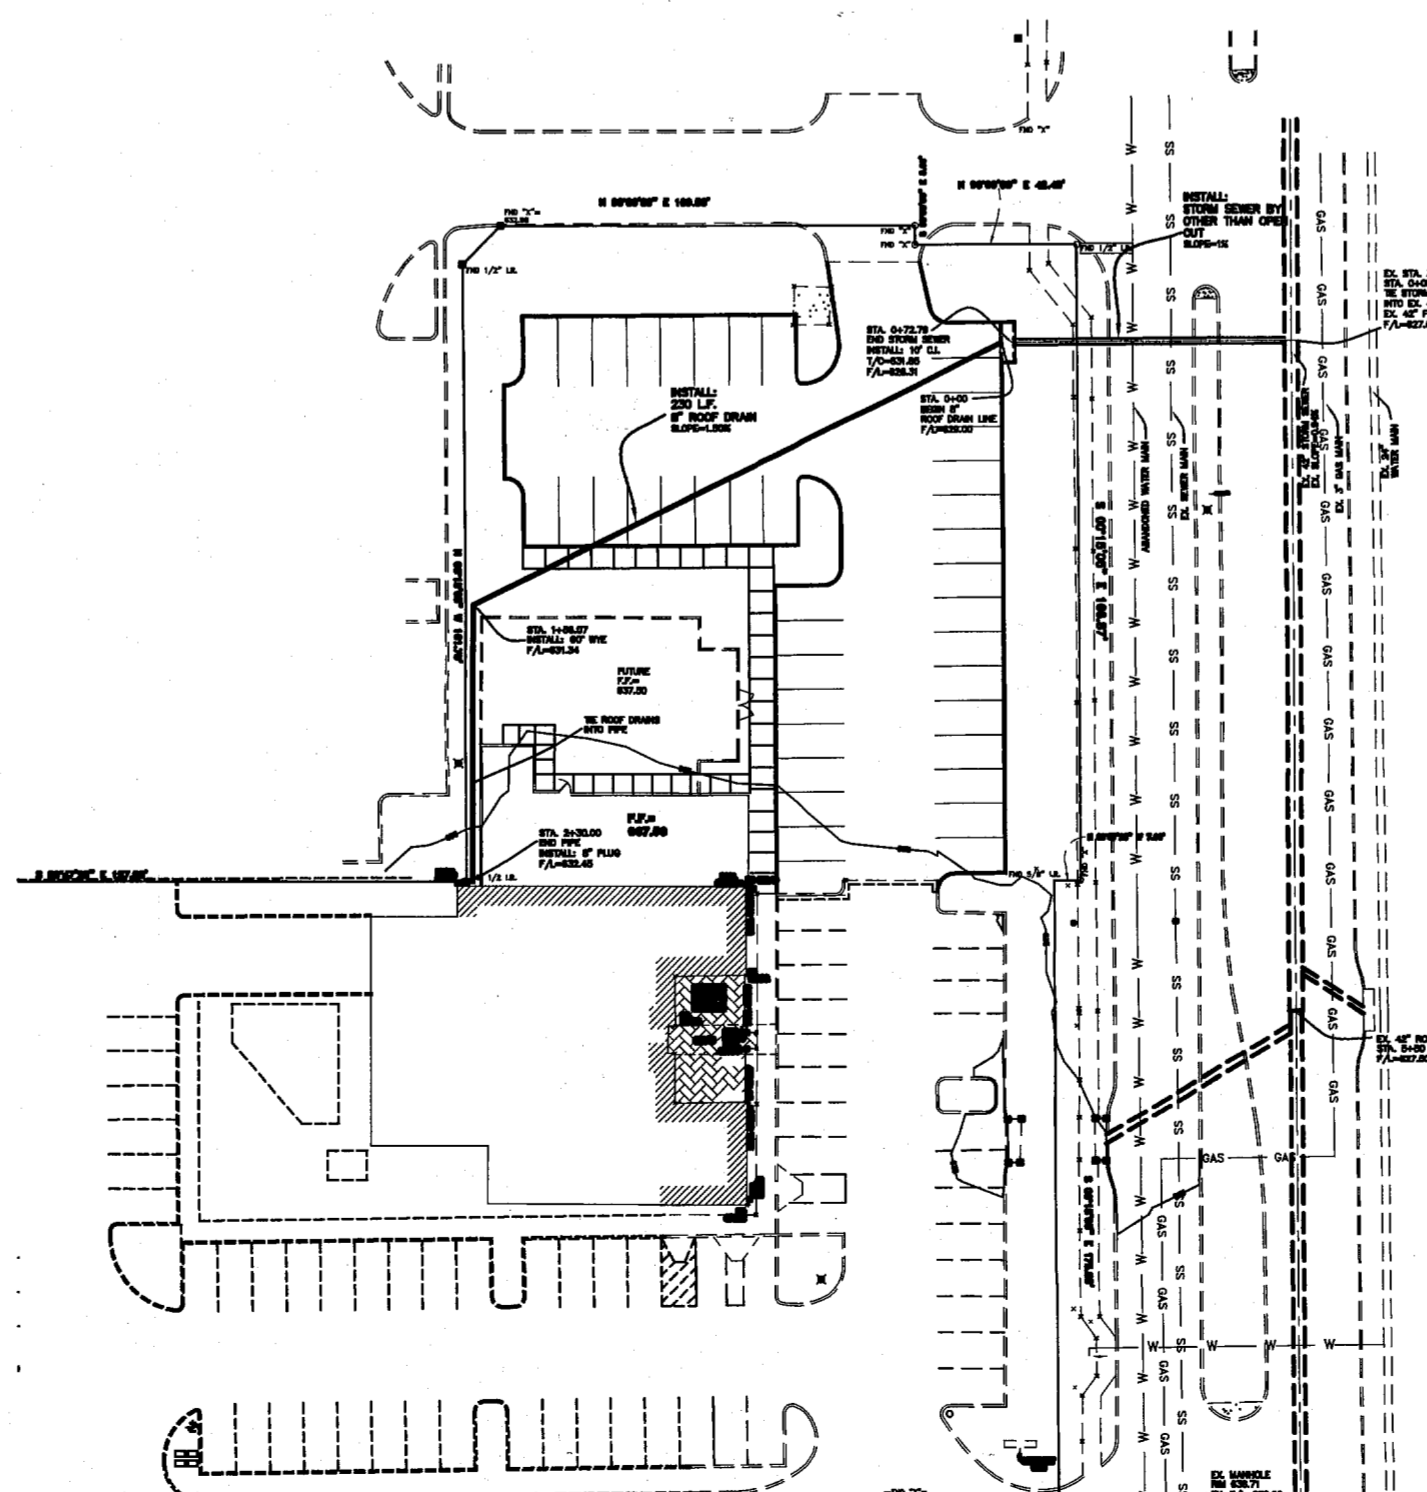

SITE PLAN

IS AN ACCESSIBLE ROUTE REQUIRED BY
TAS WITH THIS REMODEL.

RECEIVED

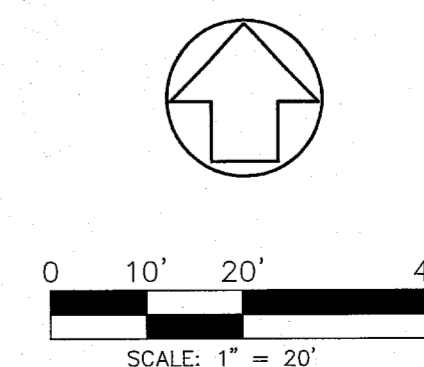


MPE
MICHAEL PEEPLES
Engineers and Planners
(214) 731-9948 (214) 731-9949 (FAX)
1930 E ROSEMEADE PKWY, #207 CARROLLTON, TX 75007

ARTHURS RESTAURANT
QUORUM DRIVE
ADDISON, TEXAS

TOWN OF ADDISON PUBLIC WORKS NO. 2007-014

DATE	COMMENT
01-02-2008	REFLECTS CITY COMMENTS.

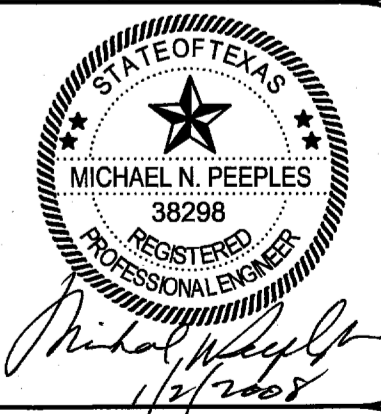

COVER SHEET

SHEET NO.
T-1

DATE: 01-02-2008

2007-14