



HARRIS ADDITION
VOLUME 78017, PAGE 1067
M.R.D.C.T.

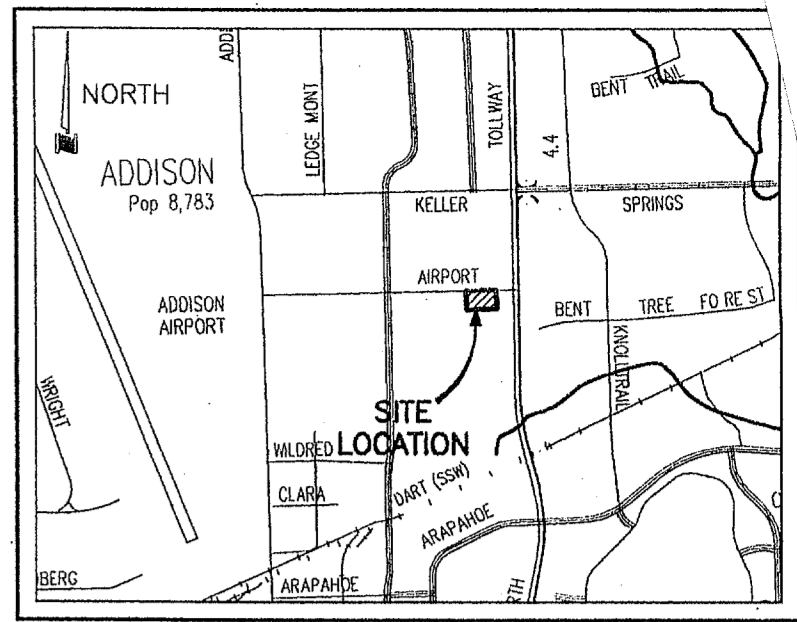

GRAPHIC SCALE

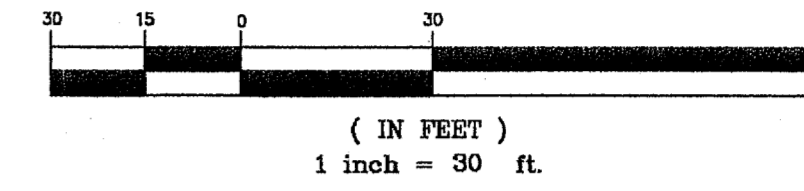


LOCATION MAP
NOT TO SCALE

N45°35'09"E 4.23'

S44°56'29"E 14.22'

AIRPORT PARKWAY
(60' ROW)

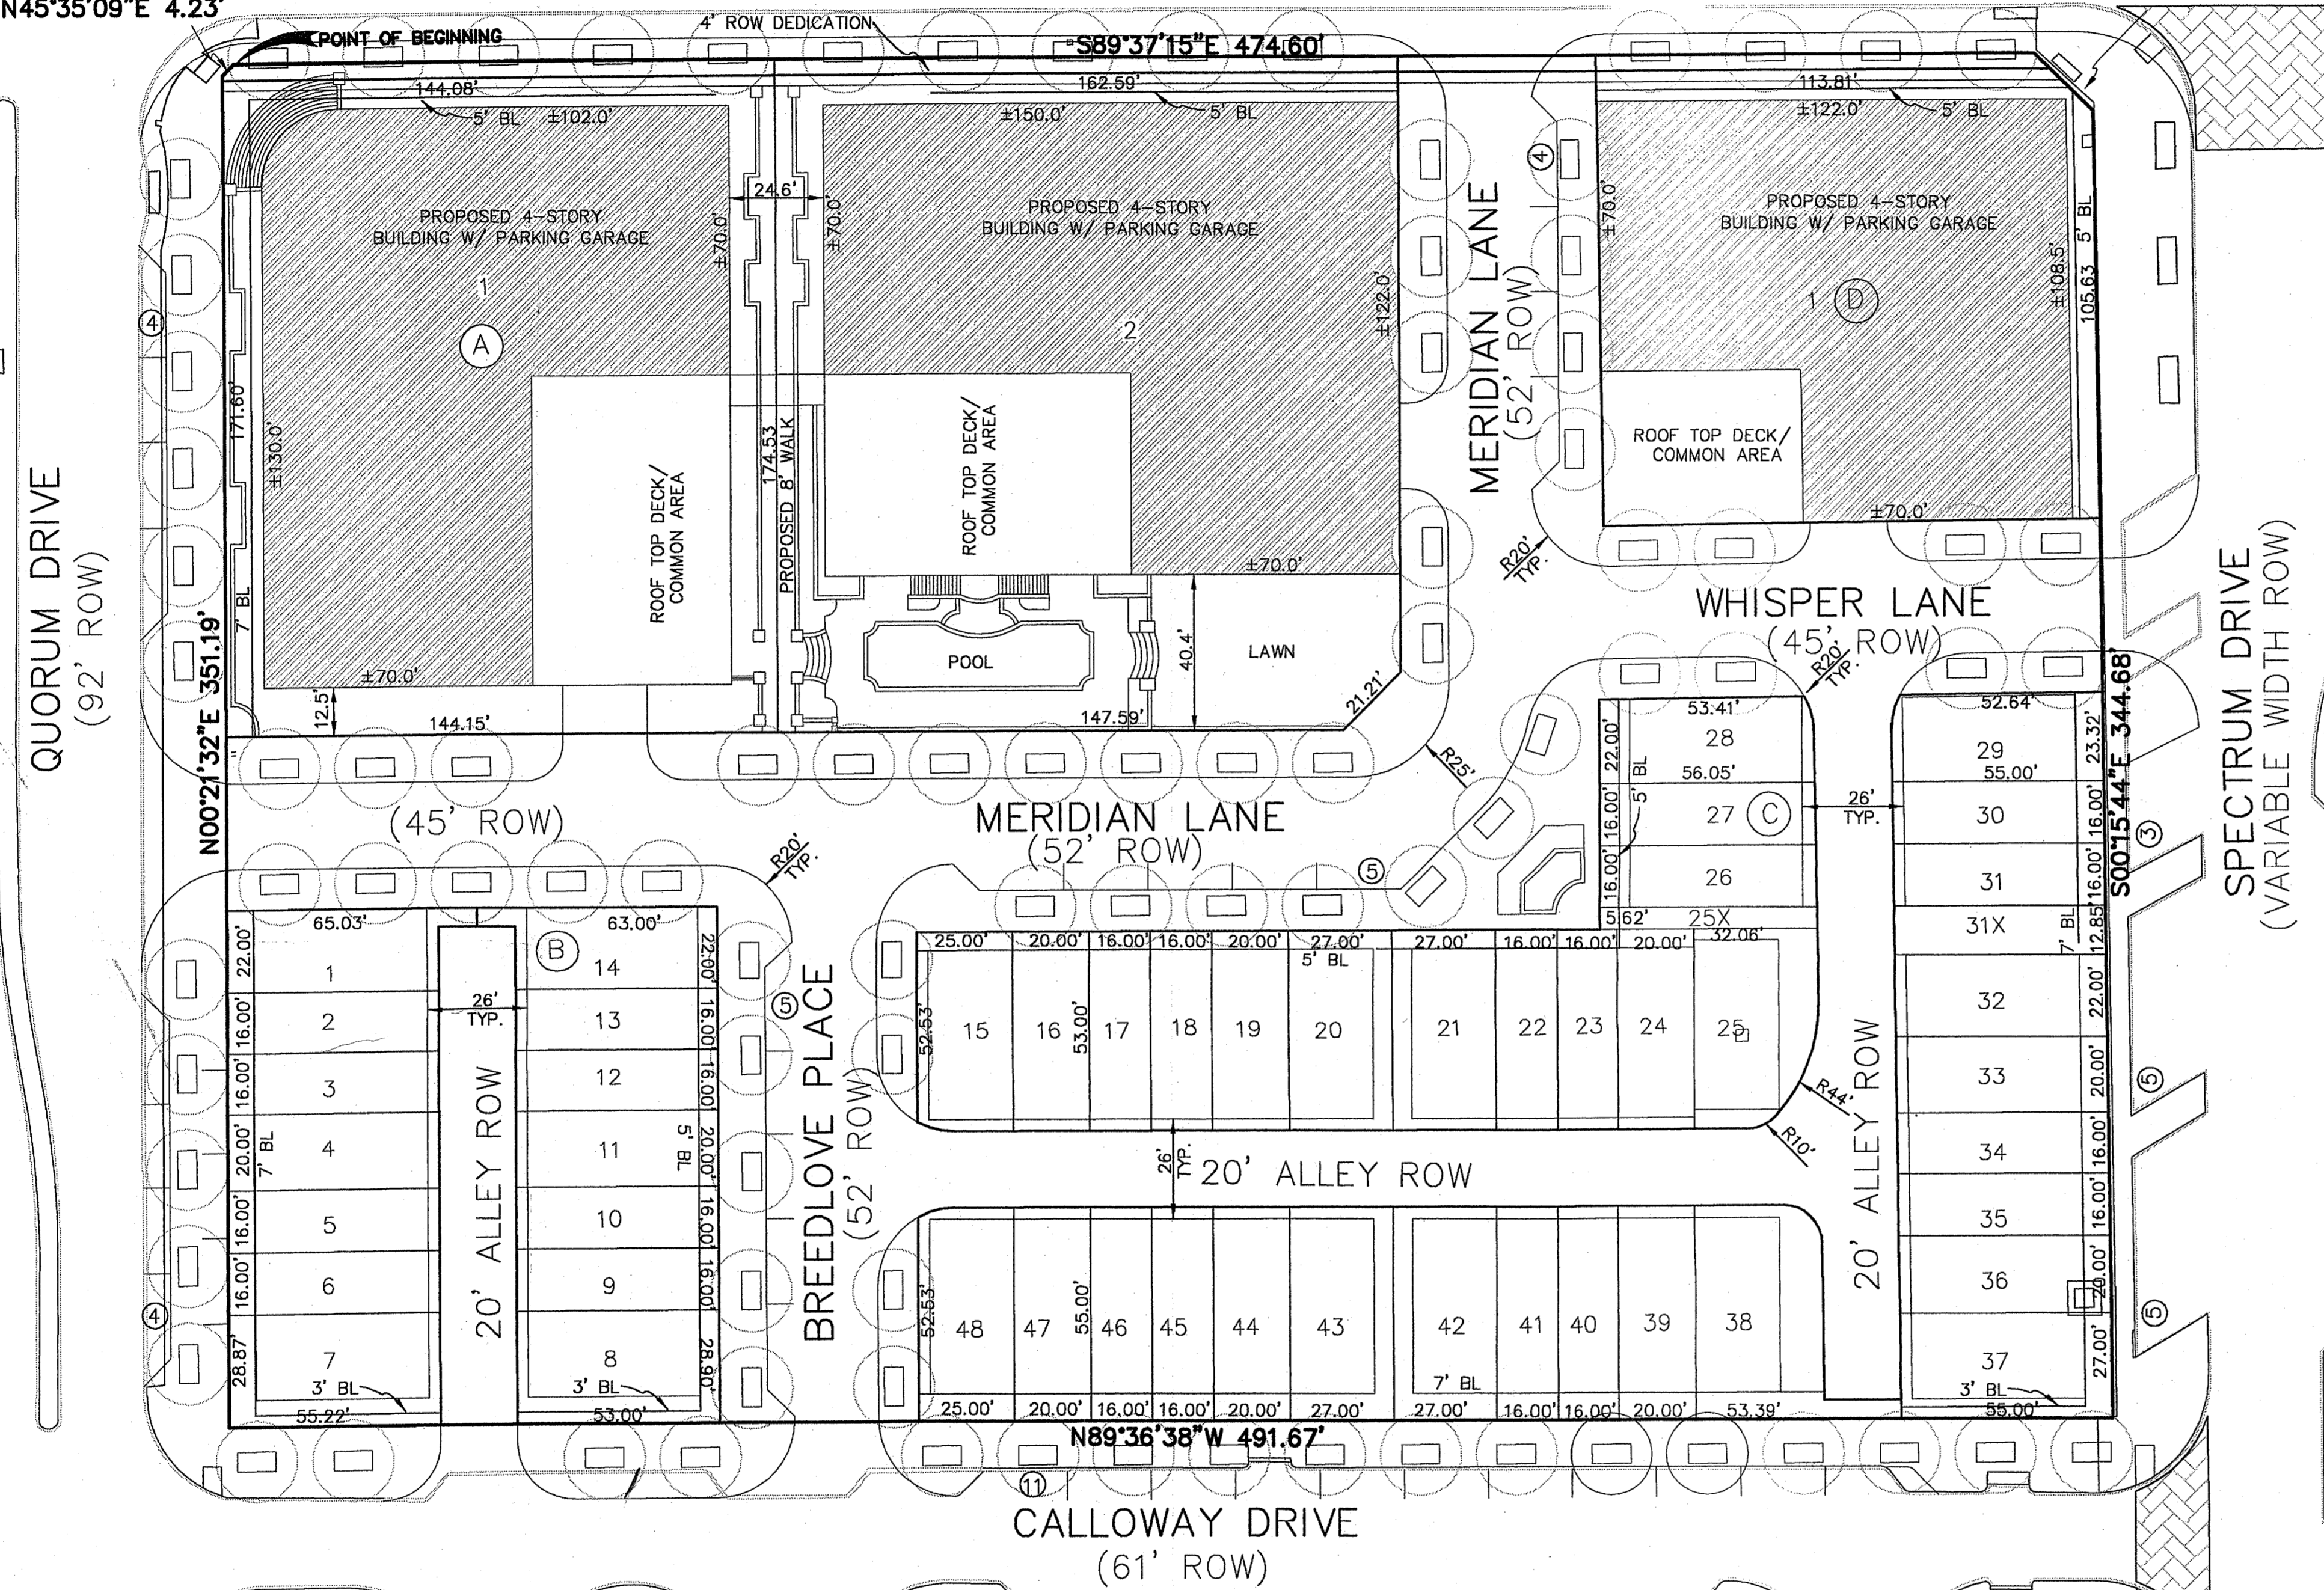

SITE DATA SUMMARY:

- EXISTING ZONING: UC - URBAN CENTER PROPOSED ZONING: UC
- TOTAL SITE AREA - ± 4.0 ACRES
- RESIDENTIAL DWELLINGS: TH-ALLEY ACCESS=48 CONDO-GARAGE ACCESS=92
- RESIDENTIAL DENSITY (DWELLING UNITS/ ACRE): 35.7
- AREA REGULATIONS:

	TH-ALLEY ACCESS:	CONDO-STREET ACCESS:
MIN. LOT WIDTH	16'	-
MIN. LOT DEPTH	47'	-
MIN. LOT AREA	752 SF	-
MAX. LOT COVERAGE	85%	-
MIN. FRONT YARD	5'	5'
MIN. GARAGE SET-BACK	3'	-
MIN. REAR YARD	3'	0'
MIN. DIST. BETWEEN GARAGE FACES	26' (SEE NOTE 7)	N/A
MIN. SIDE YARD	0'	0'
MIN. PERIMETER CORNER SIDE YARD	3'	5'
MIN. BLDG. SEPARATION	10'	20'
MAX. UNITS PER BLDG	8	-
- ON-STREET GUEST PARKING PROVIDED: ±41 or ± 0.3:1


NOTES:

- ALL DIMENSIONS ARE FACE TO FACE UNLESS OTHERWISE NOTED.
- ALL CURB RADII AT STREET INTERSECTIONS ARE 20.0' UNLESS OTHERWISE NOTED.
- THE ARE APPROXIMATELY 140 DWELLING UNITS ASSOCIATED WITH THIS PLAN.
- BRICK LEDGES, 2nd and 3rd FLOOR LIVING AREAS, BALCONY'S, CHIMNEYS AND OTHER ORNAMENTAL PROJECTIONS OR ARCHITECTURAL FEATURES MAY PROJECT IN TO THE FRONT, SIDE AND REAR YARDS A MAXIMUM OF 3 FEET, PROVIDED THEY DO NOT IMPEDE FIRE ACCESS.
- ALL BUILDINGS SHALL NOT BE LESS THAN 10-FEET APART, EXCLUSIVE OF ORNAMENTAL PROJECTIONS OR ARCHITECTURAL FEATURES WHICH SHALL NOT BE LESS THAN 3 FEET APART.
- ALL GARAGE DOORS SHALL NOT BE LESS THAN 26 FEET APART.


HANK, INC.
VOLUME 88060, PAGE 06410
D.R.D.C.T.

15851 DALLAS NORTH PARKWAY ADDITION
VOLUME 85021, PAGE 1686
M.R.D.C.T.

PARK VIEW AT ADDISON CIRCLE
VOLUME 2005032, PAGE 54
M.R.D.C.T.

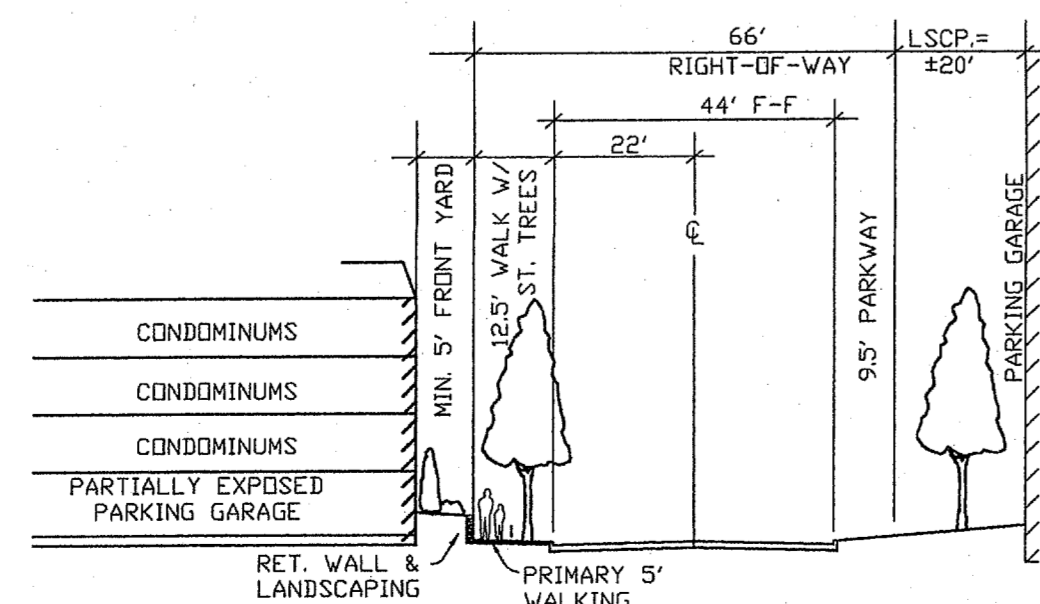

AIRPORT PKWY. SECTION

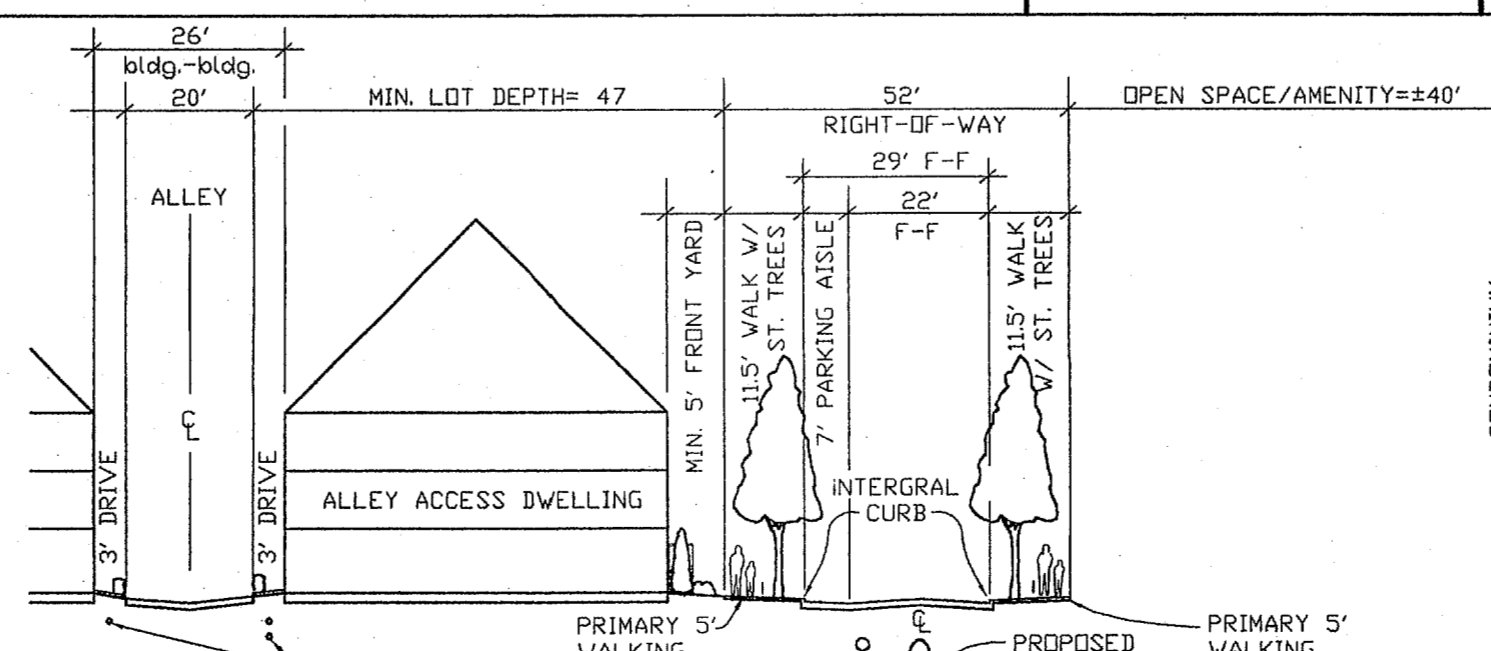

MERIDIAN LANE SECTION

Need to be able to turn around back out of dead end alley.

LAND OWNER:
ADDISON URBAN DEVELOPMENT PARTNERS, LLC
500 W. LOOKOUT ROAD
RICHARDSON, TX 75080
CONTACT: STEVE KING
972.248.2147 OFFICE
972.713.6269 FAX
steve@savannahdevelopers.com

APPLICANT/PLANNER/ENGINEER:
DOWDEY, ANDERSON & ASSOC.
5225 VILLAGE CREEK DRIVE, STE. 200
PLANO, TX 75093
CONTACT: MATTHEW ALEXANDER
972.931.0694, ext. 1129 OFFICE
972.931.9538 FAX
malexander@daa-civil.com

SITE PLAN 148 TH & 92 CONDO'S						
MERIDIAN SQUARE						
8 AC., G.W. FISHER SURVEY, ABSTRACT No. 482						
TOWN OF ADDISON, DALLAS COUNTY, TEXAS						
DOWDEY, ANDERSON & ASSOCIATES, INC. 5225 Village Creek Drive, Suite 200 Plano, Texas 75093 972-931-0694						
DESIGN	DRAWN	CHECKED	DATE	SCALE	JOB	SHEET
MWA	MWA	MWA	07/28/08	1"=30'	07031B	1