


LOT 1, WATSON AND TAYLOR SUBDIVISION - VOL. 78082, PG. 899, M.R.D.C.T.
 PUBLIC STORAGE OF DALLAS, LTD.

2008-02

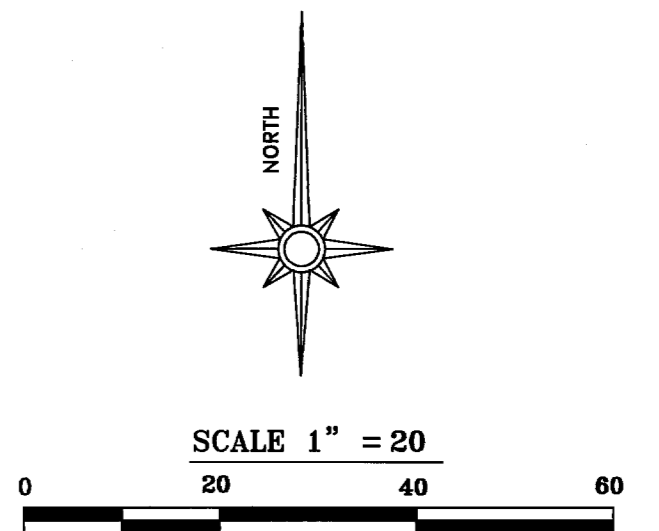

BRITAIN & CRAWFORD
 LAND SURVEYING &
 TOPOGRAPHIC MAPPING
 (817) 928-0211 - METRO (817) 428-5112
 FAX No. (817) 928-9347
 P.O. BOX 11374 - 3008 SOUTH FREEMAN
 FORT WORTH, TEXAS 76110
 EMAIL: admin@britain-crawford.com

TOPOGRAPHIC SURVEY MAP
 OF THE INTERSECTION OF
 ARAPAHO ROAD & SURVEYOR BOULEVARD
 ADDISON, DALLAS COUNTY, TEXAS
 DECEMBER 18, 2008
 REVISED: DECEMBER 23, 2008

LOT 2, WATSON AND TAYLOR SUBDIVISION - VOL. 78082, PG. 899, M.R.D.C.T.
 PUBLIC STORAGE OF DALLAS, LTD.

LOT 2 SURVEYOR ADDITION VOL 77188 PG 1117 MRDCT