

WAREHOUSE ADDITION
38,586 S.F.

EXISTING WAREHOUSE AND OFFICES
51,737 S.F.

Fire Sprinkler and Fire Alarm Systems must conform to applicable NFPA standards. Submit plans to Fire Dept BEFORE installation or modification.

Security / locking system plans shall be reviewed by the Fire Department BEFORE installation.

Provide one fire extinguisher for each 3000 sq. ft. 7 1/2' max. travel distance.

Building fire alarm shall be audible throughout.

Visual notification required in public & common areas.

DISCLAIMER:
THE EXISTING PLAN WAS OWNER FURNISHED TO GSBS. GSBS DOES NOT TAKE RESPONSIBILITY FOR THE ACCURACY AND COMPLETENESS OF THE EXISTING PLAN.

OVERALL FLOOR PLAN A1
SCALE: 1/16" = 1'-0" A1.2


THESE DRAWINGS ARE INCOMPLETE AND MAY NOT BE USED FOR REGULATORY APPROVAL, PERMIT OR CONSTRUCTION.

THOMAS E. BATENHORST
11360

REGISTRATION #: DATE OF ISSUE

UNLESS OTHERWISE SPECIFIED, ALL MEASUREMENTS SHALL BE IN FEET AND INCHES. ALL DIMENSIONS SHALL BE TO FACE UNLESS OTHERWISE SPECIFIED. THE ARCHITECT SHALL BE RESPONSIBLE FOR OBTAINING ALL NECESSARY PERMITS AND APPROVALS FROM THE APPROPRIATE AGENCIES. THE ARCHITECT SHALL BE RESPONSIBLE FOR OBTAINING ALL NECESSARY PERMITS AND APPROVALS FROM THE APPROPRIATE AGENCIES. THE ARCHITECT SHALL BE RESPONSIBLE FOR OBTAINING ALL NECESSARY PERMITS AND APPROVALS FROM THE APPROPRIATE AGENCIES.

No.	DATE	REVISION

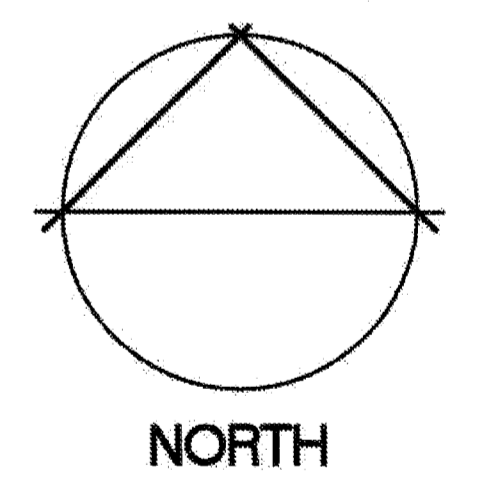

BEST PRESS, INC.

4201 AIRBORN DR.
ADDISON, TX 75001

DESIGN DOCUMENTS

OVERALL FLOOR PLAN

PROJECT NO: 2007-T52-00
DATE: FEBRUARY 2008
DRAWN: **A1.2**

CHECKED: BINDING ORDER