
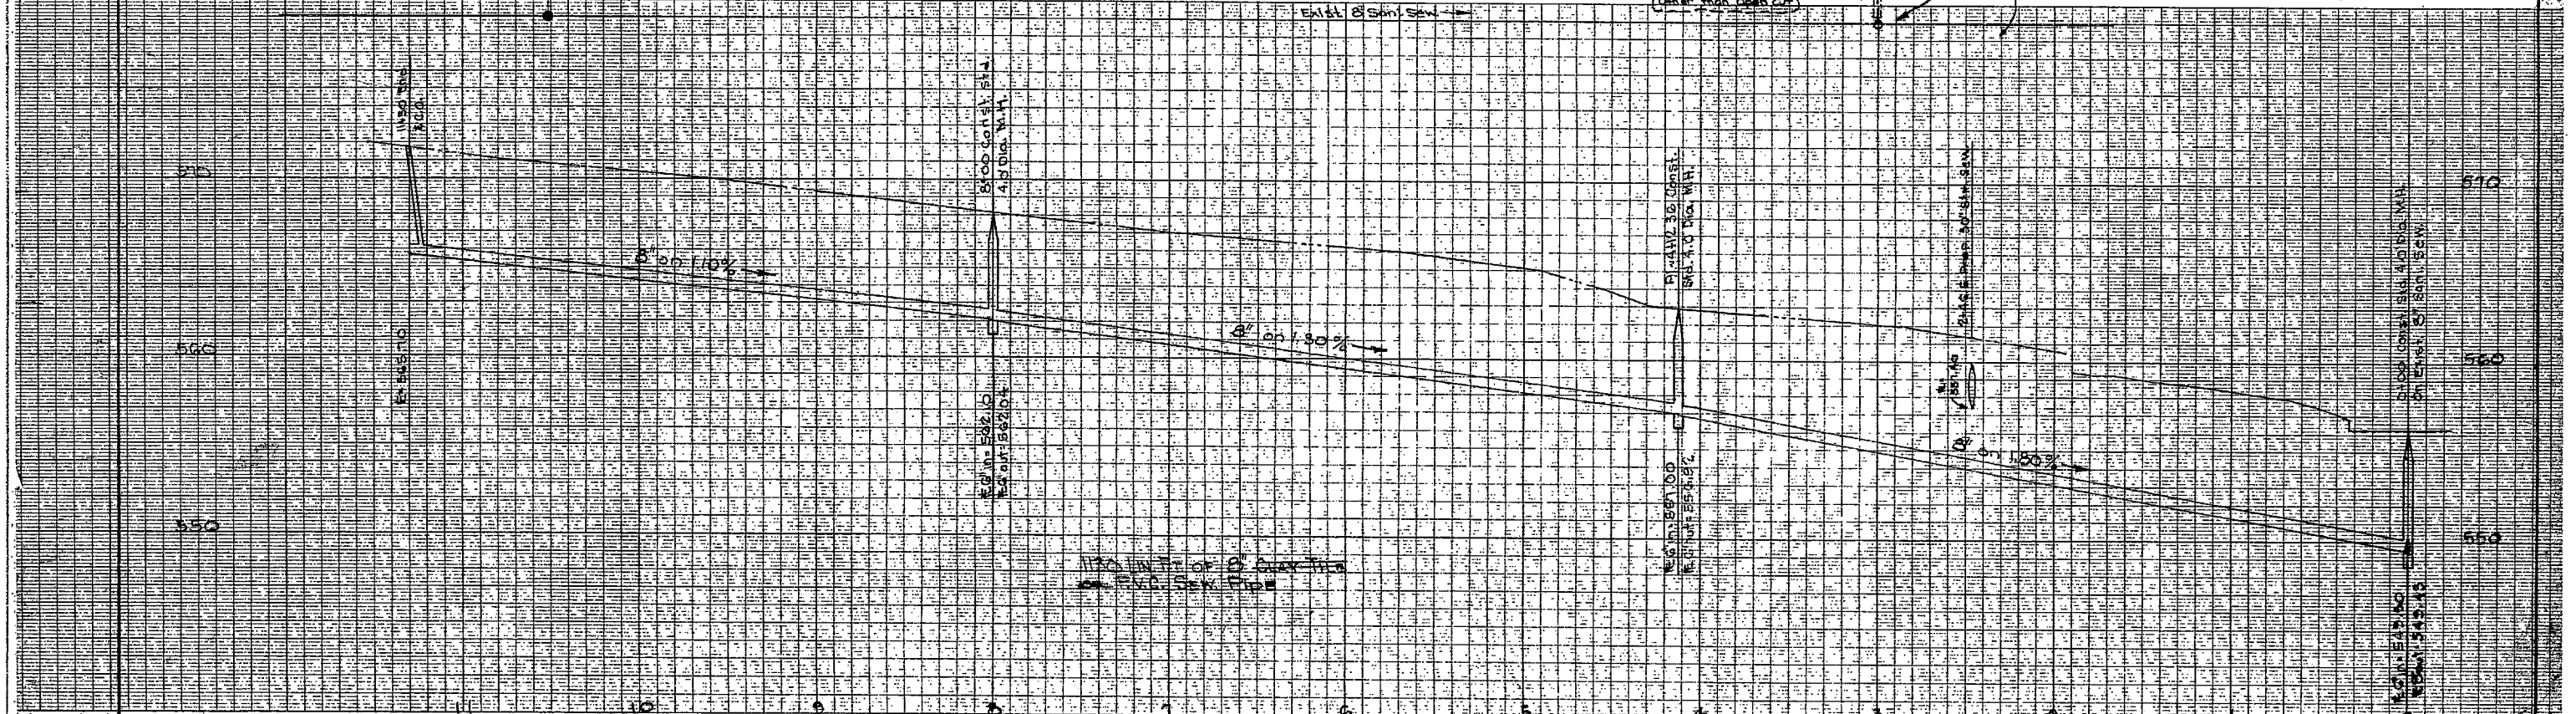


A

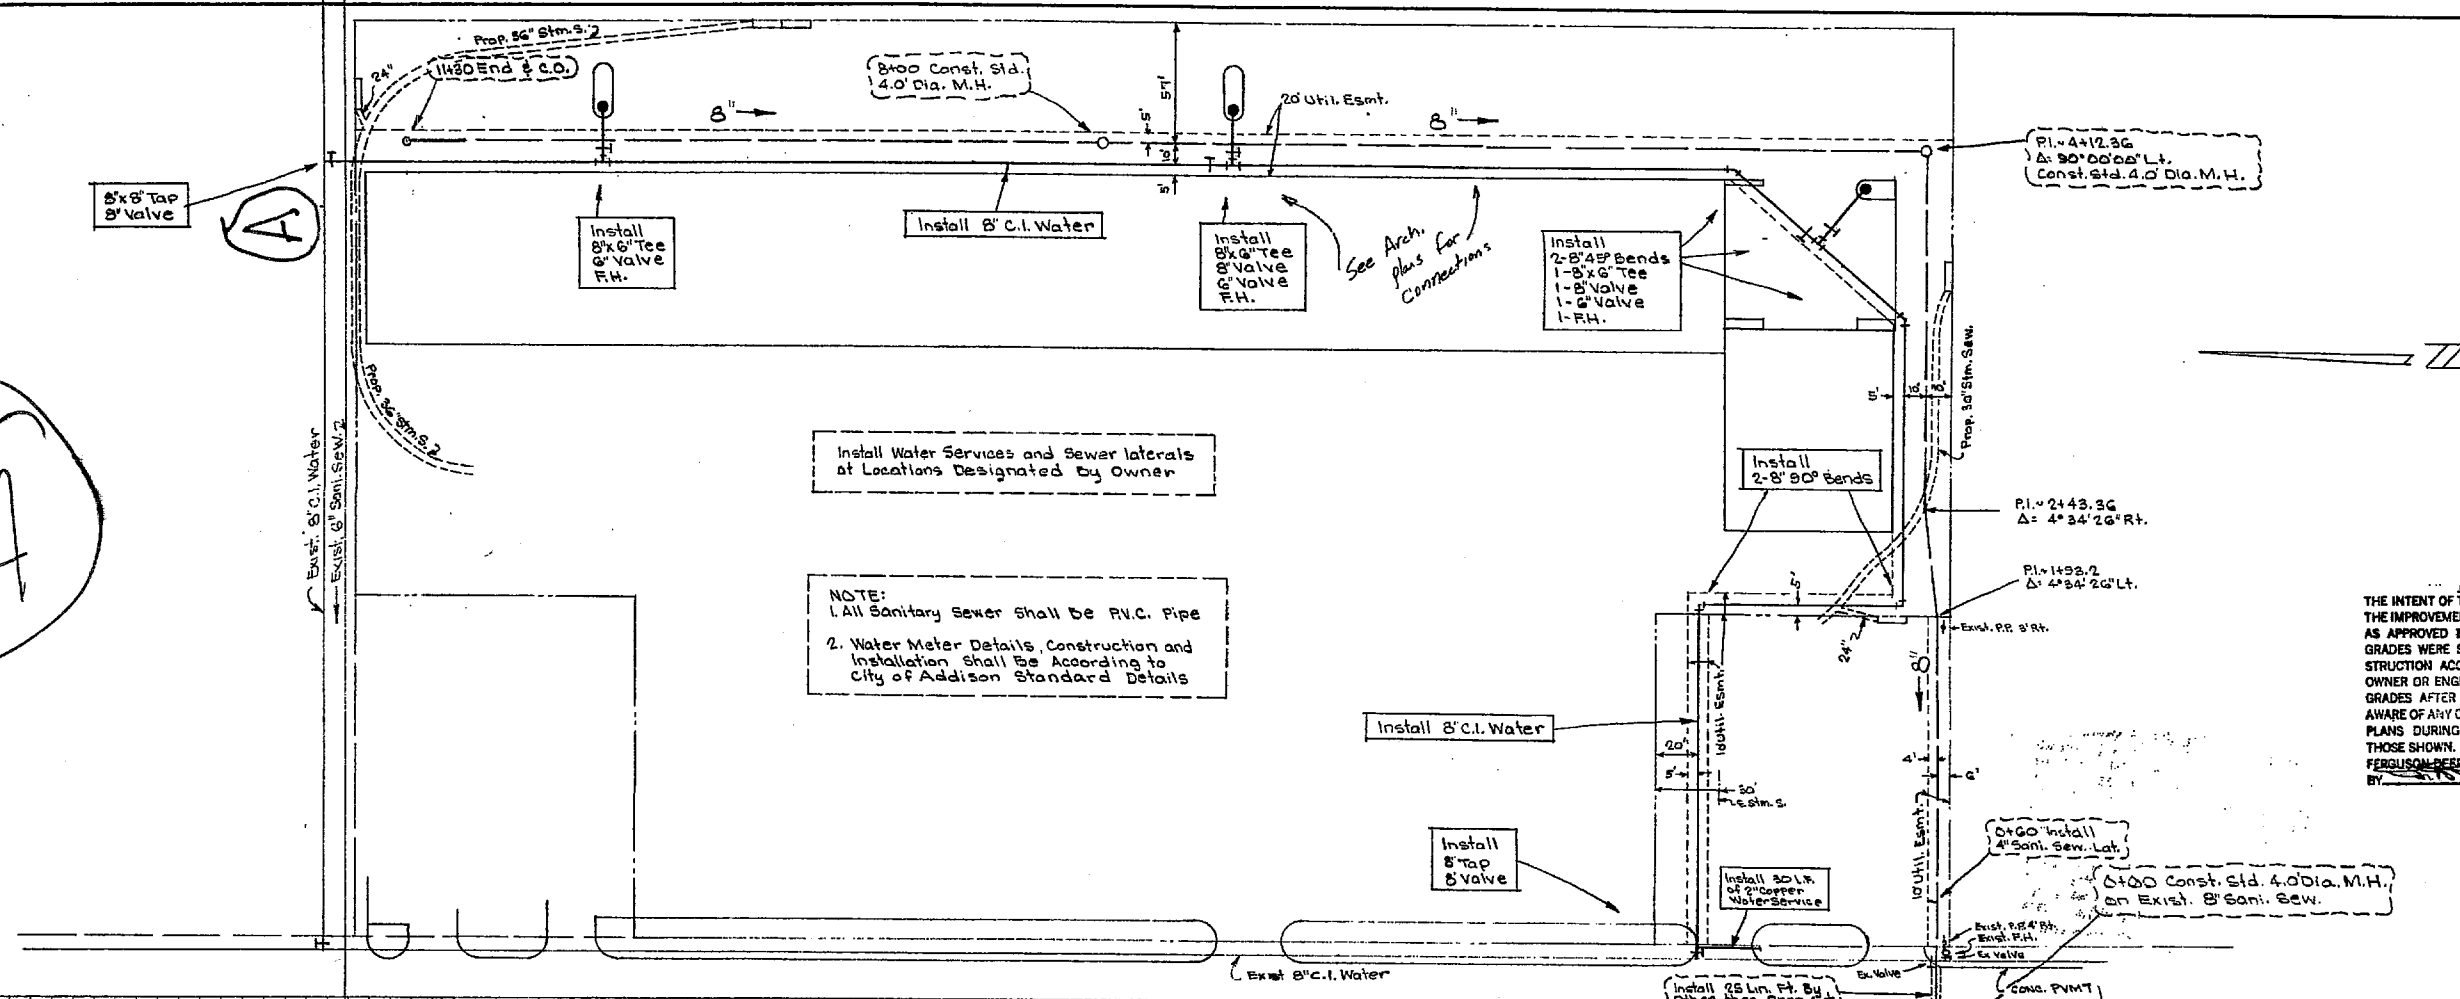

NO. 1265-PLAN PROFILE PLATE A  
"CLEARPRINT PAPER CO."  
MADE IN U.S.A.

REVISED BY	DATE	COMMENT
B.G.	5/29/85	P.V.C. Pipe & Water meter Note Added

FERGUSON-DEERE, INC. CONSULTING ENGINEERS 887 KINGSLEY ROAD DALLAS, TEXAS 75238 PHONE 348-2821 DATE OCT. 15, 1984	<b>WATER &amp; SEWER MAINS</b> <b>GREENHAVEN VILLAGE</b> <b>SHOPPING CTR. ADDITION</b>	SCALE 1" = 10' SHEET NO. 0511
	AS BUILT PLANS THE INTENT OF THE OWNER WAS TO CONSTRUCT THE IMPROVEMENTS ACCORDING TO THESE PLANS AS APPROVED BY THE CITY. THE LINES AND GRADES WERE SET ON THE GROUND FOR CONSTRUCTION ACCORDING TO SAID PLANS. THE OWNER OR ENGINEER DID NOT VERIFY LINES OR GRADES AFTER CONSTRUCTION. WE ARE NOT AWARE OF ANY CHANGES OR REVISIONS TO THESE PLANS DURING CONSTRUCTION OTHER THAN THOSE SHOWN FERGUSON-DEERE, INC. DATE 1/22/86	
	APPROXIMATE LOCATION OF EXISTING P.V.C. SANITARY PIPE	