


Bact samples taken

B

Tom Thumb

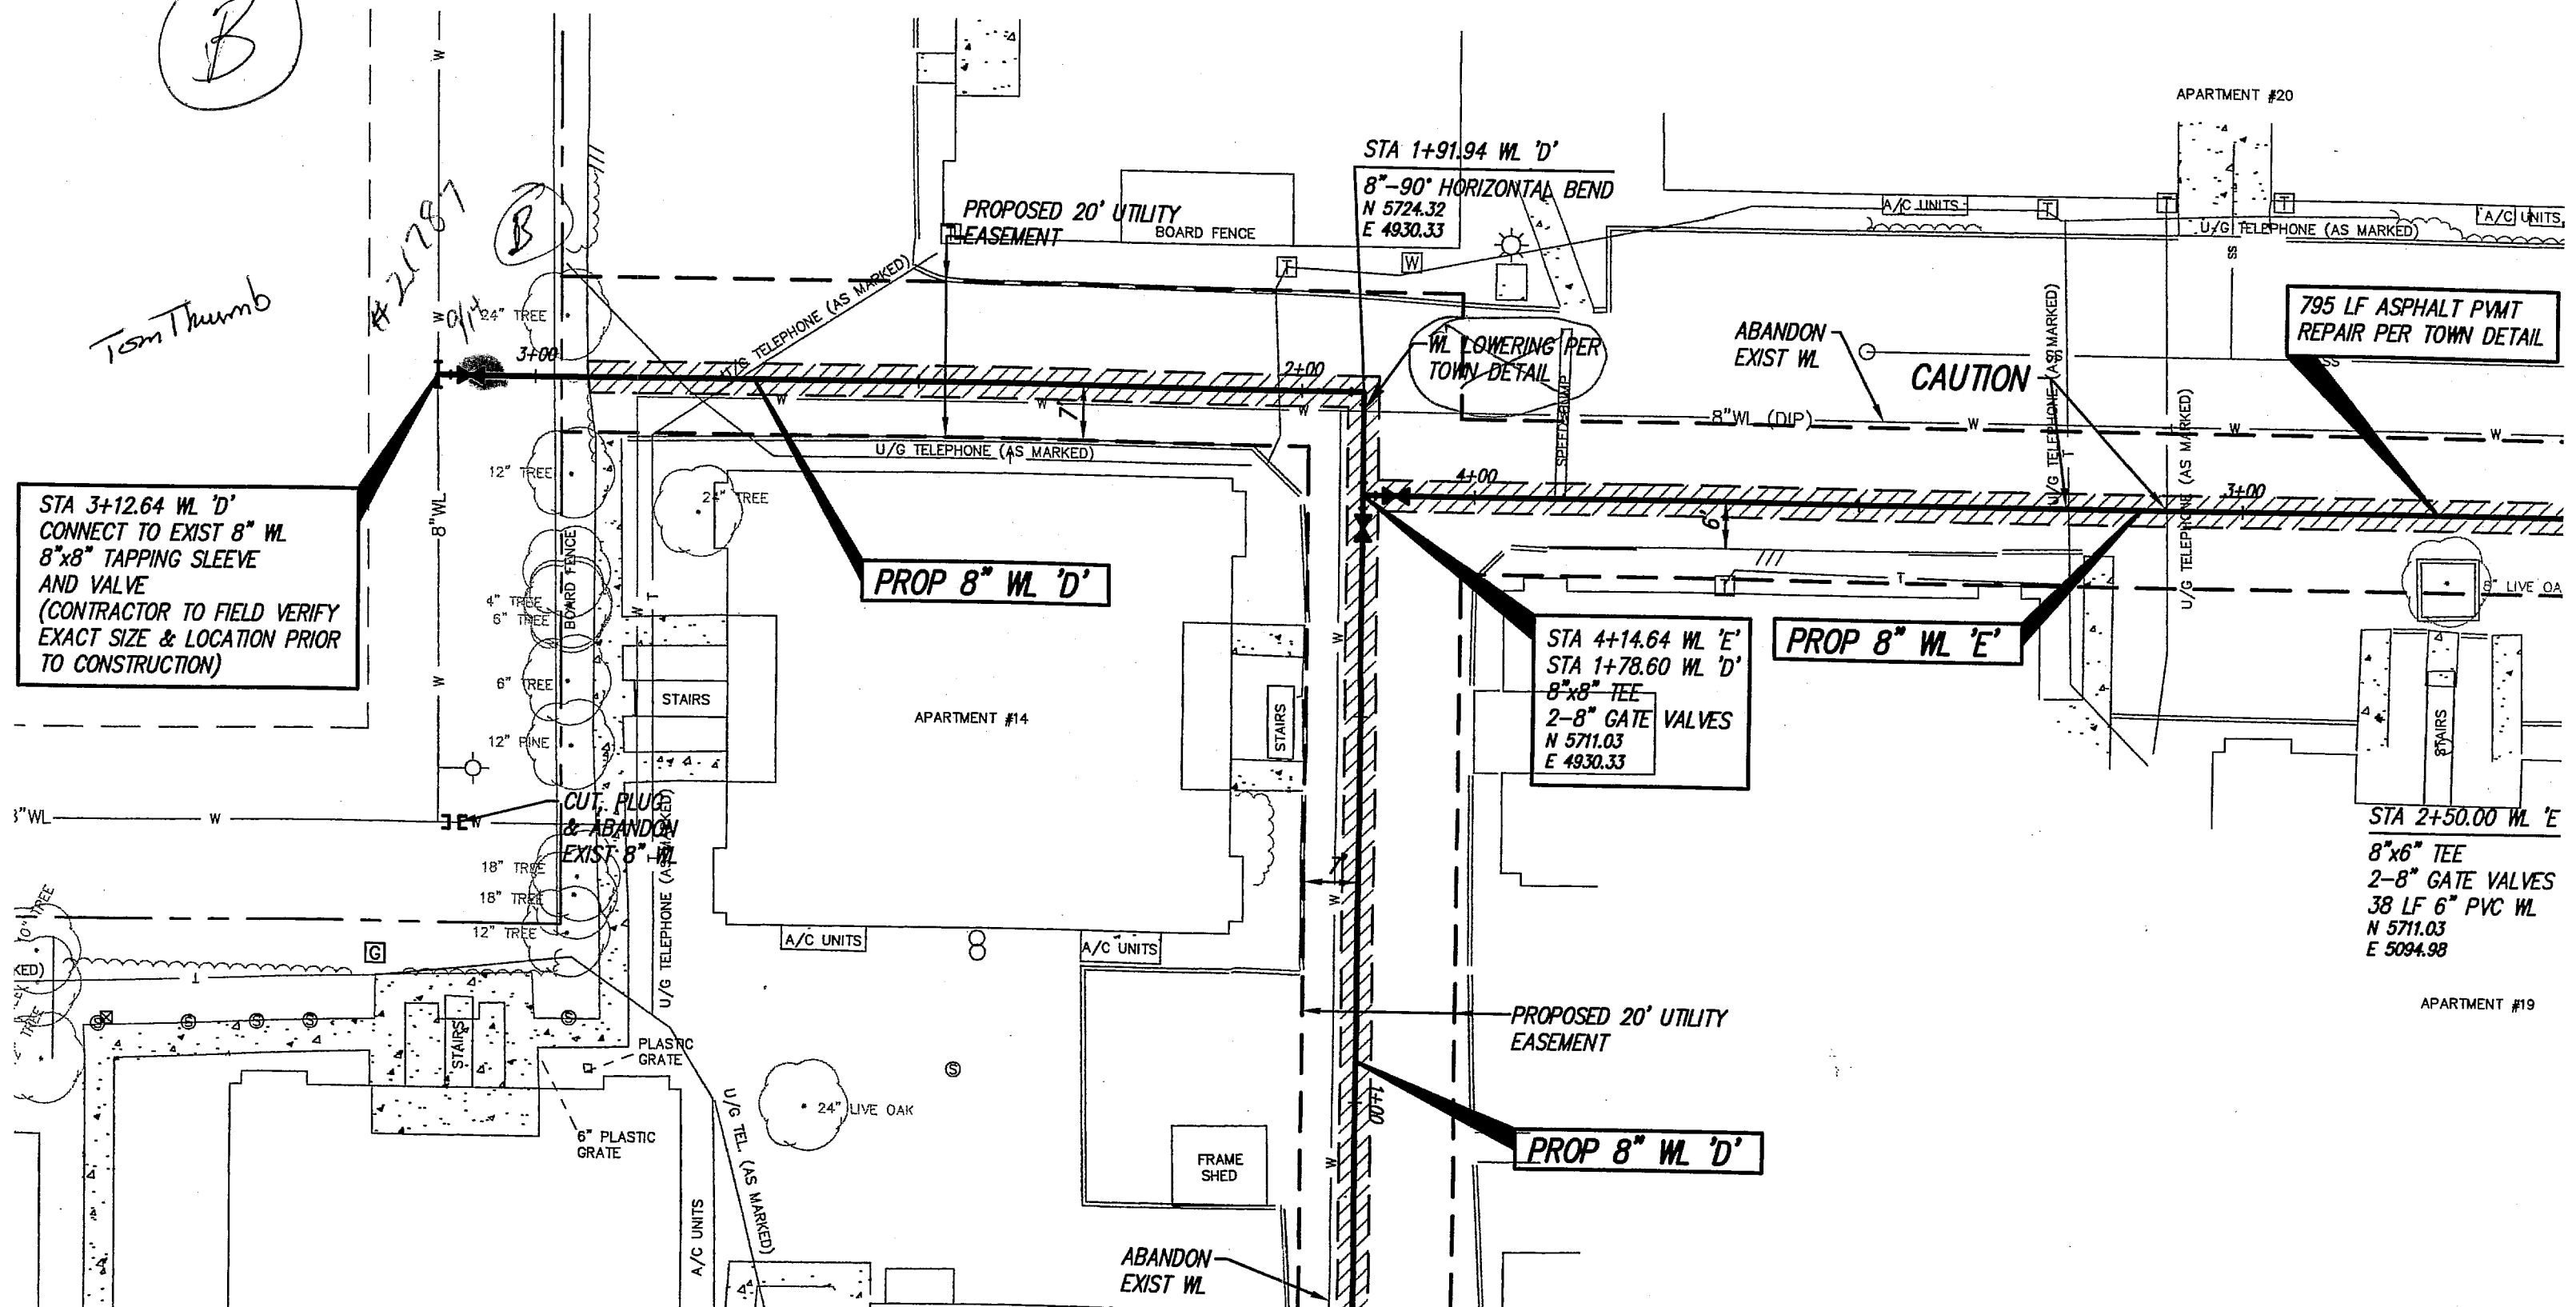

STA 3+12.64 WL 'D'  
 CONNECT TO EXIST 8" WL  
 8"x8" TAPPING SLEEVE  
 AND VALVE  
 (CONTRACTOR TO FIELD VERIFY  
 EXACT SIZE & LOCATION PRIOR  
 TO CONSTRUCTION)

PROP 8" WL 'D'

STA 1+91.94 WL 'D'  
 8"-90° HORIZONTAL BEND  
 N 5724.32  
 E 4930.33

WL LOWERING PER  
 TOWN DETAIL

STA 4+14.64 WL 'E'  
 STA 1+78.60 WL 'D'  
 8"x8" TEE  
 2-8" GATE VALVES  
 N 5711.03  
 E 4930.33

PROP 8" WL 'E'

795 LF ASPHALT PVMT  
 REPAIR PER TOWN DETAIL

STA 2+50.00 WL 'E'  
 8"x6" TEE  
 2-8" GATE VALVES  
 38 LF 6" PVC WL  
 N 5711.03  
 E 5094.98

PROP 8" WL 'D'

APARTMENT #19

APARTMENT #20

APARTMENT #14

PROPOSED 20' UTILITY  
 EASEMENT

PROPOSED 20' UTILITY  
 EASEMENT

ABANDON  
 EXIST WL

ABANDON  
 EXIST WL

CAUTION

CUT, PLUG  
 & ABANDON  
 EXIST 8" WL

6" PLASTIC  
 GRATE

FRAME  
 SHED

U/G TEL. (AS MARKED)

U/G TELEPHONE (AS MARKED)

24" LIVE OAK

18" TREE

18" TREE

12" TREE

6" TREE

6" TREE

4" TREE

12" TREE

12" TREE

