


1" = 20'

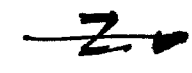

CP


N 11433.5057  
E 10117.0441  
STA. 16+22.66  
FURNISH & INSTALL:  
1 - 8"x6" TEE (UP)  
1-6" 90° BEND  
1 - 8" R.S.G.V. VALVE  
1 - 6" R.S.G.V. VALVE  
18 L.F. 6" P.V.C. WATER LINE  
1 - STD. FIRE HYDRANT  
RELOCATE SPRINKLER HEAD TO ACCOMMODATE FIRE HYDRANT IN CENTER OF ISLAND.

N 11452.8440  
E 10117.4342  
STA. 16+42.01  
CENTER WATER LINE PIPE LENGTH OVER EXIST. SAN. SEW. REMOVE 18 L.F. OF EXIST. 6" SAN. SEW. PIPE AND REPLACE WITH ASTM 2241 P.V.C. SANITARY SEWER PIPE W/ CLASS "H" EMBEDMENT CENTERED ON WATER LINE

N 11465.8355, E 10117.6962  
STA. 16+55, FURNISH & INSTALL:  
1 - 8"x8" TEE  
1 - 8" 90° BENDS  
1 - 8" R.S.G.V.  
3 - 8" PLUGS  
3 - CUT & PLUG EXIST. W.L. (EAST)  
22.5 L.F. 8" P.V.C. WATER LINE  
CUT INTO EXIST. 8" W.L. (EAST)  
Tapping sleeve

N 11608.2418  
E 10121.9726  
STA. 17+97.47  
FURNISH & INSTALL:  
1 - 8"x6" TEE (UP)  
1-6" 90° BEND  
1 - 6" R.S.G.V. VALVE  
15 L.F. 6" P.V.C. WATER LINE  
1 - STD. FIRE HYDRANT  
REMOVE & DELIVER TO TOWN'S SERVICE CENTER EXISTING FIRE HYDRANT & VALVE TOP & COVER  
ABANDON EXIST. 6" VALVE IN PLACE

# MARSH LAN

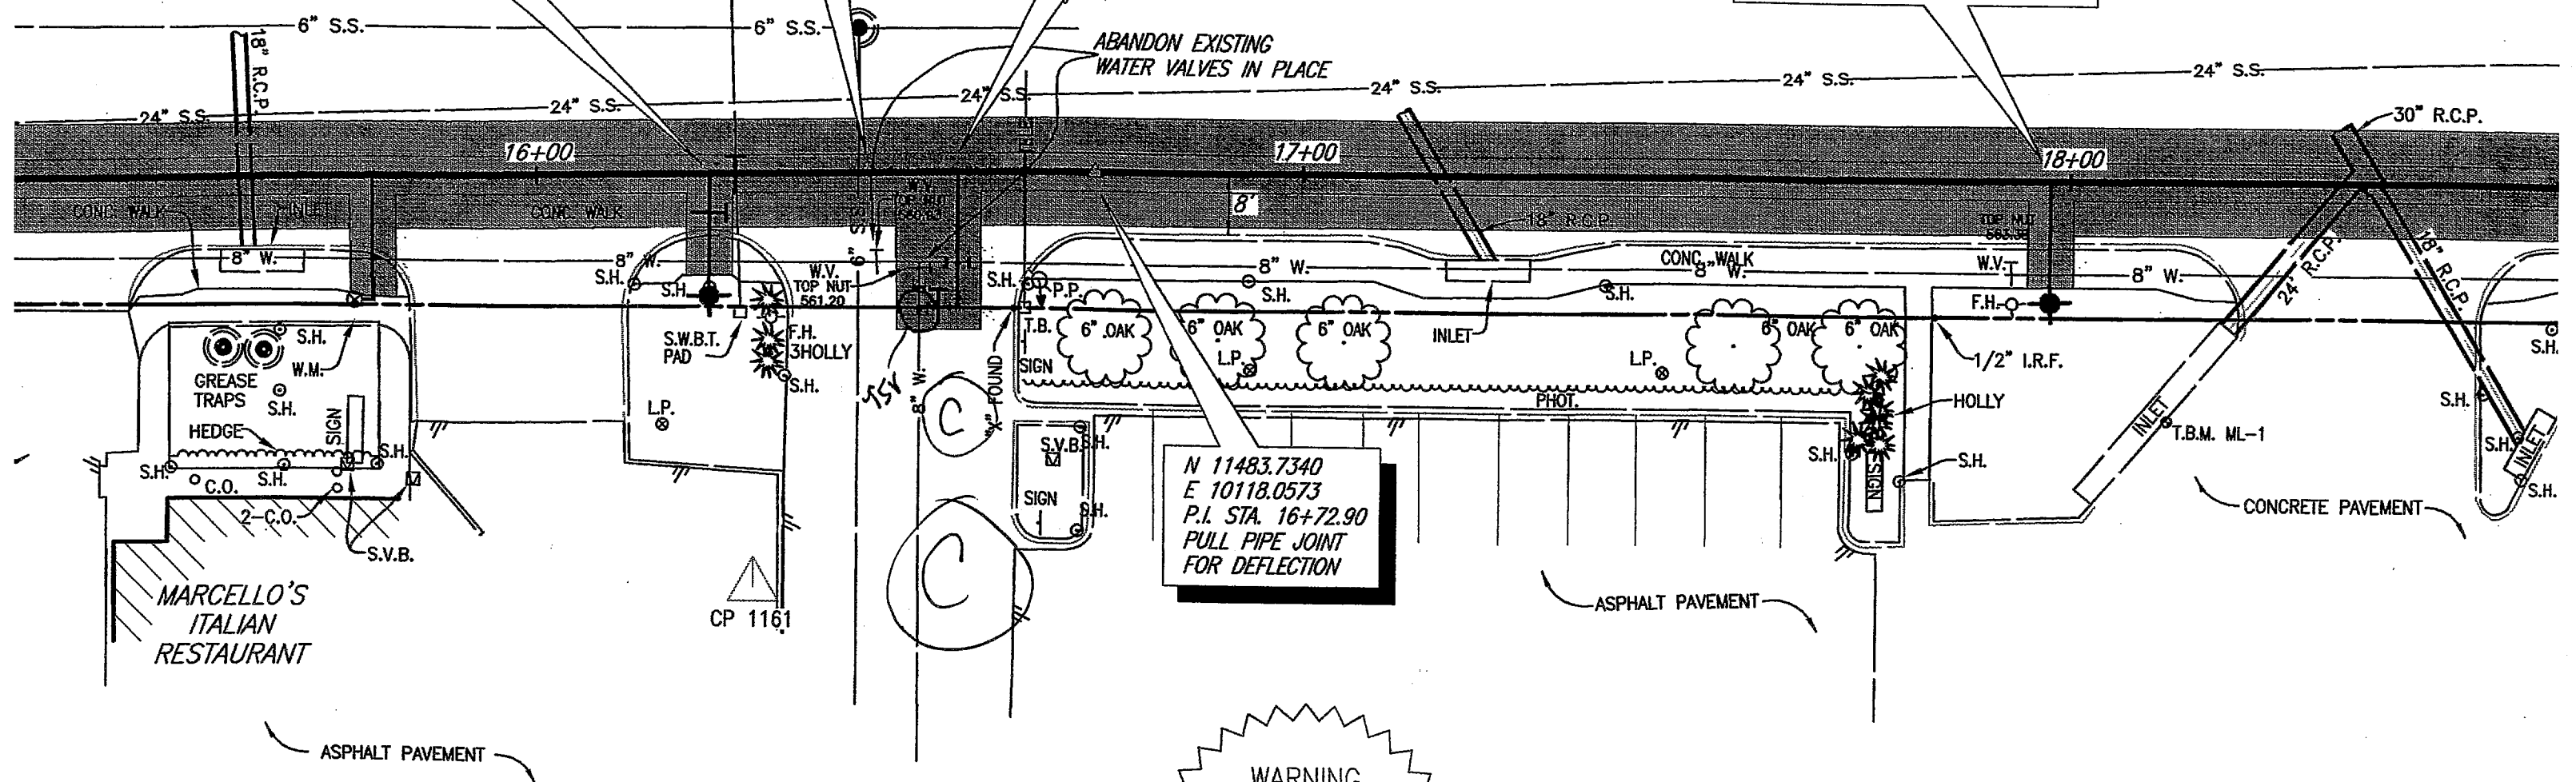

N 11483.7340  
E 10118.0573  
P.I. STA. 16+72.90  
PULL PIPE JOINT FOR DEFLECTION

**WARNING**  
S.W. BELL BURIED TELEPHONE CABLE  
CALL ENTERPRISE 9800  
72 HOURS PRIOR TO EXCAVATION IN VICINITY OF STA. 16+26 & STA. 16+63

ES:  
CONTRACTOR TO PROTECT INLETS ALONG MARSH LANE.  
COORDINATES ARE PROJECT SPECIFIC AND NOT STATE PLANE RELATED.

CONTRACTOR SHALL FURNISH & INSTALL NEW METER BOXES FOR EACH WATER SERVICE IN THE RIGHT-OF-WAY. EXISTING METER BOXES SHALL BE REMOVED AND WATER SERVICE

WATER SERVICES	
LOCATION	PROP. 2" SERVICE (L.F.)
STA. 15+78.64 RT.	18.0
FURNISH & INSTALL: PROP. 2" OUTLET, 2" TYPE K COPPER, METER BOX AND DOUBLE CHECK VALVE ASSEMBLY. CONNECT TO EXISTING WATER LINE AT EACH WATER SERVICE	

BENCI