



ADV-D1  
(ITEM NO. 136)

6" U.C. WHITE LETTERS  
4-1/2" L.C. WHITE LETTERS  
5" U.C. WHITE LETTERS (DIRECTION)  
ON GREEN BACKGROUND  
8' X 7' PANEL

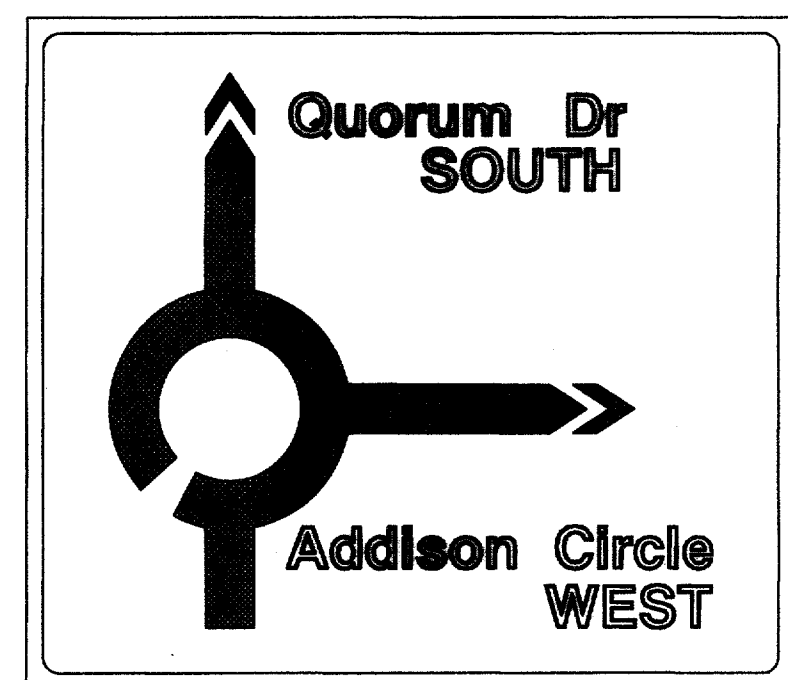


ADV-D2  
(ITEM NO. 136)

6" U.C. WHITE LETTERS  
4-1/2" L.C. WHITE LETTERS  
5" U.C. WHITE LETTERS (DIRECTION)  
ON GREEN BACKGROUND  
8' X 7' PANEL

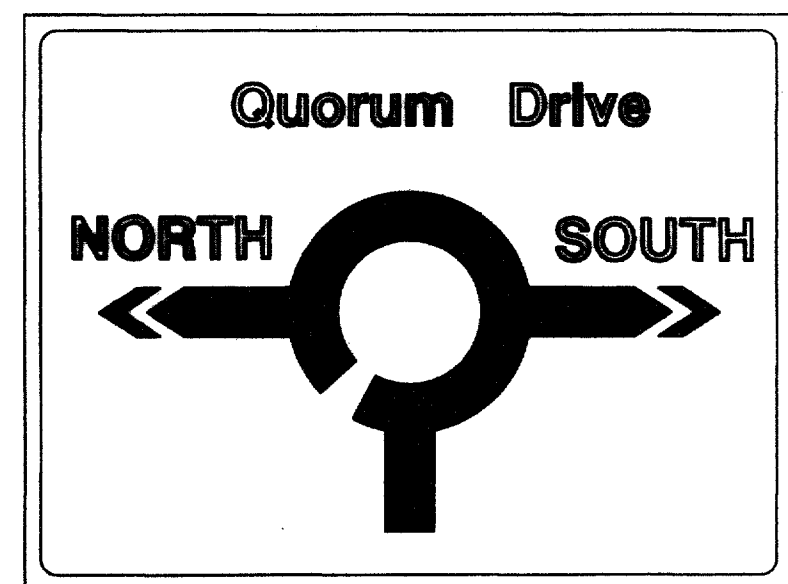


ADV-D3  
(ITEM NO. 137)

6" U.C. WHITE LETTERS  
4-1/2" L.C. WHITE LETTERS  
5" U.C. WHITE LETTERS (DIRECTION)  
ON GREEN BACKGROUND  
8' X 6' PANEL

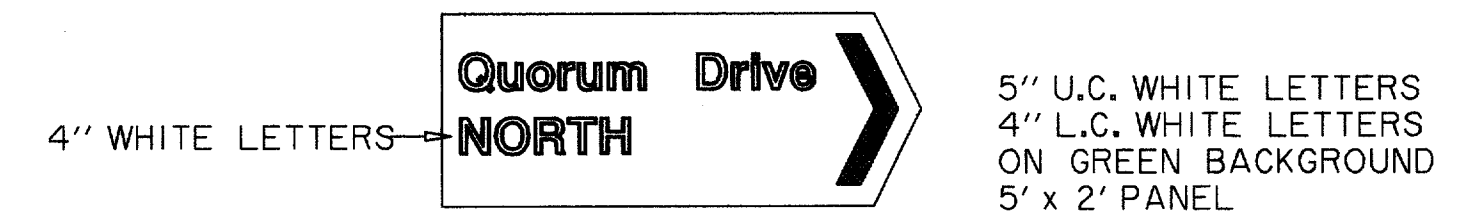


ST-1  
(ITEM NO. 138)

5" U.C. WHITE LETTERS  
4" L.C. WHITE LETTERS  
ON GREEN BACKGROUND  
5' X 2' PANEL

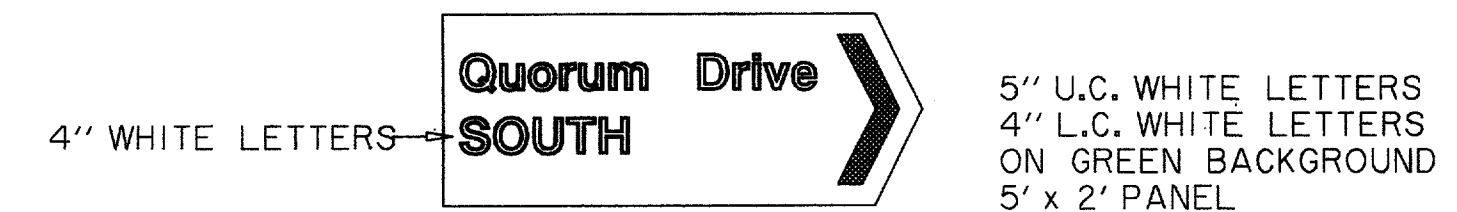


ST-2  
(ITEM NO. 138)

5" U.C. WHITE LETTERS  
4" L.C. WHITE LETTERS  
ON GREEN BACKGROUND  
5' X 2' PANEL

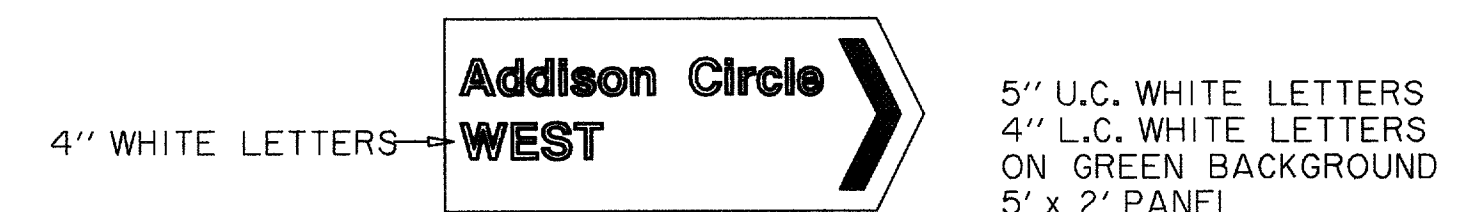

ST-3  
(ITEM NO. 138)

5" U.C. WHITE LETTERS  
4" L.C. WHITE LETTERS  
ON GREEN BACKGROUND  
5' X 2' PANEL

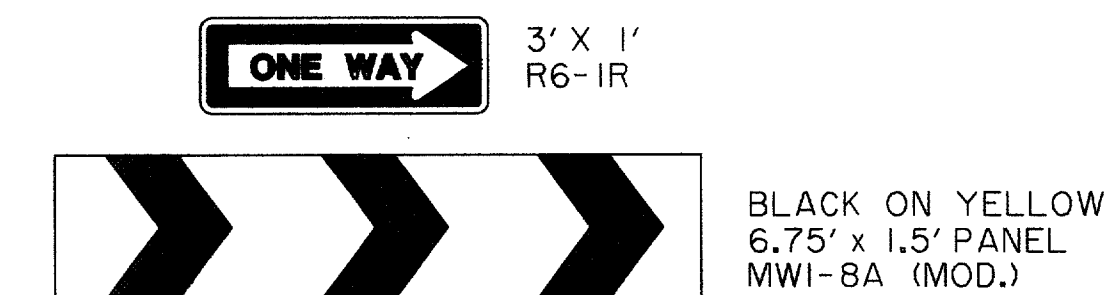


W-CHEV WITH RIO  
(ITEM NO. 125)

ON CENTRAL ISLANDS  
OPPOSITE EVERY ENTRY

3' X 1'  
R6-1R

BLACK ON YELLOW  
6.75' X 1.5' PANEL  
MWI-8A (MOD.)

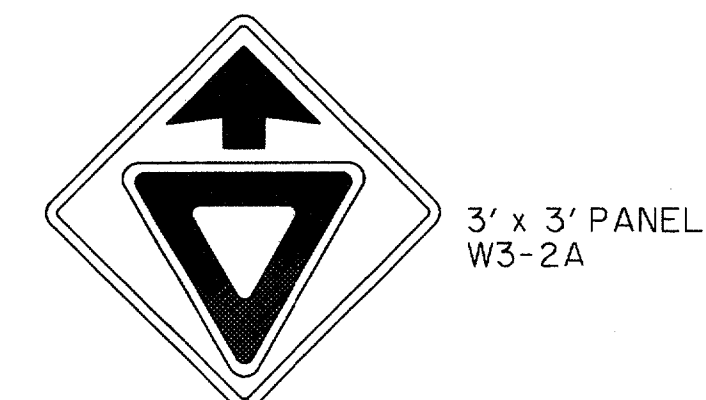

RI-2  
(ITEM NO. 125)

3' X 3' PANEL  
W3-2A

4" BLACK LETTERS  
4' X 18" PANEL  
ADV-D4

ADDENDUM #3 1/26/96

RECORD DRAWING 5/1/98

ISSUED FOR CONSTRUCTION  
MARCH 28, 1996

THE SEAL APPEARING ON THIS  
DOCUMENT WAS AUTHORIZED BY  
KENNETH A. ROBERTS, P.E. 55446  
ON MARCH 28, 1996.



TRAFFIC SIGN DETAILS						
ADDISON CIRCLE						
PHASE I PUBLIC INFRASTRUCTURE						
TOWN OF ADDISON, TEXAS						
Huitt-Zollars, Inc./Engineering/Architecture Dallas, Fort Worth, Houston, El Paso, Phoenix, Tustin, Ontario, San Clemente						
DESIGN	DRAWN	APPR.	SCALE	DATE	PROJECT NO.	NO.
HZI	HZI	KAR	N.T.S.	JAN 96	1822-04	17A 137