

PLANS FOR CONSTRUCTION OF
PAVING, DRAINAGE AND UTILITY IMPROVEMENTS

ADDISON CIRCLE


PHASE I PUBLIC INFRASTRUCTURE

ADDISON CIRCLE FROM ADDISON THEATRE CENTRE TO QUORUM DRIVE
QUORUM DRIVE FROM DART RIGHT-OF-WAY TO GOODMAN AVENUE
GOODMAN AVENUE FROM PASCHAL PLACE TO QUORUM DRIVE
MORRIS AVENUE FROM WEST PROPERTY LINE TO QUORUM DRIVE
PASCHAL PLACE FROM MORRIS AVENUE TO GOODMAN AVENUE
WITT PLACE FROM ADDISON CIRCLE TO MORRIS AVENUE



T O W N O F
A D D I S O N

SHEET NO.	INDEX OF DRAWINGS
1	COVER SHEET
2-7	QUANTITY SHEETS
8	HORIZONTAL CONTROL PLAN
9-14	CONSTRUCTION SEQUENCING
15	PAVING TYPICAL SECTIONS
16	TYPICAL UTILITY LOCATIONS
17-17A	SIGNAGE & STRIPING PLAN AND DETAILS
18	DEMOLITION PLAN
19-27	PAVING PLANS & PROFILES
28	GEOMETRIC PLAN - ROUNDABOUT
29	JOINT PLAN - ROUNDABOUT
30	OFFSITE GRADING
31-33	PAVING DETAILS
34-41	CROSS SECTIONS
42	SLEEVING PLAN
43-48	SURFACE PATTERNING PLANS
49-54	STREETSCAPE PLANS
55-58	STREETSCAPE, LIGHT & SUBDRAIN DETAILS
59-60	DRAINAGE AREA MAPS
61-64	STORM WATER CALCULATIONS
65-76	STORM WATER PLANS & PROFILES
77-78	SWALE GRADING PLANS & PROFILES
79-81	STORM WATER DETAILS
82	WATER & WASTEWATER SITE MAP
83-89	WATER PLANS & PROFILES
90-91	WATER DETAILS
92-99	WASTEWATER PLANS & PROFILES
100-101	WASTEWATER DETAILS
102-103	POLLUTION CONTROL PLANS
104	POLLUTION CONTROL DETAILS
105-111	ELECTRICAL DUCT BANK PLANS & PROFILES
112-120	ELECTRICAL DETAILS
121-127	PLANTING & FURNITURE PLANS
128	PLANTING DETAILS
129	TREE REMOVAL, RELOCATION & PROTECTION PLAN
130-136	IRRIGATION PLANS
137	IRRIGATION DETAILS

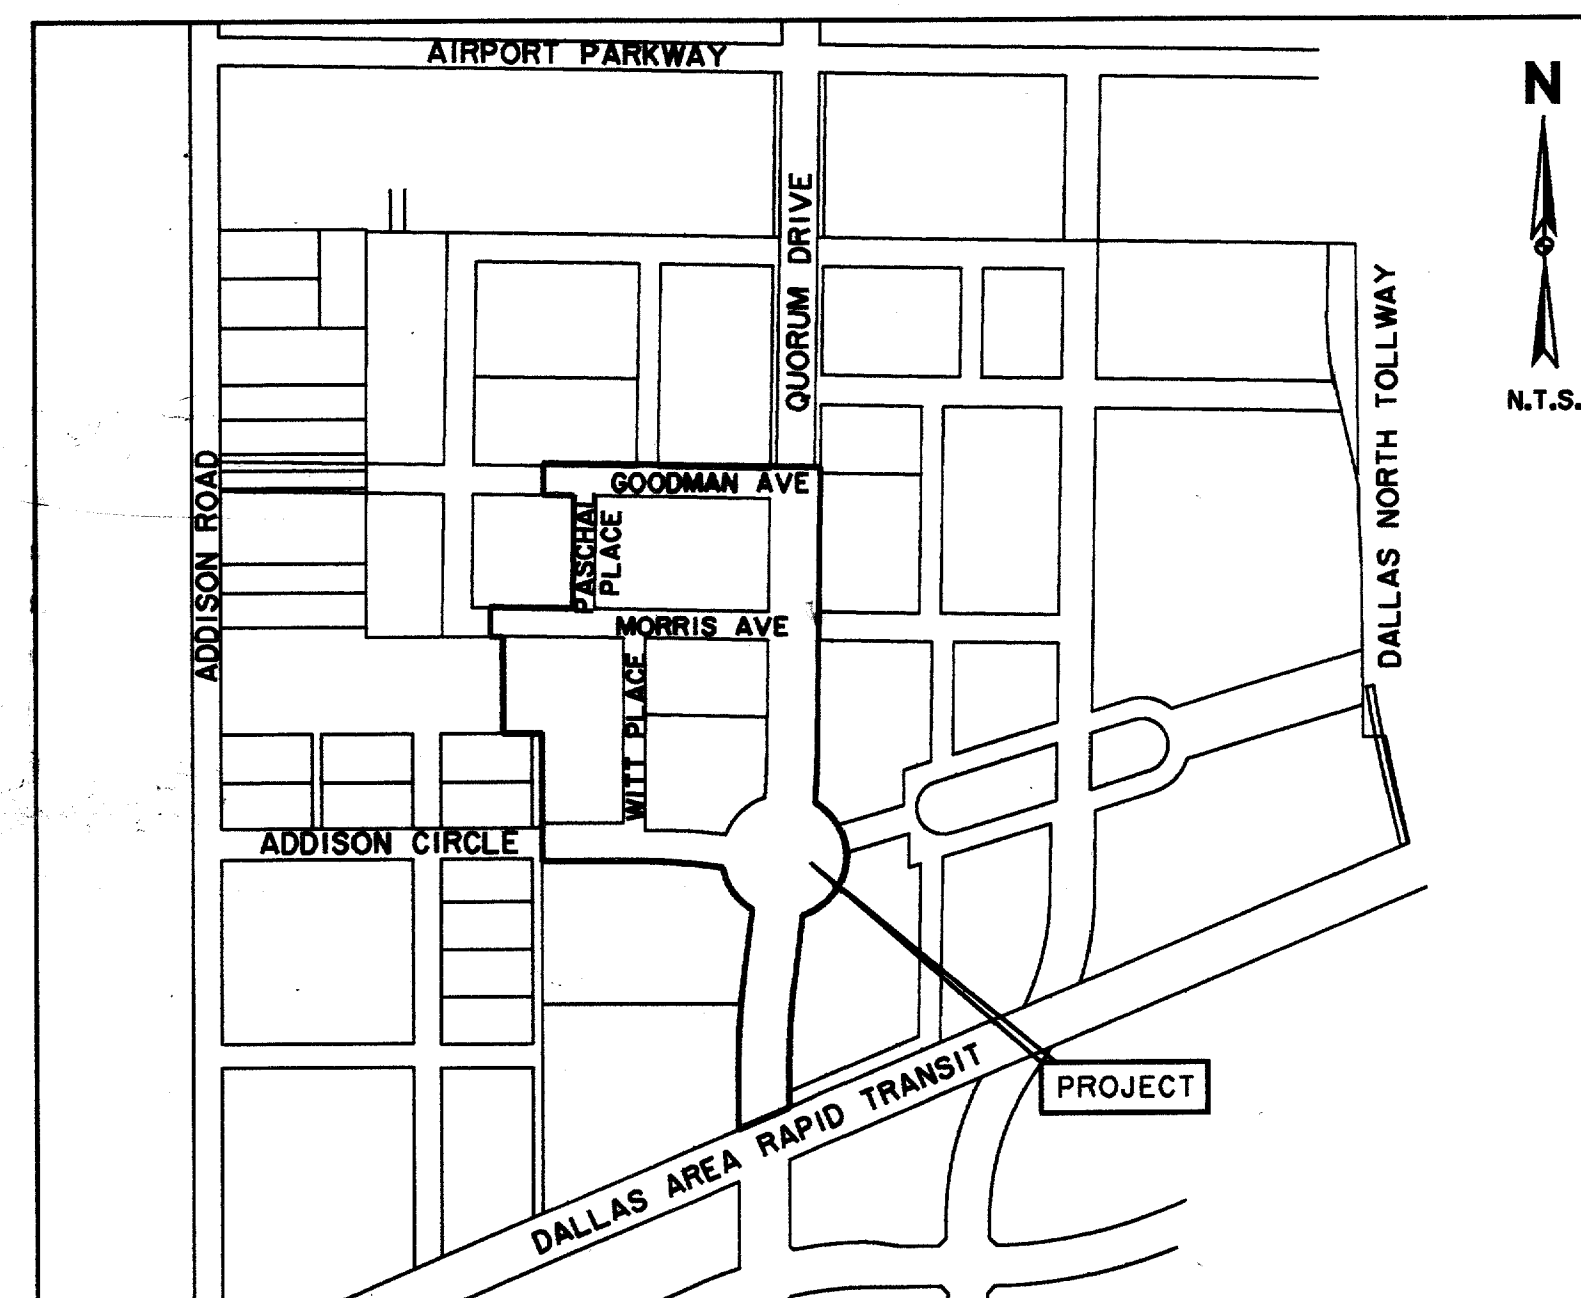

LOCATION MAP

RECORD DRAWINGS

(5/1/98)

THIS SET OF DRAWINGS HAS BEEN MODIFIED FROM THE ORIGINAL DESIGN DRAWINGS TO REFLECT THE FIELD CHANGES THAT OCCURRED DURING CONSTRUCTION WHICH WERE DOCUMENTED AND FURNISHED TO THE ENGINEER BY THE CONTRACTOR. BASED ON THIS INFORMATION AND THE ENGINEER'S OBSERVATION OF CERTAIN CONSTRUCTION ACTIVITIES, TO THE BEST OF THE ENGINEER'S KNOWLEDGE AND BELIEF, THE PROJECT IS CONSTRUCTED IN CONFORMANCE WITH THE PLANS AND SPECIFICATIONS AND WILL FUNCTION AS DESIGNED.



Andrew C. Oakley
10/2/98

OWNER:

TOWN OF ADDISON
DEPARTMENT OF PUBLIC WORKS
16801 WESTGROVE
P.O. BOX 9010
ADDISON, TEXAS 75001
(972) 450-2871 FAX (972) 450-2837

ENGINEER:

HUITT-ZOLLARS, INC.
3131 MCKINNEY AVE., SUITE 600
DALLAS, TEXAS 75204
(214) 871-3311 FAX (214) 871-0757

KENNETH A. ROBERTS, P.E.
TX. REG. NO. 55446

ISSUED FOR CONSTRUCTION
MARCH 28, 1996

THE SEAL APPEARING ON THIS DOCUMENT WAS AUTHORIZED BY KENNETH A. ROBERTS, P.E. 55446 ON MARCH 28, 1996



3-28-96