


TOWN OF ADDISON  
SPECIAL EVENTS AREA

ADDISON CIRCLE APARTMENTS  
BLDG. "A"

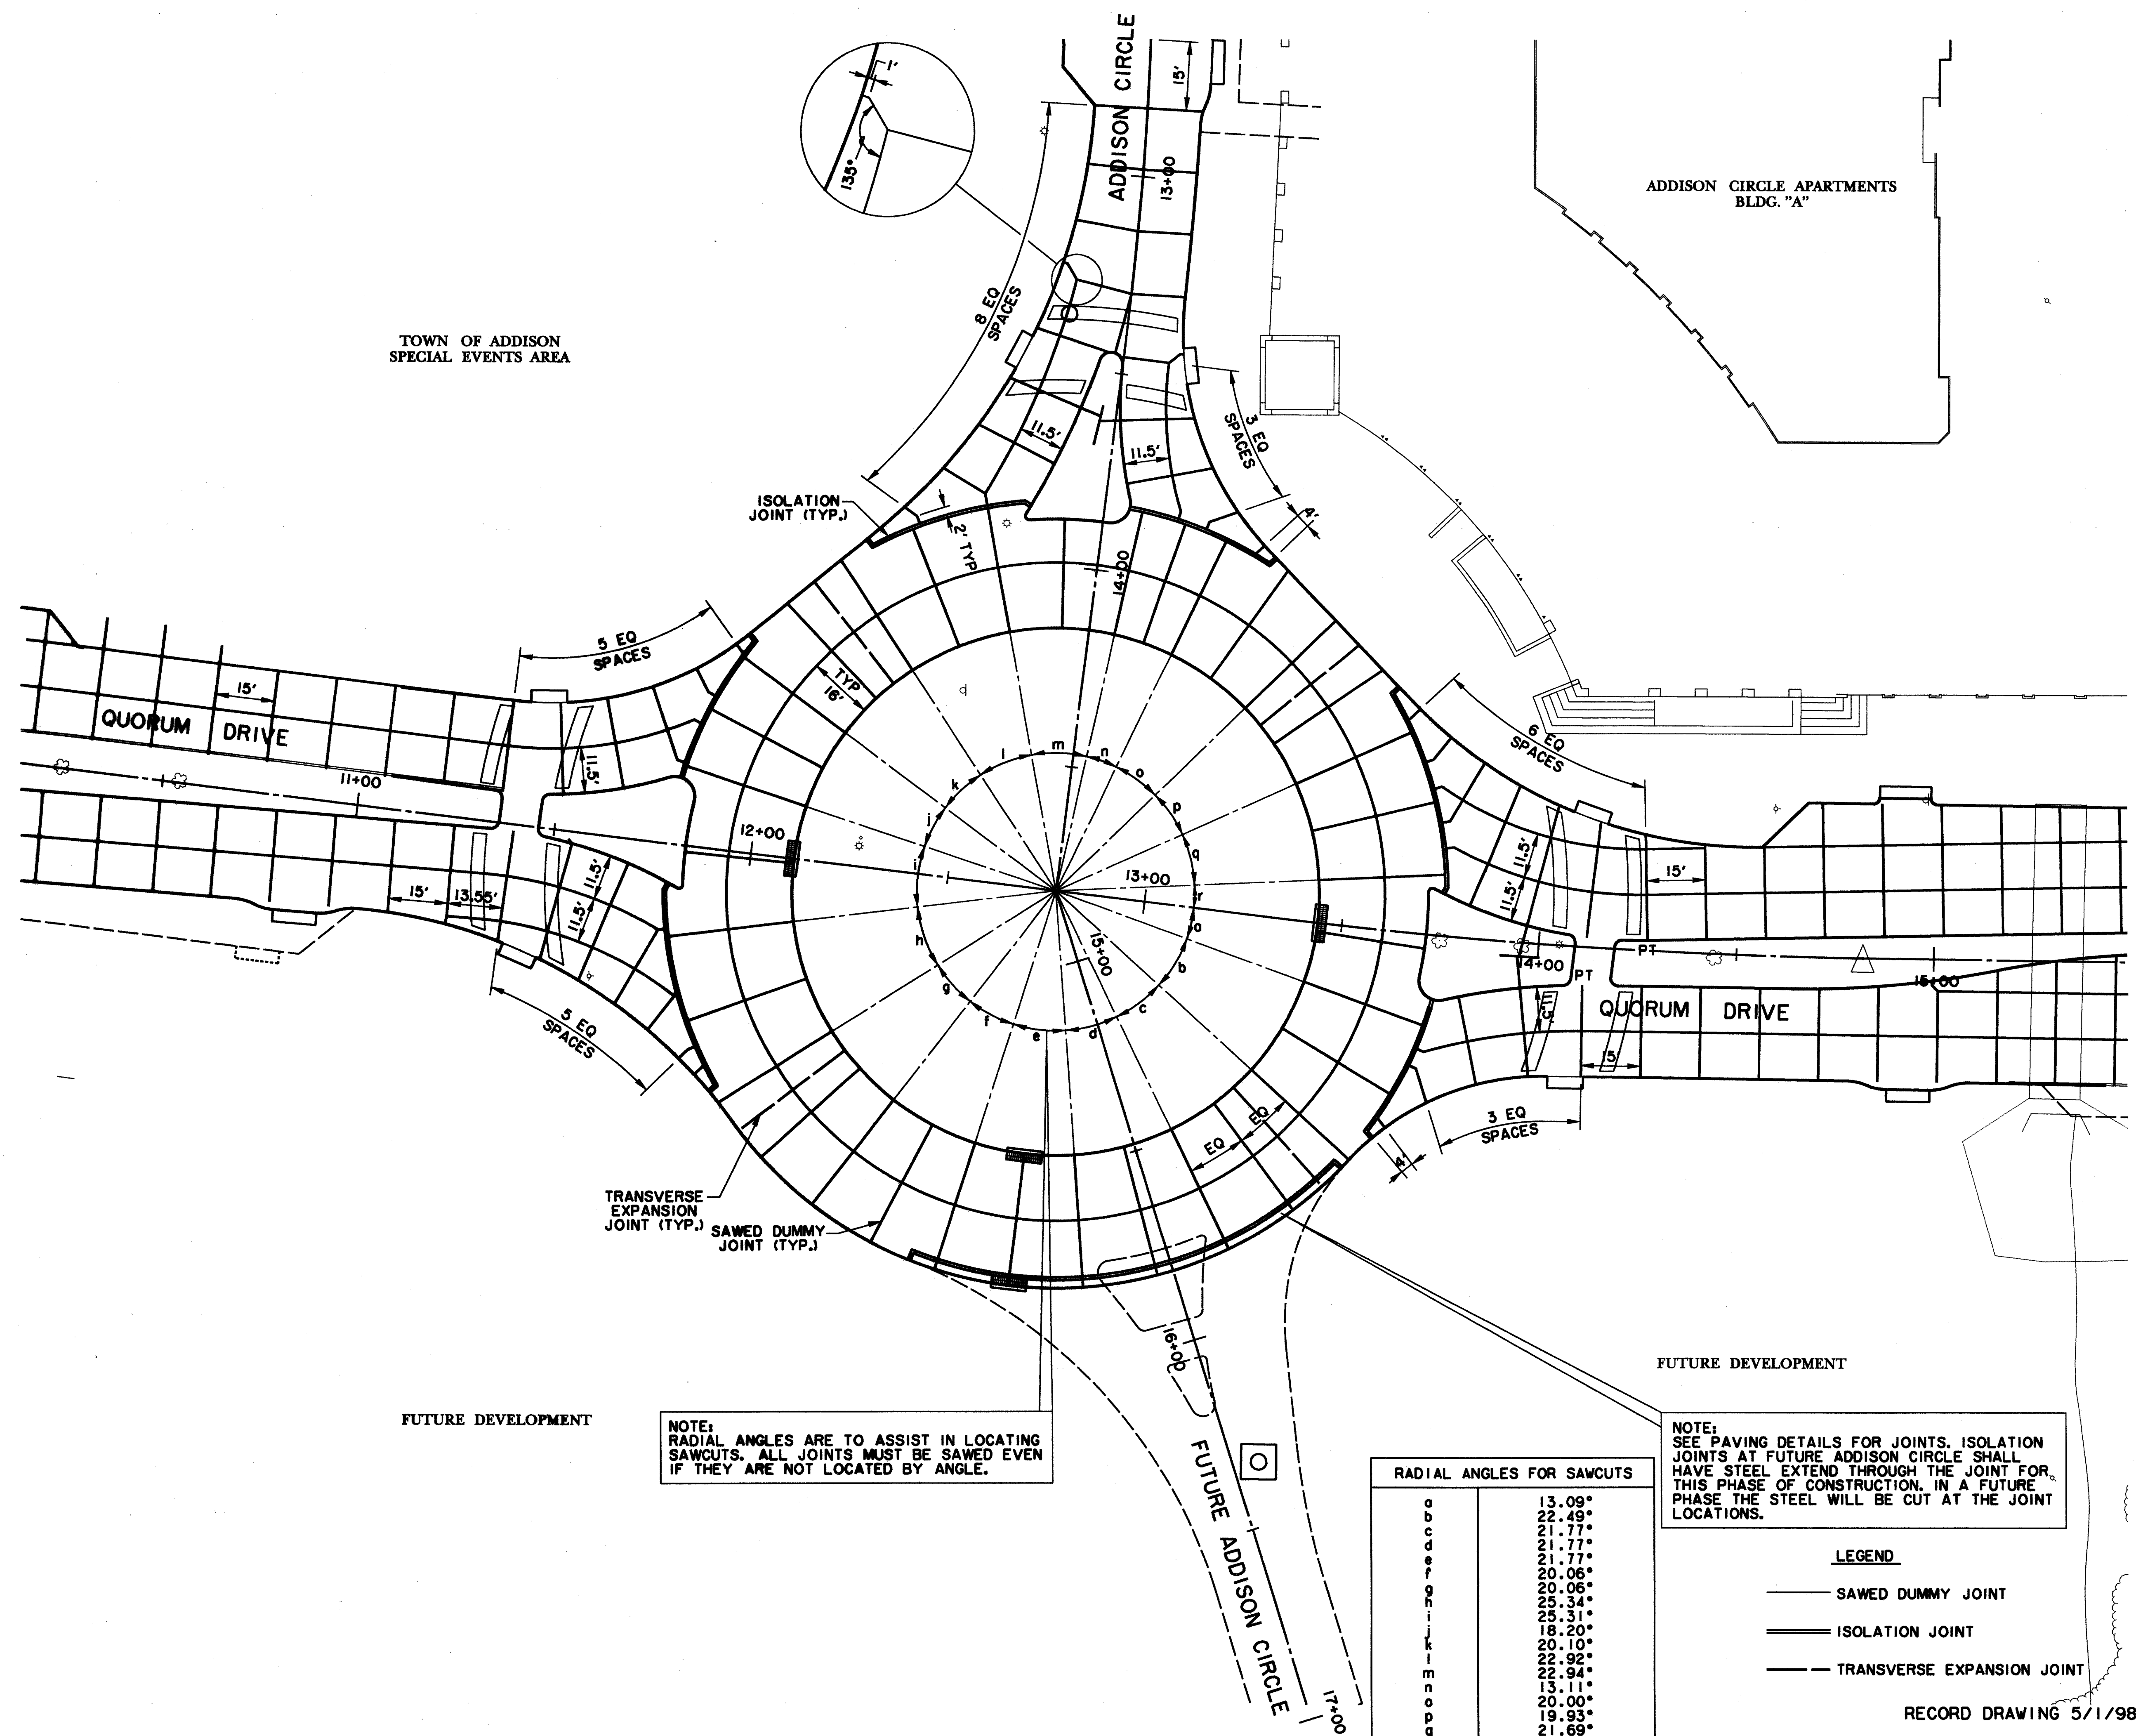

NOTE:  
RADIAL ANGLES ARE TO ASSIST IN LOCATING  
SAWCUTS. ALL JOINTS MUST BE SAWED EVEN  
IF THEY ARE NOT LOCATED BY ANGLE.

NOTE:  
SEE PAVING DETAILS FOR JOINTS. ISOLATION  
JOINTS AT FUTURE ADDISON CIRCLE SHALL  
HAVE STEEL EXTEND THROUGH THE JOINT FOR  
THIS PHASE OF CONSTRUCTION. IN A FUTURE  
PHASE THE STEEL WILL BE CUT AT THE JOINT  
LOCATIONS.

RADIAL ANGLES FOR SAWCUTS	
a	13.09°
b	22.49°
c	21.77°
d	21.77°
e	20.06°
f	20.06°
g	25.34°
h	25.31°
i	18.20°
j	20.10°
k	22.92°
l	22.94°
m	13.11°
n	20.00°
o	19.93°
p	21.69°
q	9.45°
r	

- LEGEND**
- SAWED DUMMY JOINT
  - ISOLATION JOINT
  - TRANSVERSE EXPANSION JOINT

**LEGEND**

<b>ELECTRIC</b> — OHE —	<b>MISC.</b>
⊙ LIGHT POLE	48" RCP EX. STORM SEWER
PP <sup>PL</sup> POWER POLE	— CHAIN LINK FENCE
← GUY WIRE	— WOOD FENCE
<b>TELEPHONE</b> — T —	— EXISTING ASPHALT
TELE MANHOLE	— EXISTING DIRT OR GRAVEL
☐ TELEPHONE PEDESTAL	— EX. CONCRETE
TS TELEPHONE SIGN	— TREE/TREE LINE
GM GAS METER	— EXISTING CURB
GS GAS SIGN	— PROP. CURB
<b>LAND USE</b>	— PROP. EDGE OF PAVEMENT NO CURB
R-R RAILROAD SIGN	— EX. PROPERTY LINE
SIGN	— PROP. CENTERLINE
<b>SURVEY</b>	— PROP. R.O.W.
I.R. FOUND IRON ROD	— PROP. INLET
TEMP BENCHMARK	T.P. TOP OF PAVEMENT
<b>WASTEWATER</b> — WW —	T.C. TOP OF CURB
WM WASTEWATER MANHOLE	— CURB RETURN
CO CLEANOUT	EX. G EXISTING GUTTER
<b>WATER</b> — W —	⊙ B-20 BORING LOCATION
FH FIRE HYDRANT	
WM METER	
T WATER VALVE	


**BENCHMARKS:**

**BM#1**  
□ CUT AT CENTER BACK OF CURB OF INLET, 190 FEET SOUTH FROM THE CENTERLINE INTERSECTION OF ADDISON CIRCLE, WEST SIDE OF QUORUM DRIVE.  
ELEV. 621.89

**BM#2**  
□ CUT AT CENTER BACK OF CURB OF INLET, 200 FEET NORTH FROM THE CENTERLINE INTERSECTION OF ADDISON CIRCLE, WEST SIDE OF QUORUM DRIVE.  
ELEV. 621.68

ISSUED FOR CONSTRUCTION  
MARCH 28, 1996

THE SEAL APPEARING ON THIS DOCUMENT WAS AUTHORIZED BY  
KENNETH A. ROBERTS, P.E. 55446  
ON MARCH 28, 1996.

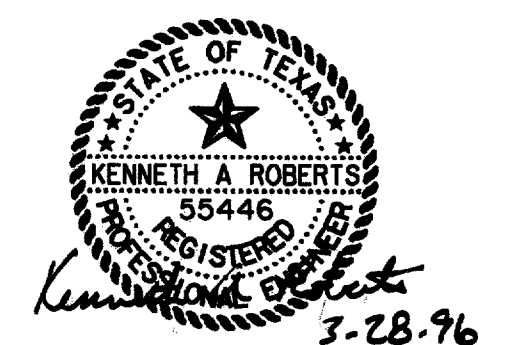

<b>JOINT PLAN</b>	
ROUNDABOUT - QUORUM DRIVE & ADDISON CIRCLE	
<b>ADDISON CIRCLE</b>	
PHASE I PUBLIC INFRASTRUCTURE	
TOWN OF ADDISON, TEXAS	
Huitl-Zollars, Inc./Engineering/Architecture Dallas, Fort Worth, Houston, El Paso, Phoenix, Tustin, Ontario, San Clemente	
DESIGN	HZ1
DRAWN	HZ1
APPR.	KAR
SCALE	1"=20'
DATE	JAN 96
PROJECT NO.	1822-04
NO.	29
137	

RECORD DRAWING 5/1/98

ADDED ANGLE CHART TO  
LOCATE RADIAL SAWING 7/29/96