

STORM WATER RUNOFF CALCULATIONS

AREA NO.	Tc (MIN.)	INTENSITY "1-100" (IN./HR)	RUNOFF COEFF. "C"	AREA "A" (ACRES)	STORM RUNOFF "Q-100"
A-12	10.00	8.74	0.90	0.18	1.42
A-13	10.00	8.74	0.30	3.17	8.37
A-14	10.00	8.74	0.90	0.40	3.15
A-15	10.00	8.74	0.30	4.01	10.51
E-14	10.00	8.74	0.30	3.88	10.17
E-13	10.00	8.74	0.30	5.63	14.76
F-12	10.00	8.74	0.30	0.95	2.49
F-13	10.00	8.74	0.90	0.12	0.94
F-14	10.00	8.74	0.90	0.07	0.55
F-15	10.00	8.74	0.30	0.61	1.60
F-16	10.00	8.74	0.30	0.72	1.89
F-17	10.00	8.74	0.90	0.09	0.71

- NOTES:**
- THIS PLAN REPRESENTS FLOW QUANTITIES AND DRAINAGE PATTERNS TO BE ANTICIPATED FROM AREAS UPSTREAM OF ADDISON CIRCLE PHASE I PRIOR TO THE ULTIMATE DEVELOPMENT OF THESE AREAS. IT ALSO INDICATES TEMPORARY SWALES AND INLETS NEEDED TO HANDLE THESE INTERIM DRAINAGE PATTERNS. HOWEVER, THE PERMANENT STORM SEWER SYSTEM HAS BEEN DESIGNED FOR ULTIMATE DEVELOPMENT CONDITIONS PER SHEET 59 OF THIS SET.
 - EXISTING STORM SEWER LOCATIONS AND SIZES WERE OBTAINED FROM RECORD DRAWINGS FROM THE TOWN OF ADDISON. ACTUAL LOCATION IN THE FIELD MAY VARY FROM THE PLANS.


--- DRAINAGE AREA DIVIDE
 → DIRECTION OF SURFACE FLOW

RUNOFF CRITERIA
 C=0.30 FOR UNDEVELOPED AREAS
 C=0.90 FOR DEVELOPED AREAS
 MINIMUM tc=10.00 MINUTES
 I100=8.74 in/hr

(A-1)
 2.22
 17.5
 Q100 (cfs)

ISSUED FOR CONSTRUCTION
 MARCH 28, 1996

THE SEAL APPEARING ON THIS DOCUMENT WAS AUTHORIZED BY KENNETH A. ROBERTS, P.E. 55446 ON MARCH 28, 1996.

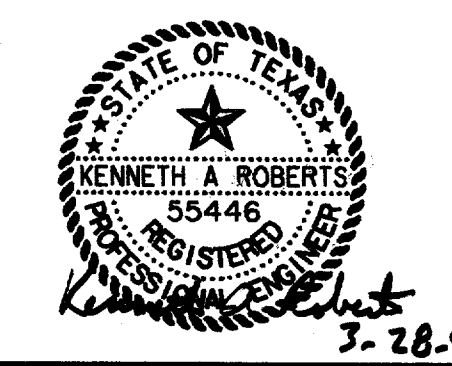

DRAINAGE AREA MAP					
OFFSITE AREAS EXISTING CONDITIONS					
ADDISON CIRCLE					
PHASE I PUBLIC INFRASTRUCTURE					
TOWN OF ADDISON, TEXAS					
<small>Huitt-Zollars, Inc./Engineering/Architecture Dallas, Fort Worth, Houston, El Paso, Phoenix, Tustin, Ontario, San Clemente</small>					
DESIGN	DRAWN	APPR.	SCALE	DATE	PROJECT NO.
HZI	HZI	KAR	1"=100'	JAN 96	1822-04
					60
					137

RECORD DRAWING 5/1/98