


**LEGEND**

— OHE —	48" RCP	MISC.
○ LIGHT POLE	— EX. STORM SEWER	— CHAIN LINK FENCE
pp POWER POLE	— WOOD FENCE	— EXISTING ASPHALT
— GUY WIRE	— EXISTING DIRT OR GRAVEL	— EX. CONCRETE
TELEPHONE	— TELEPHONE MANHOLE	— TREE/TREE LINE
— TELEPHONE PEDESTAL	— TELEPHONE SIGN	— EXISTING CURB
— TELEPHONE SIGN	— EX. PROPERTY LINE	— PROP. CENTERLINE
— GAS METER	— PROP. R.O.W.	— PROP. INLET
— GAS SIGN	— SURVEY	— T.P. TOP OF PAVEMENT
— LAND USE	— FOUND IRON ROD	— T.C. TOP OF CURB
— R.R. RAILROAD SIGN	— TEMP BENCHMARK	— C.R. CURB RETURN
— SIGN	— WASTEWATER MANHOLE	— EX. GUTTER
— SURVEY	— CLEANOUT	— BORING LOCATION
— SURVEY	— WATER	— B-20
— SURVEY	— FIRE HYDRANT	
— SURVEY	— METER	
— SURVEY	— WATER VALVE	

RECORD DRAWING 5/1/98 ADDENDUM #2 1/22/96

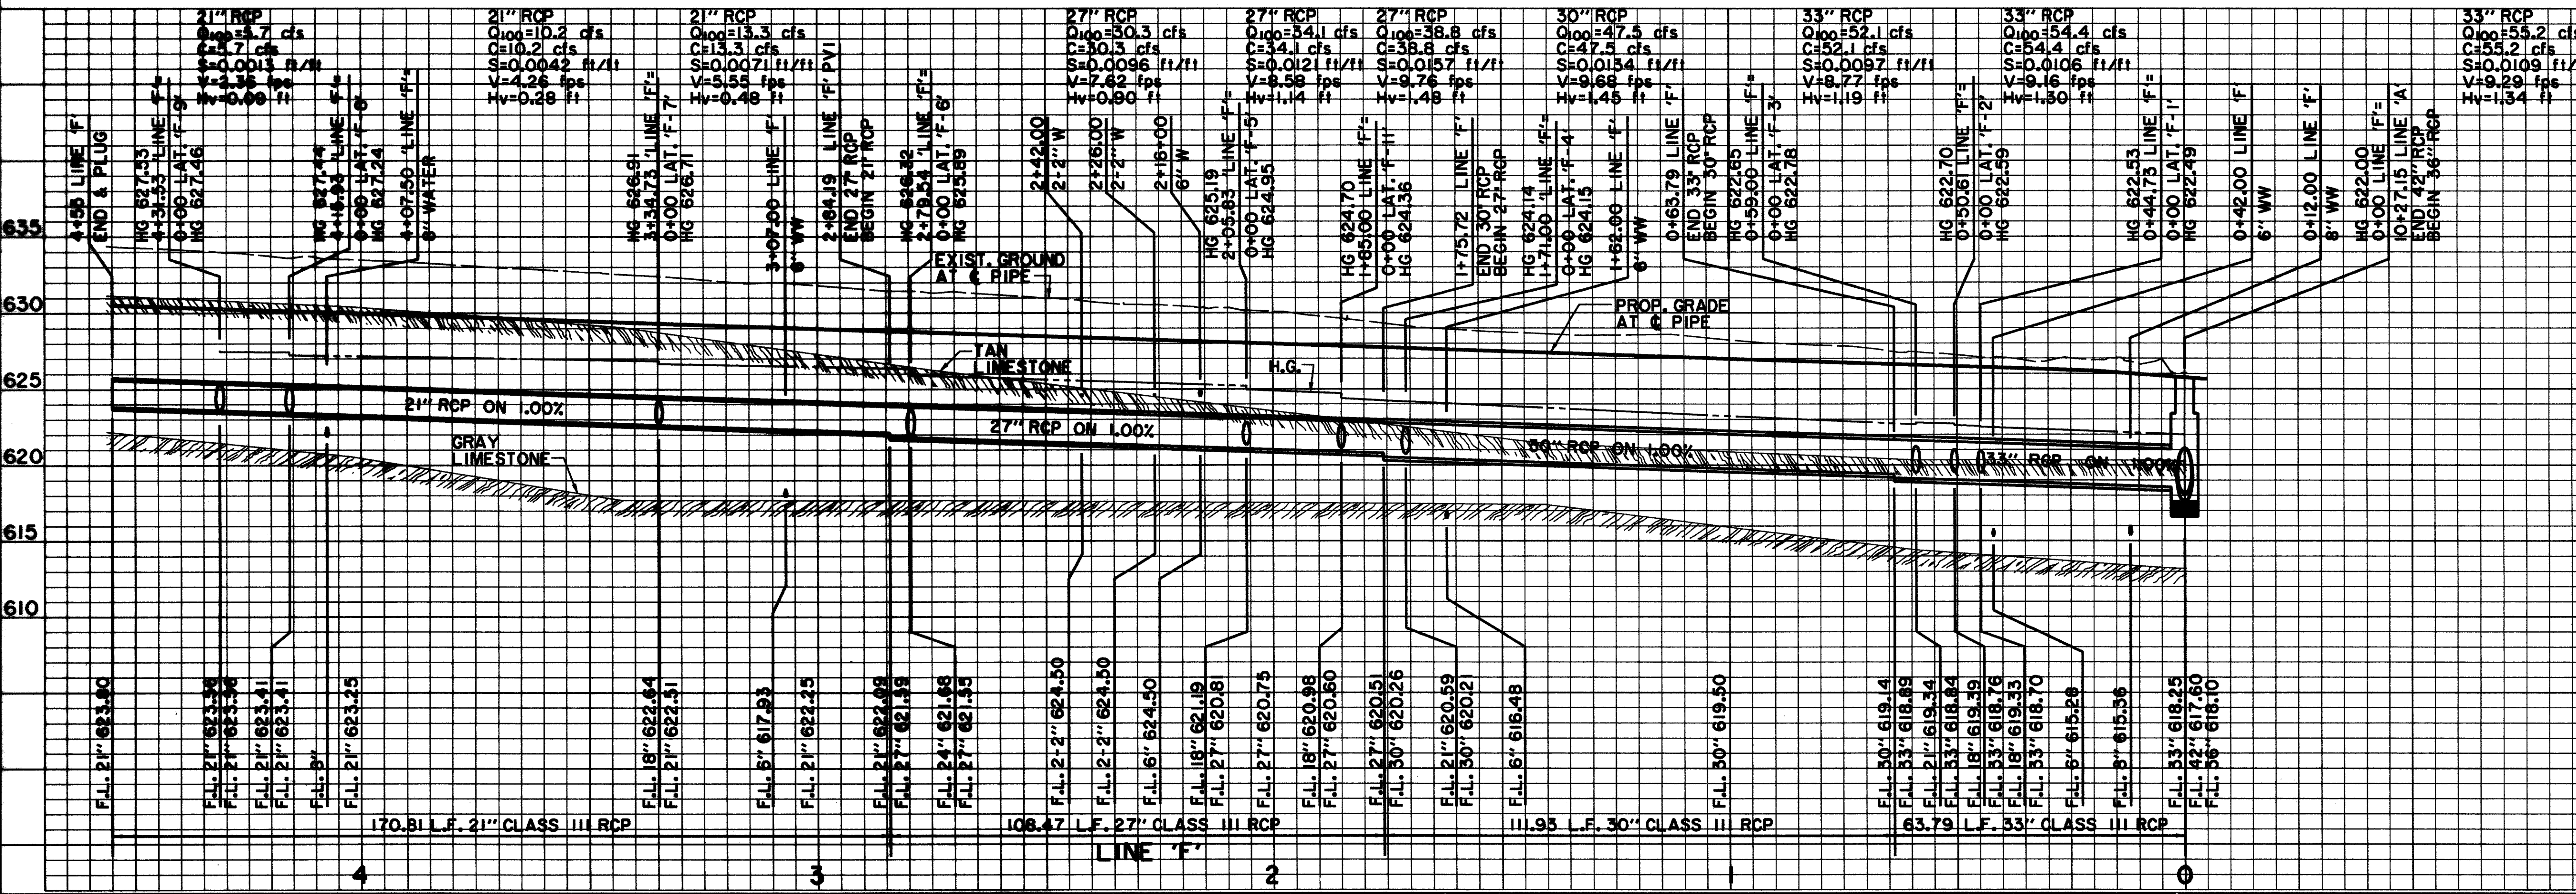


**BENCHMARKS:**

BM#2  
"C" CUT AT CENTER BACK OF CURB OF INLET, 200 FEET NORTH FROM THE CENTERLINE INTERSECTION OF ADDISON CIRCLE, WEST SIDE OF QUORUM DRIVE.  
ELEV. 621.68

BM#3  
"C" CUT AT CENTER BACK OF CURB OF INLET, 620 FEET NORTH FROM THE CENTERLINE INTERSECTION OF ADDISON CIRCLE, WEST SIDE OF QUORUM DRIVE.  
ELEV. 624.50

ISSUED FOR CONSTRUCTION  
MARCH 28, 1996

THE SEAL APPEARING ON THIS DOCUMENT WAS AUTHORIZED BY KENNETH A. ROBERTS, P.E. 45446 ON MARCH 28, 1996.

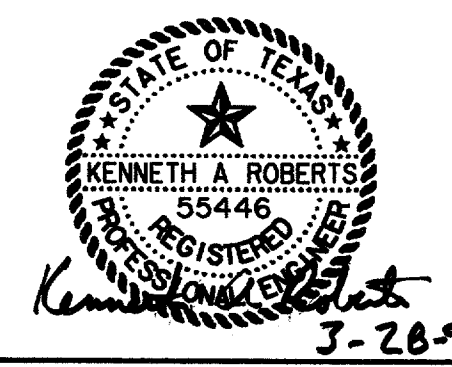

**STORM WATER PLAN & PROFILE**  
**LINE 'F'**

**ADDISON CIRCLE**  
**PHASE I PUBLIC INFRASTRUCTURE**  
**TOWN OF ADDISON, TEXAS**

Huitt-Zollars, Inc./Engineering/Architecture  
Dallas, Fort Worth, Houston, El Paso, Phoenix, Tustin, Ontario, San Clemente

DESIGN	DRAWN	APPR.	SCALE	DATE	PROJECT NO.	NO.
HZI	HZI	KAR	H <sub>1</sub> 1"=20' V <sub>1</sub> 1"=6'	JAN 96	1822-04	74
						137

H:\PROJ\182204\DWG\AUC1D06.DWG