


HYDROMULCH LIMITS OF DISTURBED AREA AND PROVIDE TEMP. IRRIGATION


INSTALL NORTH AMERICAN GREEN SISOBN OR EQUAL STRAW FIBER EROSION CONTROL BLANKET

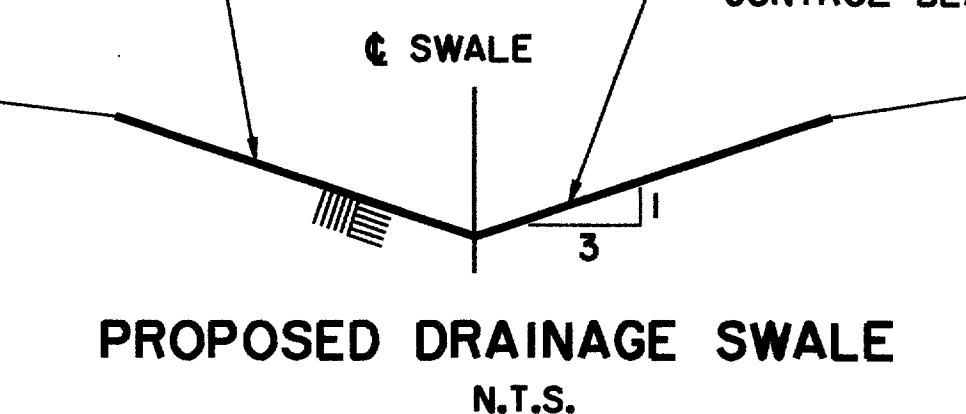

LEGEND

ELECTRIC — OHE —	48" RCP	MISC.
⊙ LIGHT POLE	— EX. STORM SEWER	
⊙ POWER POLE	— CHAIN LINK FENCE	
— GUY WIRE	— WOOD FENCE	
TELEPHONE — T —	— EXISTING ASPHALT	
TELEPHONE MANHOLE	— EXISTING DIRT OR GRAVEL	
TELEPHONE PEDESTAL	— EX. CONCRETE	
TELEPHONE SIGN	— TREE/TREE LINE	
GAS — G —	— EXISTING CURB	
GAS METER	— PROP. CURB	
GAS SIGN	— PROP. EDGE OF PAVEMENT NO CURB	
LAND USE	— EX. PROPERTY LINE	
R.R. RAILROAD SIGN	— PROP. CENTERLINE	
SIGN	— PROP. R.O.W.	
SURVEY	— PROP. INLET	
I.R. FOUND IRON ROD	— T.P. TOP OF PAVEMENT	
TEMP BENCHMARK	— T.C. TOP OF CURB	
WASTEWATER — WW —	— C.R. CURB RETURN	
WASTEWATER MANHOLE	— EX. G EXISTING GUTTER	
CLEANOUT	— BORING LOCATION	
WATER — W —	— B-20	
FH FIRE HYDRANT		
METER		
T WATER VALVE		

RECORD DRAWING 5/1/98
 △ CORRECTED STATIONS AND OFFSETS 4/18/96

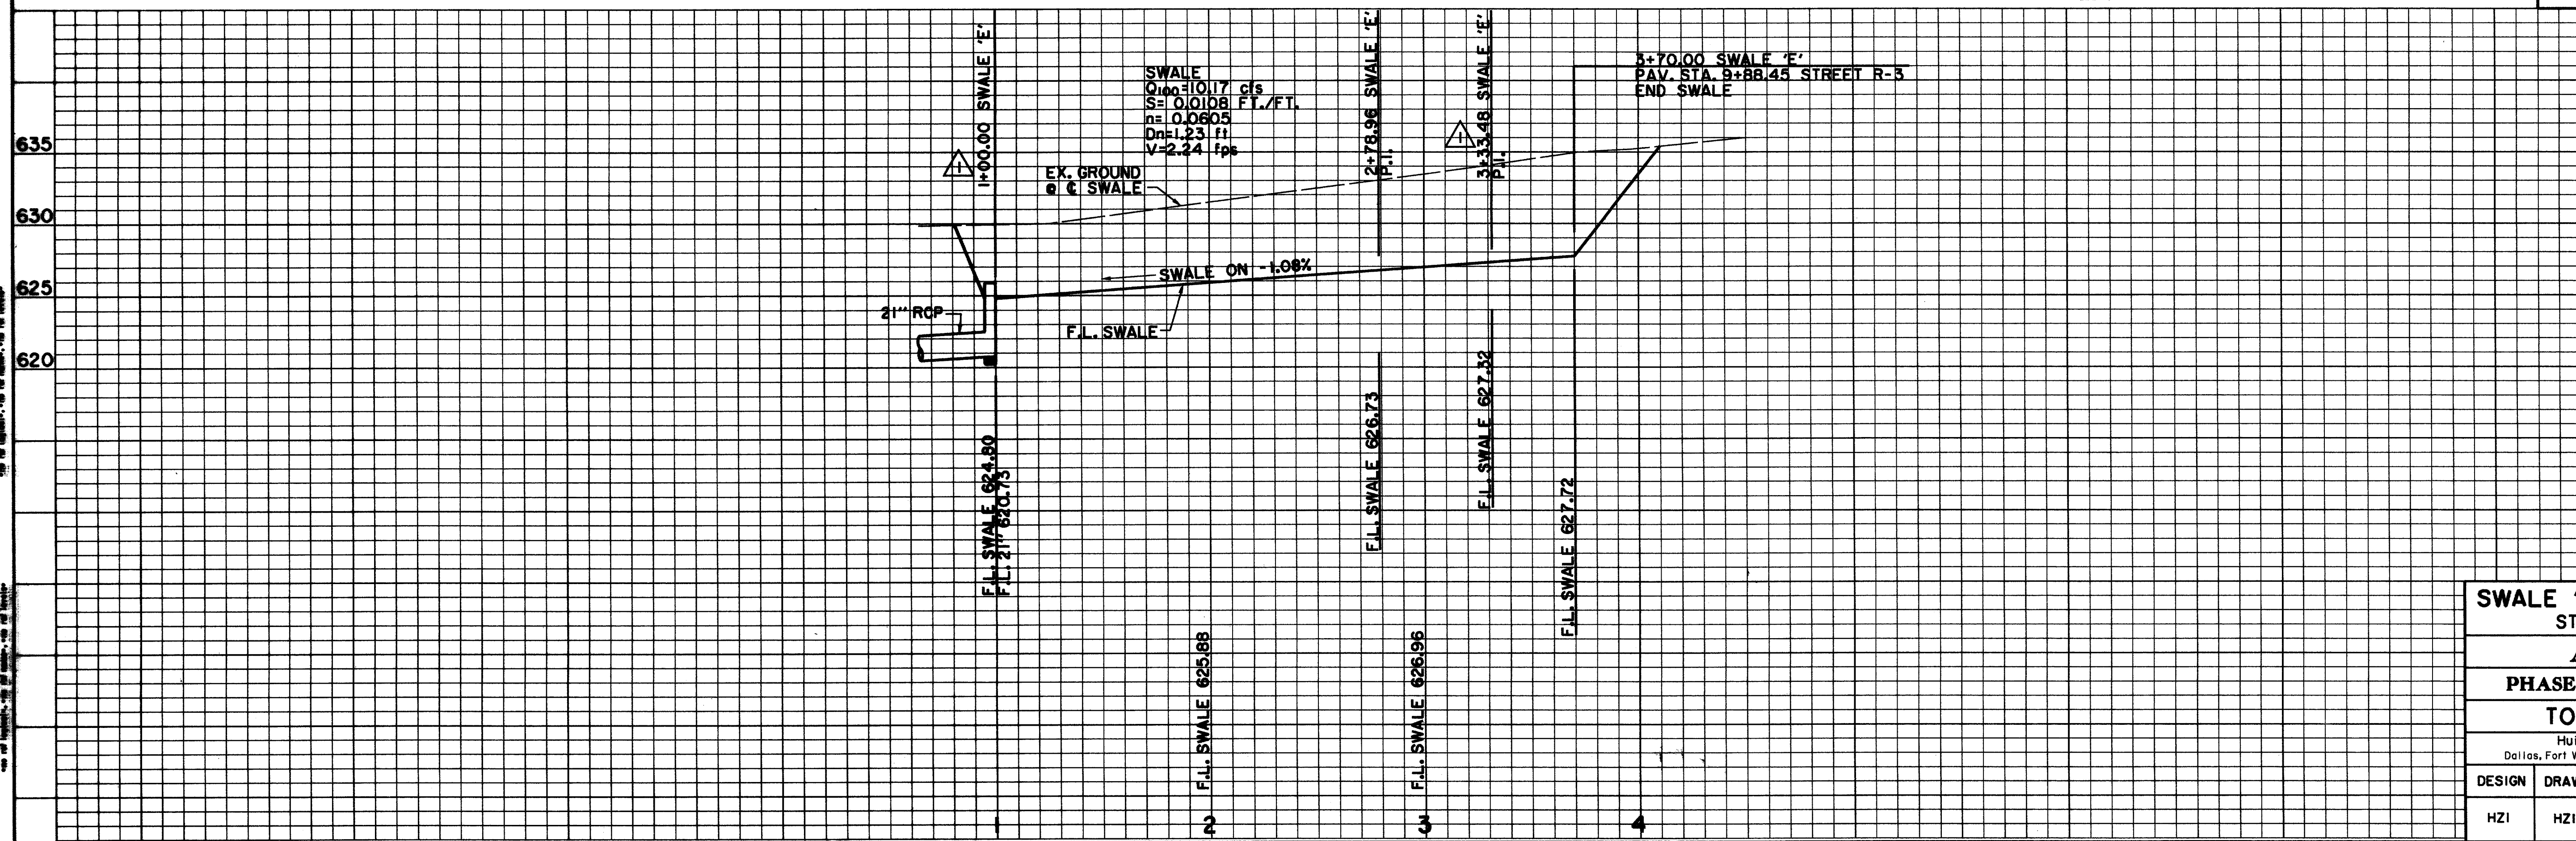

BENCHMARKS:

BM#2
"I" CUT AT CENTER BACK OF CURB OF INLET, 200 FEET NORTH FROM THE CENTERLINE INTERSECTION OF ADDISON CIRCLE, WEST SIDE OF QUORUM DRIVE.
ELEV. 621.68

635

630

625

620

BM#3
"I" CUT AT CENTER BACK OF CURB OF INLET, 620 FEET NORTH FROM THE CENTERLINE INTERSECTION OF ADDISON CIRCLE, WEST SIDE OF QUORUM DRIVE.
ELEV. 624.50

ISSUED FOR CONSTRUCTION
MARCH 28, 1996

THE SEAL APPEARING ON THIS DOCUMENT WAS AUTHORIZED BY KENNETH A. ROBERTS, P.E. 53448 ON MARCH 28, 1996.

Kenneth A. Roberts
3-28-96

SWALE 'E' GRADING PLAN & PROFILE
 STA. 1+00 TO STA. 3+96.87

ADDISON CIRCLE

PHASE I PUBLIC INFRASTRUCTURE

TOWN OF ADDISON, TEXAS

Hullitt-Zollars, Inc./Engineering/Architecture
 Dallas, Fort Worth, Houston, El Paso, Phoenix, Tulsa, Ontario, San Clemente

DESIGN	DRAWN	APPR.	SCALE	DATE	PROJECT NO.	NO.
HZI	HZI	KAR	H ₁ 1"=40' V ₁ 1"=6'	JAN 96	1822-04	78 / 137

H:\PROJ\182204\DWG\AUCIG20.DWG