


LEGEND

ELECTRIC — OHE	MISC.
◇ LIGHT POLE	— 48" RCP
PP POWER POLE	— EX. STORM SEWER
— GUY WIRE	— CHAIN LINK FENCE
TELEPHONE	— WOOD FENCE
TELEPHONE MANHOLE	— EXISTING ASPHALT
TELEPHONE PEDESTAL	— EXISTING DIRT OR GRAVEL
TS TELEPHONE SIGN	— EX. CONCRETE
GM GAS METER	— TREE/TREE LINE
GS GAS SIGN	— EXISTING CURB
LAND USE	— PROP. CURB
R/R RAILROAD SIGN	— PROP. EDGE OF PAVEMENT NO CURB
— SIGN	— EX. PROPERTY LINE
SURVEY	— PROP. CENTERLINE
I.R. FOUND IRON ROD	— PROP. R.O.W.
TEMP BENCHMARK	— PROP. INLET
WASTEWATER — WW	T.P. TOP OF PAVEMENT
WWM WASTEWATER MANHOLE	T.C. TOP OF CURB
CO CLEANOUT	C.R. CURB RETURN
WATER — W	EX. G EXISTING GUTTER
FR FIRE HYDRANT	B-20 BORING LOCATION
M METER	
V WATER VALVE	

THE PROPOSED 24" RCCP WATER MAIN SHALL BE INSTALLED, BACKFILLED AND IN SERVICE PRIOR TO MAY 1, 1997. WATER DEMANDS MAY DICTATE THAT THE CONTRACTOR PERFORM CONNECTIONS AT NIGHT. CONTRACTOR SHALL COORDINATE WITH THE TOWN OF ADDISON.

RECORD DRAWING 5/1/98

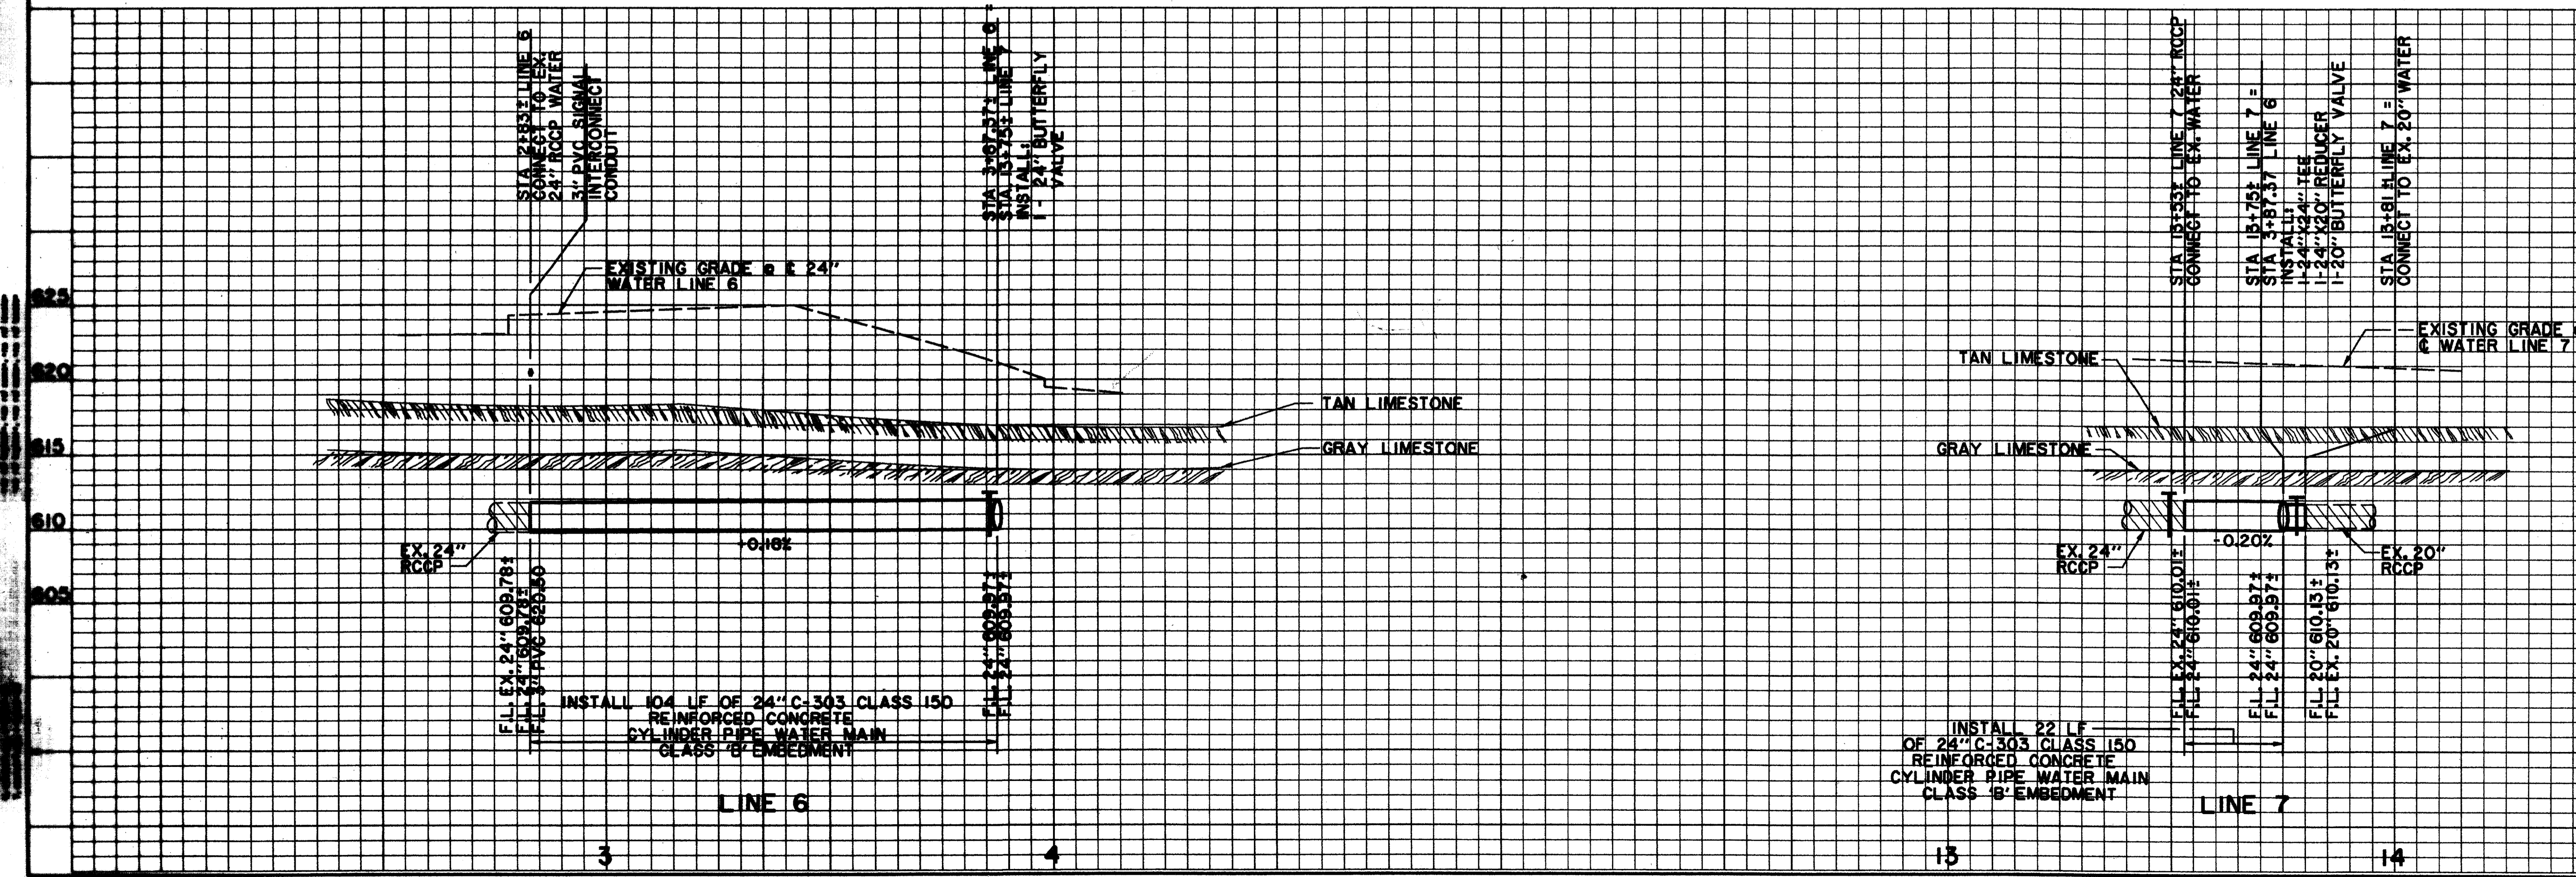


BENCHMARKS:

BM#1
"C" CUT AT CENTER BACK OF CURB OF INLET, 190 FEET SOUTH FROM THE CENTERLINE INTERSECTION OF ADDISON CIRCLE, WEST SIDE OF QUORUM DRIVE.
ELEV. 621.89

BM#4
"C" CUT AT CENTER BACK OF CURB OF INLET, 1015 FEET NORTH FROM THE CENTERLINE INTERSECTION OF ADDISON CIRCLE, WEST SIDE OF QUORUM DRIVE.
ELEV. 629.36

THE SEAL APPEARING ON THIS DOCUMENT WAS AUTHORIZED BY KENNETH A. ROBERTS, P.E. 55446 ON NOVEMBER 3, 1996.

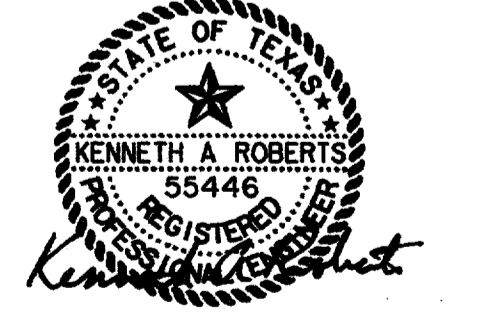

WATER PLAN & PROFILE LINES 6 & 7

ADDISON CIRCLE

PHASE I PUBLIC INFRASTRUCTURE

TOWN OF ADDISON, TEXAS

Hult-Zollars, Inc./Engineering/Architecture
Dallas, Fort Worth, Houston, El Paso, Phoenix, Tustin, Ontario, San Clemente

DESIGN	DRAWN	APPR.	SCALE	DATE	PROJECT NO.	NO.
HZI	HZI	KAR	H ₁ "=20' V ₁ "=6'	NOV 96	1822-04	89A

137