

11+66.26 ADDISON CIRCLE =
12+97.42 WITT PLACE

10+62.50 MORRIS AVENUE =
17+56.77 PASCHAL PLACE

PASCHAL PLACE
18+00 N 00°55'13" E 19+00

10+62.50 GOODMAN AVENUE =
20+52.77 PASCHAL PLACE

11+66.26 MORRIS AVENUE =
17+56.77 WITT PLACE

17+56.77 QUORUM DR. =
15+00.00 MORRIS AVENUE

20+52.77 QUORUM DR. =
15+00.00 GOODMAN AVENUE

12+77.56 QUORUM DR. =
14+81.48 ADDISON CIRCLE

$\Delta = 07^{\circ}12'46''$
 $R = 816.03'$
 $L = 102.73'$
 $T = 51.43'$

$\Delta = 06^{\circ}05'10''$
 $R = 1432.39'$
 $L = 152.15'$
 $T = 76.15'$

$\Delta = 06^{\circ}52'23''$
 $R = 1432.39'$
 $L = 171.83'$
 $T = 86.02'$

- NOTES:
1. ALL CENTERLINE PC'S, PT'S AND PI'S WILL BE SET ONE TIME FOR CONSTRUCTION HORIZONTAL CONTROL. IT IS THE RESPONSIBILITY OF THE CONTRACTOR TO MAINTAIN THIS CONTROL. IN ADDITION THE CONTRACTOR MAY FIND PROPERTY CORNERS FOR BLOCKS A, B & C SET AS PART OF THE PRIVATE DEVELOPMENT PLAT.
 2. CONTRACTOR SHALL MAINTAIN CONTROL POINTS FOR THE USE BY THE INSTALLERS OF THE PRIVATE UTILITIES. (TU ELECTRIC, SOUTHWESTERN BELL, LONE STAR GAS, TCI CABLEVISION ETC...)


LEGEND:

- EXISTING R.O.W./P.L.
- - - PROPOSED R.O.W./P.L.
- FUTURE R.O.W./P.L.
- - - EASEMENT LINE
- STREET CENTERLINE

RECORD DRAWING 5/1/98

ISSUED FOR CONSTRUCTION
MARCH 28, 1996

THE SEAL APPEARING ON THIS DOCUMENT WAS AUTHORIZED BY
KENNETH A. ROBERTS, P.E. 55446
ON MARCH 28, 1996.

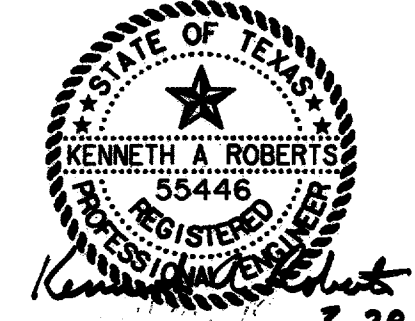

HORIZONTAL CONTROL PLAN						
ADDISON CIRCLE						
PHASE I PUBLIC INFRASTRUCTURE						
TOWN OF ADDISON, TEXAS						
Hutt-Zollars, Inc./Engineering/Architecture Dallas, Fort Worth, Houston, El Paso, Phoenix, Tustin, Ontario, San Clemente						
DESIGN	DRAWN	APPR.	SCALE	DATE	PROJECT NO.	NO.
HZI	HZI	KAR	1"=50'	JAN 96	1822-04	8 137