


**LEGEND**

	ELECTRIC — ONE		48" RCP		MISC.
	LIGHT POLE		EX. STORM SEWER		CHAIN LINK FENCE
	POWER POLE		WOOD FENCE		EXISTING ASPHALT
	GUY WIRE		EXISTING DIRT OR GRAVEL		EX. CONCRETE
	TELEPHONE — T		TREE/TREE LINE		EXISTING CURB
	TELEPHONE MANHOLE		PROP. CURB		PROP. EDGE OF PAVEMENT NO CURB
	TELEPHONE PEDESTAL		EX. PROPERTY LINE		PROP. CENTERLINE
	TELEPHONE SIGN		PROP. R.O.W.		PROP. INLET
	GAS — G		T.P.		TOP OF PAVEMENT
	GAS METER		T.C.		TOP OF CURB
	GAS SIGN		C.R.		CURB RETURN
	LAND USE		EX. G		EXISTING GUTTER
	RAILROAD SIGN		B-20		BORING LOCATION
	SIGN				
	SURVEY				
	FOUND IRON ROD				
	TEMP BENCHMARK				
	WASTEWATER — WW				
	WASTEWATER MANHOLE				
	CLEANOUT				
	WATER — W				
	FIRE HYDRANT				
	METER				
	WATER VALVE				

▲ ADDED 6" WW LATERAL 5/30/96 RECORD DRAWING 5/1/98

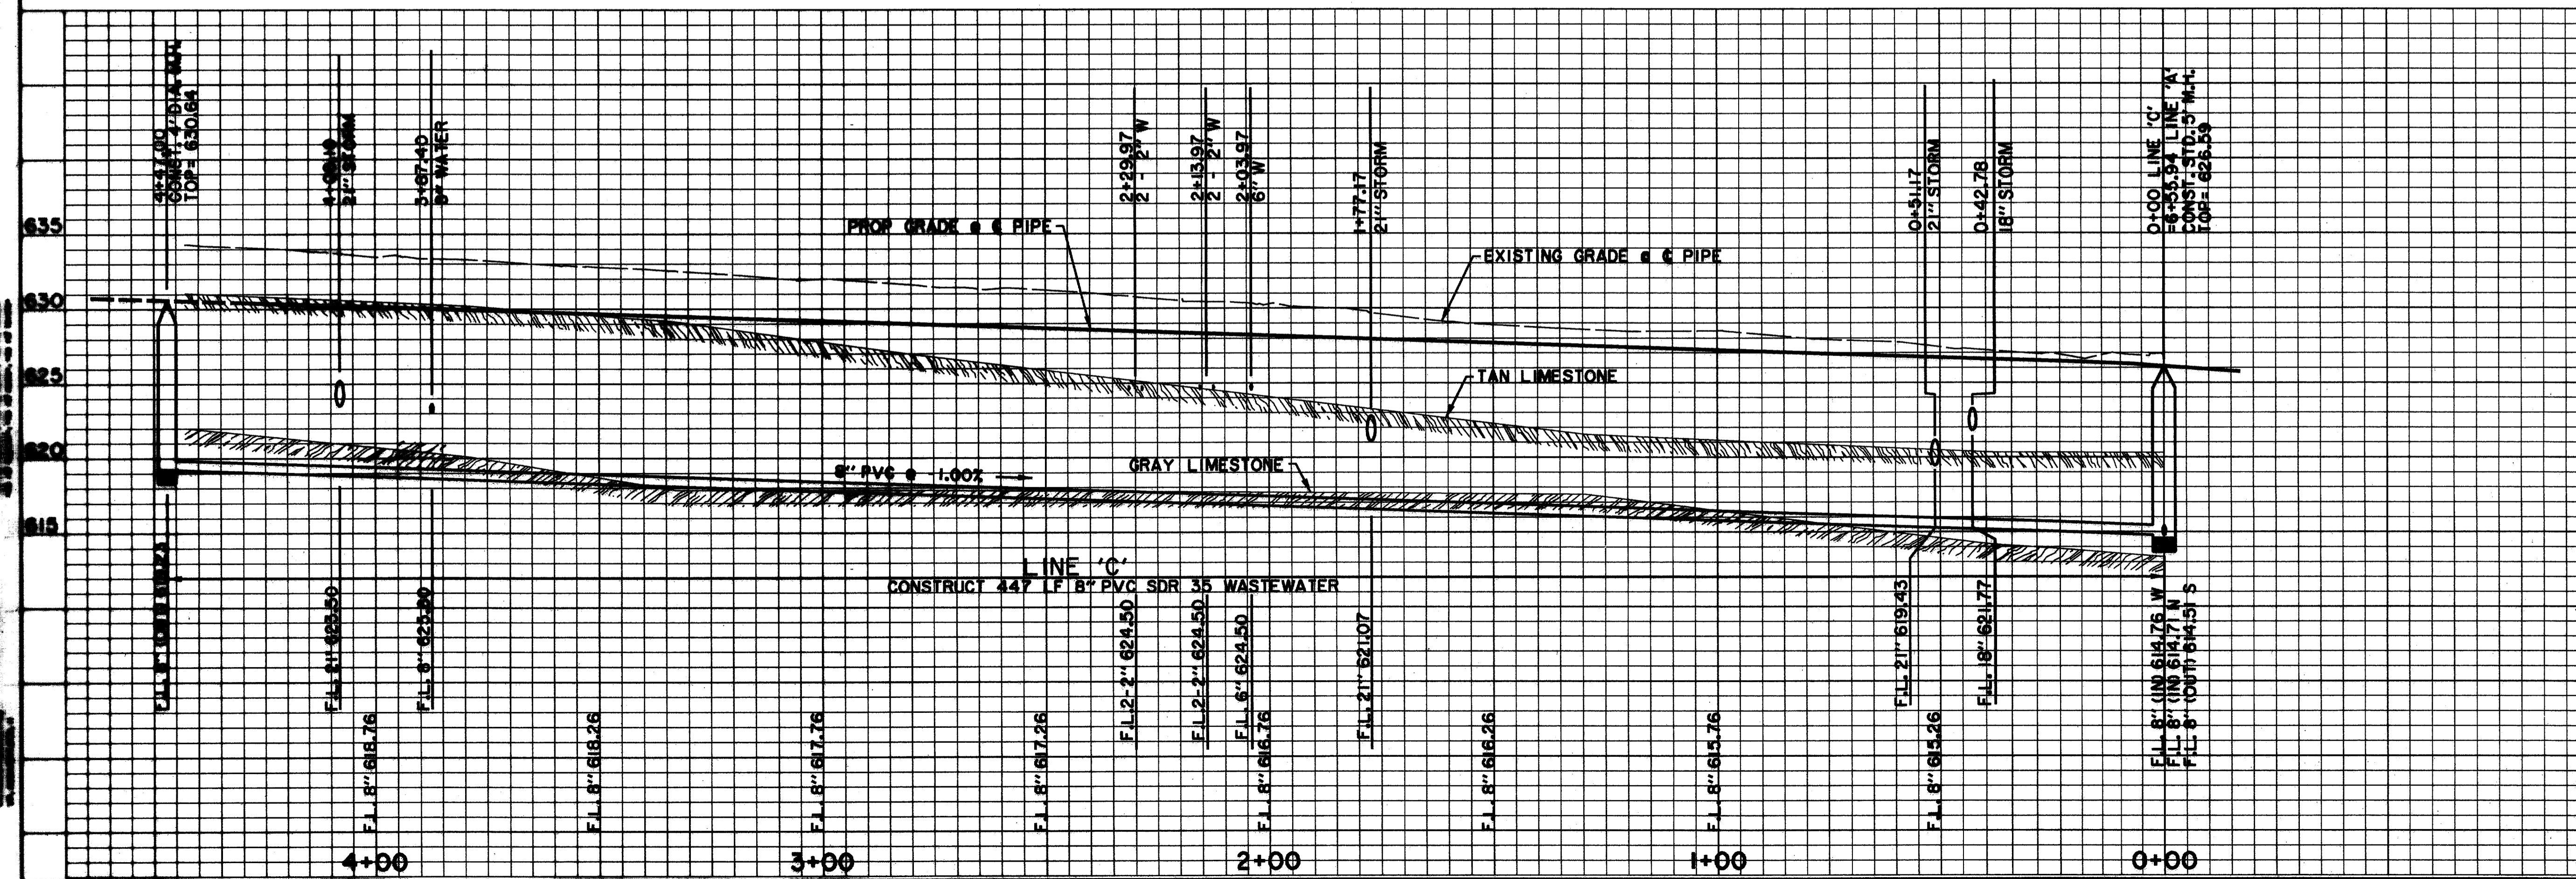

**BENCHMARKS:**

BM#2	"I" CUT AT CENTER BACK OF CURB OF INLET, 200 FEET NORTH FROM THE CENTERLINE INTERSECTION OF ADDISON CIRCLE, WEST SIDE OF QUORUM DRIVE. ELEV. 621.68
BM#3	"I" CUT AT CENTER BACK OF CURB OF INLET, 620 FEET NORTH FROM THE CENTERLINE INTERSECTION OF ADDISON CIRCLE, WEST SIDE OF QUORUM DRIVE. ELEV. 624.50

ISSUED FOR CONSTRUCTION MARCH 28, 1996

THE SEAL APPEARING ON THIS DOCUMENT WAS AUTHORIZED BY KENNETH A. ROBERTS, P.E. 55446 ON MARCH 28, 1996.

*Kenneth A. Roberts*  
3-28-96

**WASTEWATER PLAN & PROFILE**  
LINE 'C' STA. 0+00 TO STA. 4+47

**ADDISON CIRCLE**  
PHASE I PUBLIC INFRASTRUCTURE  
TOWN OF ADDISON, TEXAS

Huitt-Zollars, Inc./Engineering/Architecture  
Dallas, Fort Worth, Houston, El Paso, Phoenix, Tustin, Ontario, San Clemente

DESIGN	DRAWN	APPR.	SCALE	DATE	PROJECT NO.	NO.
HZI	HZI	KAR	H <sub>1</sub> 1"=20' V <sub>1</sub> 1"=8'	JAN 96	1822-04	96 137

H:\PROJ\182204\DWG\AUCI\WWS.DWG