


ITEM NO.	DESCRIPTION	UNIT	SHEET SUMMARY																				ITEM NO.	PROJ. TOTAL		
			SHT 42	SHT 43	SHT 44	SHT 45	SHT 46	SHT 47	SHT 48	SHT 49	SHT 50	SHT 51	SHT 52	SHT 53	SHT 54	SHT 109	SHT 121	SHT 122	SHT 123	SHT 124	SHT 125	SHT 126			SHT 127	MISC
	SCHEDULE II - STREETSCAPE IMPROVEMENTS																									
201	PEDESTRIAN BRICK PAVER MATERIALS	SF		13533	14516	7725	11148	9096	5847																201	61865
202	1" PVC SCH. 40 TREE LIGHT CONDUIT	LF																						1000	202	1000
203	2" PVC SCH. 40 STREET LIGHT CONDUIT	LF																						5250	203	5250
204	STREET LIGHT OR TREE LIGHTING PULL BOX	EA																						50	204	50
205	2" PVC SCH. 40 SLEEVE	LF	281																						205	281
206	3" PVC SCH. 40 SLEEVE	LF	509																						206	509
207	4" PVC SCH. 40 SLEEVE	LF	1641																						207	1641
208	6" PVC SCH. 40 SLEEVE	LF	815																						208	815
209	IRR. SYSTEM INCL. POWER FOR CONTROLLERS	LS																					1	209	1	
210	TREE FENCE	LF																					4964	210	4964	
211	STANDARD TREE GRATE	EA														28									211	28
212	ITEM DELETED	NA																							212	NA
213	ITEM DELETED	NA																							213	NA
214	ITEM DELETED	NA																							214	NA
215	ITEM DELETED	NA																							215	NA
216	ITEM DELETED	NA																							216	NA
217	4" PVC SCH. 40 PERFORATED DRAIN SYSTEM	LF								945	887	504	788	915	1084		1160	875	580	840	940	720	480	217	5123	
218	BENCH A, CUSTOM 5' DBL. STD. BLACK BOWERY	EA														3	4	4						218	11	
219	BENCH B, 5' STD. BLACK BOWERY BENCH	EA														2		10		4				219	16	
220	BENCH C, 6' GLOSSY BLACK (3 SUPPORTS) EXPO	EA																	4	8	5	2		220	19	
221	BOWERY TRASH RECEPTACLE 'A'	EA														2		5		3	3	1		221	11	
222	TRASH RECEPT. 'B', ULTRUM EXP. METAL POLE	EA																	3	4				222	7	
223	TRASH RECEPT. 'C', ULTRUM EXP. METAL POLE	EA																			4	2		223	6	
224	BIKE RACK	EA															1	5	3	7	4	2		224	22	
225	ITEM DELETED	EA																						225	NA	
226	GARDEN PLANTER STYLE 006	EA														6		4						226	10	
227	RED OAK, 200 G., 5"-6" CAL., 16'-18' HT., 10"-12'	EA														30	48	44						227	122	
228	LIVE OAK, 200 G., 5"-6" CAL., 16'-18' HT., 10"-12'	EA														28			32	35				228	95	
229	CHANTICLEER PEAR, 4" CAL., 14'-16' HT., 6' SPR.	EA																			23	15		229	38	
230	DWARF YAUPON HOLLY, 1 GAL.	EA														450	1152	660	832	910	368	240		230	4612	
231	NEW MEXICO AGAVE, 1 GAL.	EA																			8	6		231	14	
232	AUTUMN ASTER, 4" CONT.	EA																			15	10		232	25	
233	SHASTA DAISY, 4" CONT.	EA															150		106	120				233	376	
234	RED RUM DAYLILY, 4" CONT.	EA														20		28		16	12			234	76	
235	STELLA DE ORO DAYLILY, 4" CONT.	EA															92		44	44				235	180	
236	MIXED DAYLILY, 4" CONT.	EA														50		75						236	125	
237	RED YUCCA, 1 GAL.	EA																			14	8		237	22	
238	BEARDED IRIS PURPLE NO. 1 BULB	EA														20	250	28	80	96	56	40		238	570	
239	BEARDED IRIS YELLOW NO. 1 BULB	EA														50	184	75	63	61				239	433	
240	BEARDED IRIS WHITE NO. 1 BULB	EA																			32	20		240	52	
241	JAPANESE IRIS BLUE NO. 1 BULB	EA																	22	24				241	46	
242	SPIDER LILY, 4" CONT.	EA														10	96	14	64	70				242	254	
243	DAFFODIL MIXED NO. 1 BULB	EA														155		234						243	389	
244	DAFFODIL 'FEB. GOLD' NO. 1 BULB	EA														70	50	98	110	120	8	5		244	461	
245	DAFFODIL 'PEEPING TOM' NO. 1 BULB	EA															69		88	88				245	245	
246	THRIFT, 4" CONT.	EA														20		28			8	5		246	61	
247	ADAMS NEEDLE STARBURST, 1 GAL.	EA																			16	10		247	26	
248	PURPLE HEART, 4" CONT.	EA														25		40						248	65	
249	BERMUDA SOLID SOD	SF														5676	405	7190						249	13300	
250	WEeping LOVE GRASS	SF														7100	2900		9100			3820		250	22920	
251	RESTORE IRRIG. @ CONF. CENTER	LS																					1	251	1	
252	BALL & BURLAP EX. N.R.S. HOLLY & REPLANT	EA															62						8	252	70	
253	NELLIE R. STEVENS HOLLY, 6" CONT. GROWN	EA															6							253	6	
254	REM. & REUSE EX. STEEL LANDSCAPE EDGING	LS															1							254	1	
255	2" WIDE X 6" THICK R.C. FLUME, 3000 PSI	LS																						255	1	
256	3" PVC SCH 40 TREE LIGHT CONDUIT	LF																					1000	256	1000	
257	ITEM DELETED	NA																						257	NA	
258	INSTALL PEDESTRIAN BRICK PAVER	SF		13533	14516	7725	11148	9096	5847															258	61865	
259	STREET LIGHT FOUNDATION	EA																						259	56	
260	CAP FOR LIGHT BASE	EA																						260	56	
261	2" PVC SCH. 40 TREE LIGHT CONDUIT	LF																						261	2600	
262	SALMON PINK CANNA, NO. 1 RHIZOMES	EA																				32	24	262	56	

RECORD DRAWING 5/1/98

ISSUED FOR CONSTRUCTION
MARCH 28, 1996

THE SEAL APPEARING ON THIS DOCUMENT WAS AUTHORIZED BY
KENNETH A. ROBERTS, P.E. 55446
ON MARCH 28, 1996.

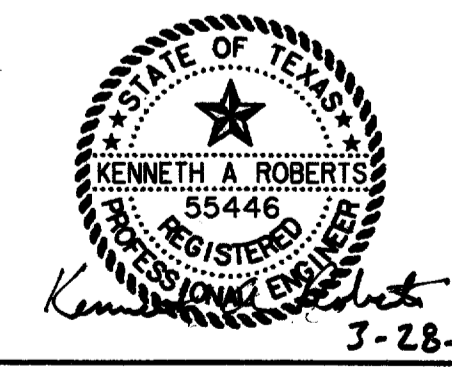

QUANTITY SUMMARY SHEET					
ADDISON CIRCLE					
PHASE I PUBLIC INFRASTRUCTURE					
TOWN OF ADDISON, TEXAS					
Huitl-Zollars, Inc./Engineering/Architecture Dallas, Fort Worth, Houston, El Paso, Phoenix, Tustin, Ontario, San Clemente					
DESIGN	DRAWN	APPR.	SCALE	DATE	PROJECT NO.
HZI	HZI	KAR	NONE	JAN 96	1822-04
					3
					137