


ITEM NO.	DESCRIPTION	UNIT	SHEET SUMMARY													ITEM NO.	PROJ. TOTAL				
			SHT 47	SHT 105	SHT 106	SHT 107	SHT 108	SHT 109	SHT 110	SHT 111	MISC										
SCHEDULE VII - BOSQUE PARK IMPROVEMENTS																					
601	CLEARING, PRUNING & GRADING	SF													37500						
602	REL. EXIST. TREE FROM QUORUM MEDIAN	EA													18						
603	ITEM DELETED	NA																			
604	METRO DRINKING FOUNTAIN, DBL. ARM	EA													2						
605	4" 3000 PSI R.C. SUBBASE (SIDEWALK)	SF	4449																		
606	PEDESTRIAN BRICK PAVER MATERIALS	SF	4449																		
607	INSTALL PEDESTRIAN BRICK PAVER	SF	4449																		
SCHEDULE VIII - ELECTRICAL IMPROVEMENTS																					
701	6E6 CONC. ENC. DUCT, 6" DIA. TYPE DB PVC	LF		360		345		459		484		529		144		479					
702	4E6 CONC. ENC. DUCT, 6" DIA. TYPE DB PVC	LF			180		34		120							19					
703	TUE STANDARD 4-WAY MANHOLE	EA		2		1		1		2		1				2					
704	TUE STANDARD 2-WAY MANHOLE	EA										1									
705	REINF. 5' X 5' X 6" CONC. PAD AROUND MH	EA										2									
706	TUE STD. PRECAST 25 KV SWITCH PAD	EA				1		1		1											
707	6" DIA. TYPE DB PVC 90 DEGREE SWEEP - 36"	EA				4		4		4			1								
708	10E6 CONC. ENC. DUCT, 6" DIA. TYPE DB PVC	LF		26						45					64						
709	10E6 CONC. ENC. DUCT IN 42" ENCASEMENT PIPE	LF		70																	
710	6" DIA. TYPE DB PVC 90 DEGREE SWEEP - 60"	EA				8		4													
711	2" SCH. 40 PVC CONDUIT	LF				376				404											

RECORD DRAWING 5/1/98

ISSUED FOR CONSTRUCTION
MARCH 28, 1996

THE SEAL APPEARING ON THIS DOCUMENT WAS AUTHORIZED BY
KENNETH A. ROBERTS, P.E. 55446
ON MARCH 28, 1996.

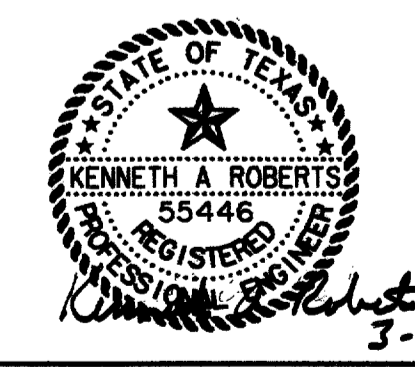

QUANTITY SUMMARY SHEET					
ADDISON CIRCLE					
PHASE I PUBLIC INFRASTRUCTURE					
TOWN OF ADDISON, TEXAS					
Huitt-Zollars, Inc./Engineering/Architecture Dallas, Fort Worth, Houston, El Paso, Phoenix, Tustin, Ontario, San Clemente					
DESIGN	DRAWN	APPR.	SCALE	DATE	PROJECT NO.
HZ1	HZ1	KAR	NONE	JAN 96	1822-04
					NO.
					6
					137