
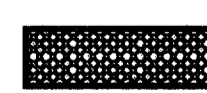

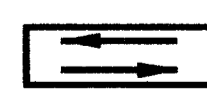




DALLAS AREA RAPID TRANSIT
DALLAS RIGHT-OF-WAY TRANSIT

DRAINAGE & UTILITY CONSTRUCTION BETWEEN QUORUM DRIVE AND THE DALLAS NORTH TOLLWAY CAN COMMENCE UPON NOTICE TO PROCEED.


LEGEND

-  TEMPORARY DETOUR (ASPHALT)
-  UNDER CONSTRUCTION
-  COMPLETED CONSTRUCTION
-  TRAFFIC FLOW DURING CONSTRUCTION
-  CONSTRUCT AT ANY TIME AFTER COMPLETION OF UTILITIES
-  CHANNELIZING DEVICE

RECORD DRAWING 5/1/98

ISSUED FOR CONSTRUCTION
MARCH 28, 1996

THE SEAL APPEARING ON THIS DOCUMENT WAS AUTHORIZED BY KENNETH A. ROBERTS, P.E. 55446 ON MARCH 28, 1996.

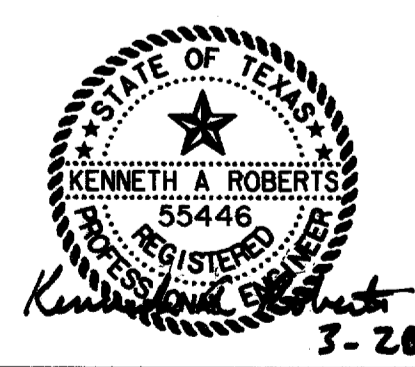

CONSTRUCTION SEQUENCING						
STAGE C						
ADDISON CIRCLE						
PHASE I PUBLIC INFRASTRUCTURE						
TOWN OF ADDISON, TEXAS						
<small>Huitt-Zollars, Inc./Engineering/Architecture Dallas, Fort Worth, Houston, El Paso, Phoenix, Tustin, Ontario, San Clemente</small>						
DESIGN	DRAWN	APPR.	SCALE	DATE	PROJECT NO.	NO.
HZI	HZI	KAR	1"=50'	JAN 96	1822-04	11
						137