

NOTE:
EXISTING CURBS TO BE REMOVED
AND CONSTRUCTION OF PROPOSED
CURB NEEDS TO BE SEQUENCED AS
NECESSARY FOR DETOURS AND
TRAFFIC FLOW.

ADDISON CIRCLE

WITT PLACE

PASCHAL PLACE

MORRIS AVENUE

GOODMAN AVENUE

QUORUM DRIVE


QUORUM DRIVE

DALLAS AREA RAPID TRANSIT

DRAINAGE & UTILITY CONSTRUCTION
BETWEEN QUORUM DRIVE AND THE
DALLAS NORTH TOLLWAY CAN COMMENCE
UPON NOTICE TO PROCEED.

RECORD DRAWING 5/1/98

ISSUED FOR CONSTRUCTION
MARCH 28, 1996
THE SEAL APPEARING ON THIS
DOCUMENT WAS AUTHORIZED BY
KENNETH A. ROBERTS, P.E. 55446
ON MARCH 28, 1996.

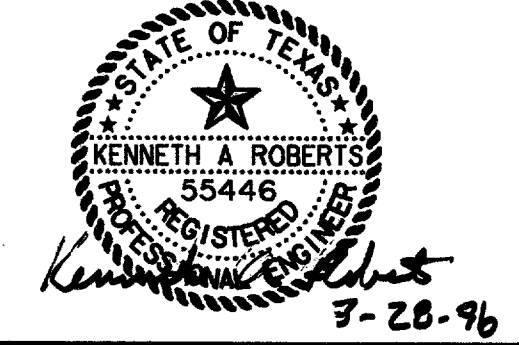

LEGEND

- TEMPORARY DETOUR (ASPHALT)
- UNDER CONSTRUCTION
- COMPLETED CONSTRUCTION
- TRAFFIC FLOW DURING CONSTRUCTION
- CONSTRUCT AT ANY TIME AFTER COMPLETION OF UTILITIES
- CHANNELIZING DEVICE

CONSTRUCTION SEQUENCING STAGE E						
ADDISON CIRCLE						
PHASE I PUBLIC INFRASTRUCTURE						
TOWN OF ADDISON, TEXAS						
Huitl-Zollars, Inc./Engineering/Architecture Dallas, Fort Worth, Houston, El Paso, Phoenix, Tustin, Ontario, San Clemente						
DESIGN	DRAWN	APPR.	SCALE	DATE	PROJECT NO.	NO.
HZ1	HZ1	KAR	1"=50'	JAN 96	1822-04	13 137