


NOTE:
PROFILE STATIONING IS
ALONG THE CURB LINE OR
PGL LINE ON PAVING PLANS.

RECORD DRAWING 5/1/98

ISSUED FOR CONSTRUCTION
MARCH 28, 1996
THE SEAL APPEARING ON THIS
DOCUMENT WAS AUTHORIZED BY
KENNETH A. ROBERTS, P.E. 55446
ON MARCH 28, 1996.

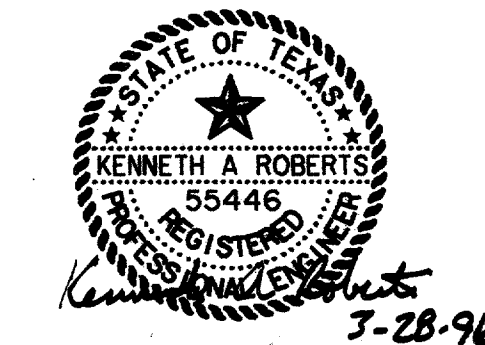

**ROUNDABOUT PROFILES
ENTERING AND EXITING EXTERIOR LEGS
ADDISON CIRCLE
PHASE I PUBLIC INFRASTRUCTURE
TOWN OF ADDISON, TEXAS**

Huitt-Zollars, Inc./Engineering/Architecture
Dallas, Fort Worth, Houston, El Paso, Phoenix, Tucson, Ontario, San Clemente

DESIGN	DRAWN	APPR.	SCALE	DATE	PROJECT NO.	NO.
HZI	HZI	KAR	H _v 1"=20' V _v 1"=6'	JAN 96	1822-04	21A 137