


NOTE:  
 PROFILE STATIONING IS  
 ALONG THE CURB LINE OR  
 PGL LINE ON PAVING PLANS.

EAST CURB QUORUM DR.  
 PROFILE 'F'

RECORD DRAWING 5/1/98

ISSUED FOR CONSTRUCTION  
 MARCH 28, 1996

THE SEAL APPEARING ON THIS  
 DOCUMENT WAS AUTHORIZED BY  
 KENNETH A. ROBERTS, P.E. 55446  
 ON MARCH 28, 1996.

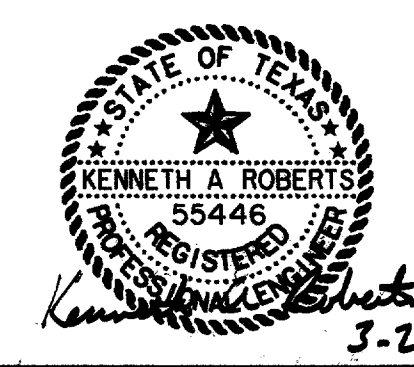

**ROUNDABOUT PROFILES**  
 ENTERING AND EXITING EXTERIOR LEGS  
**ADDISON CIRCLE**  
 PHASE I PUBLIC INFRASTRUCTURE  
 TOWN OF ADDISON, TEXAS

Huiji-Zollars, Inc./Engineering/Architecture  
 Dallas, Fort Worth, Houston, El Paso, Phoenix, Tustin, Ontario, San Clemente

DESIGN	DRAWN	APPR.	SCALE	DATE	PROJECT NO.	NO.
HZI	HZI	KAR	Ht 1"=20' Vt 1"=6'	JAN 96	1822-04	21B 137