


TYPICAL STREET INTERSECTION BRICK PLAN
 MORRIS AVENUE/WITT PLACE
 ADDISON CIRCLE/WITT PLACE
 MORRIS AVENUE/PASCHAL PLACE
 GOODMAN AVENUE/PASCHAL PLACE
 SCALE: 1" = 10'

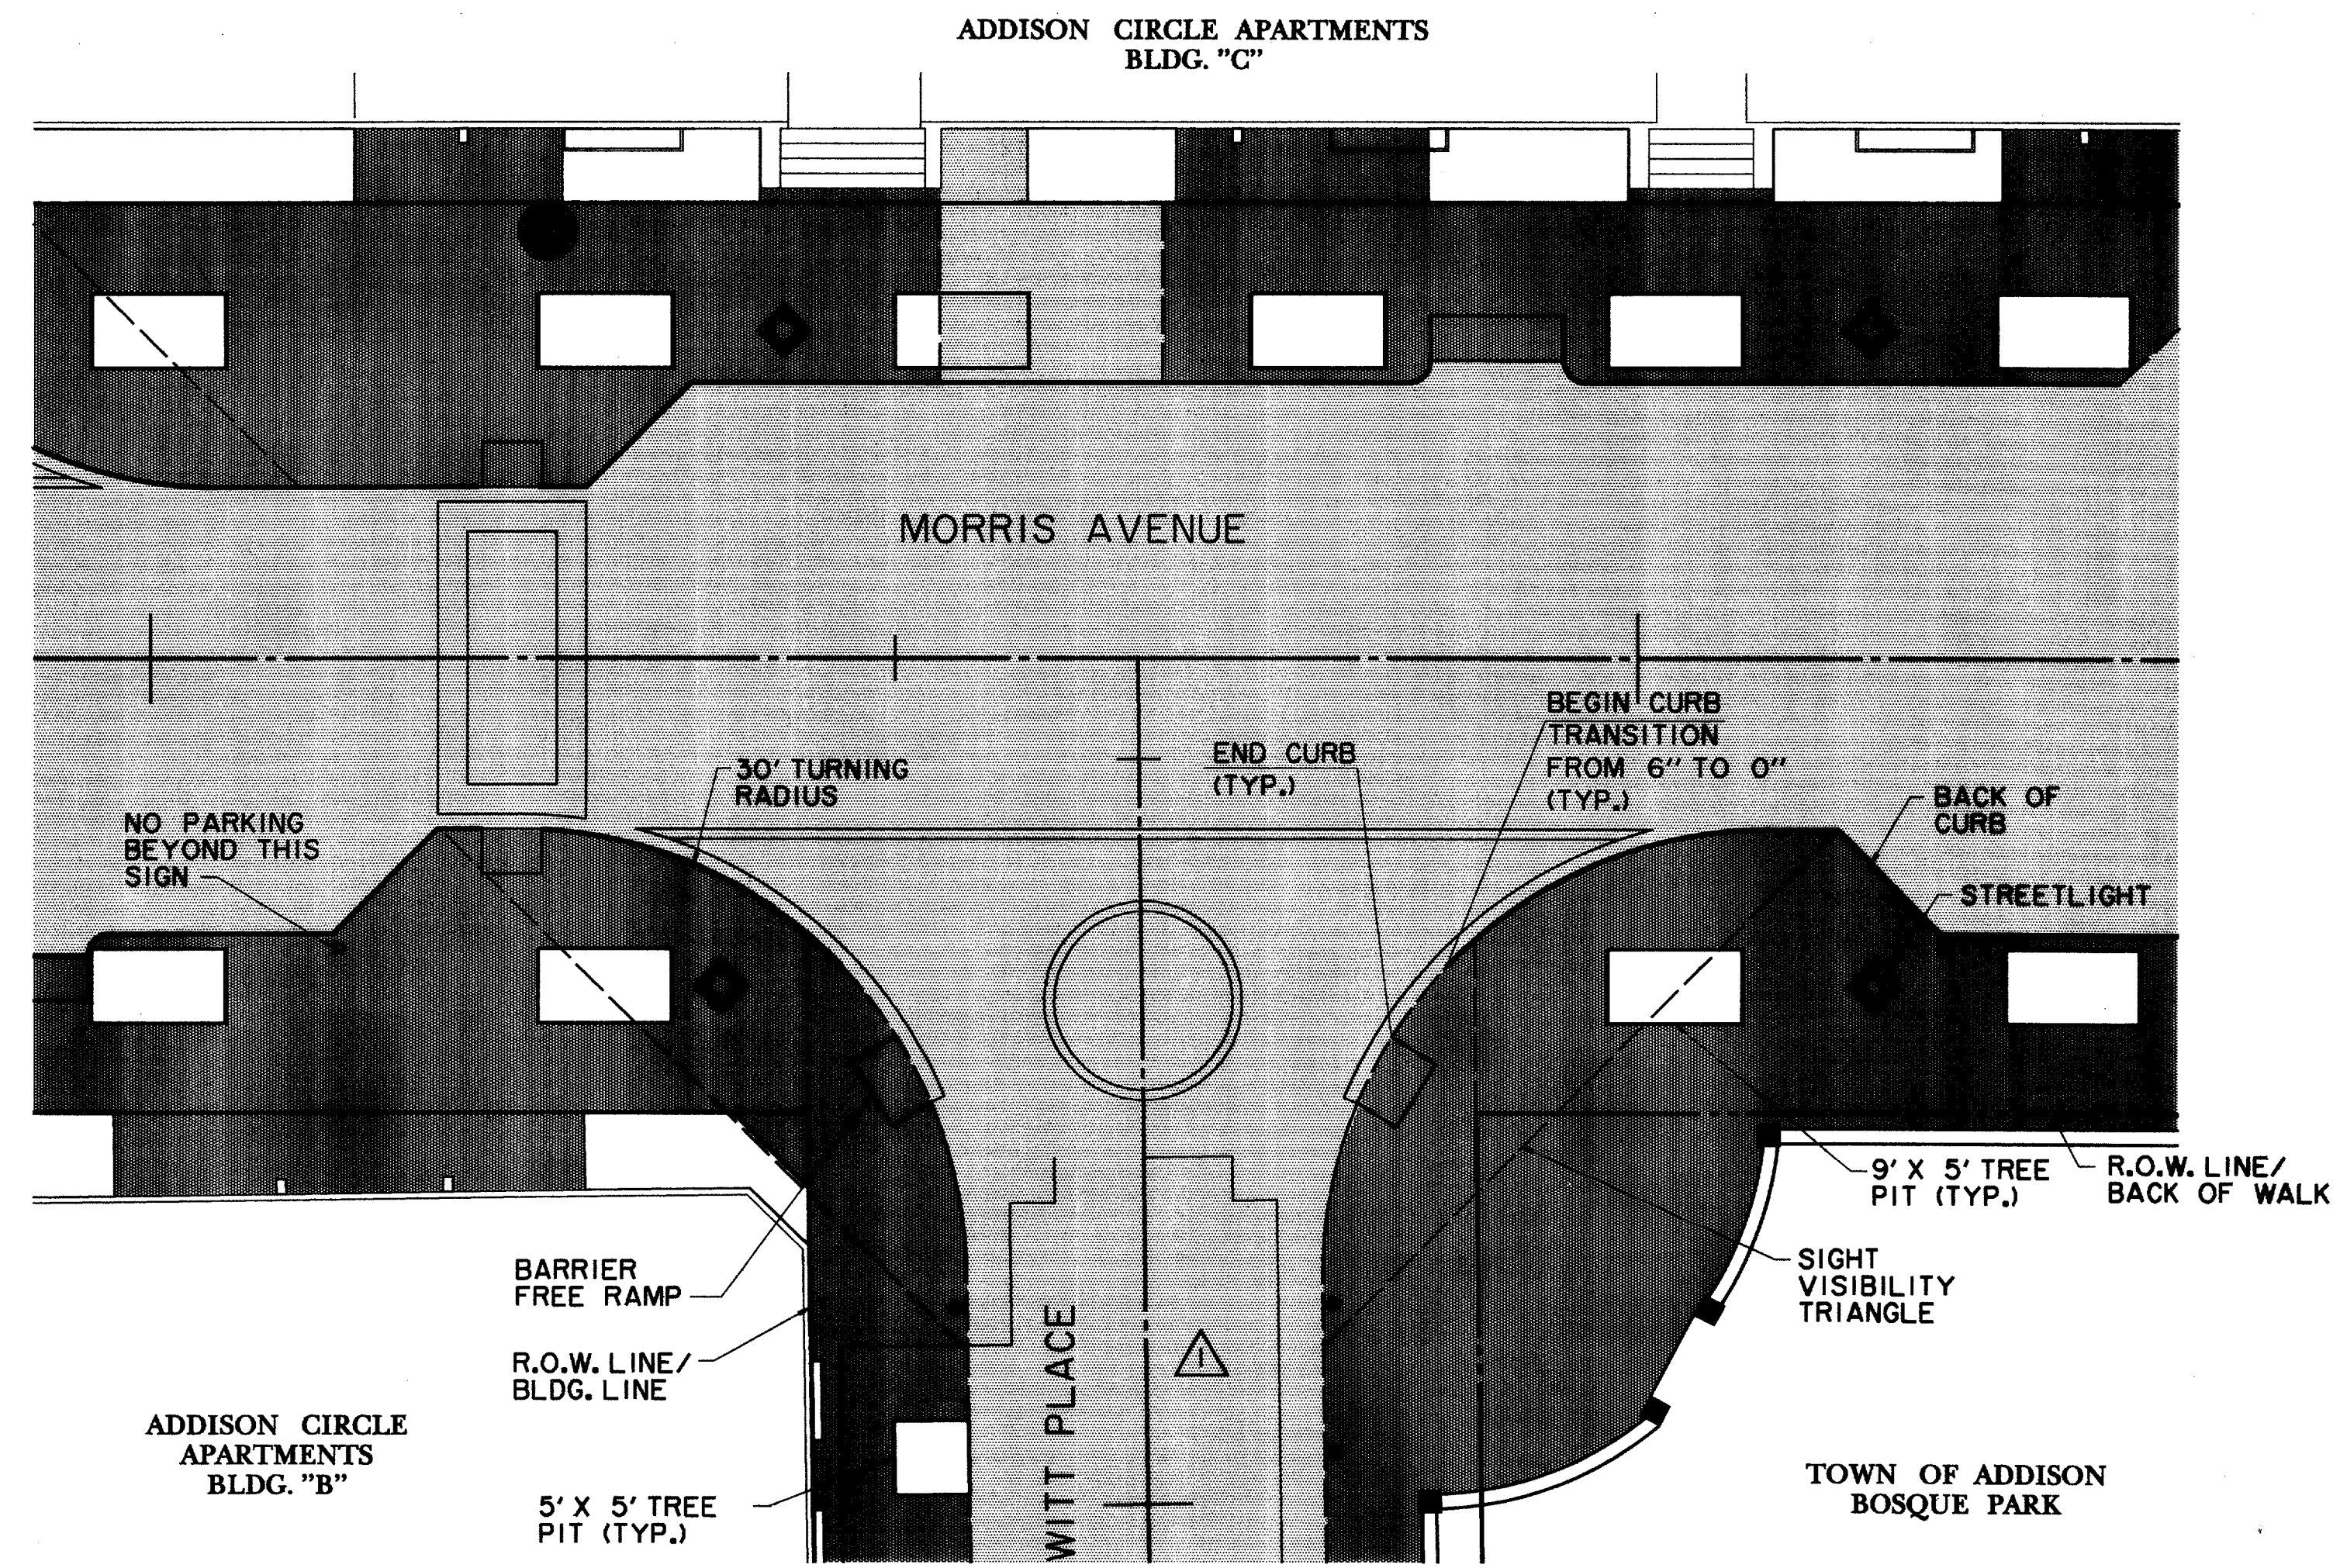

TYPICAL STREET INTERSECTION PAVEMENT PLAN
 MORRIS AVENUE/WITT PLACE
 ADDISON CIRCLE/WITT PLACE
 MORRIS AVENUE/PASCHAL PLACE
 GOODMAN AVENUE/PASCHAL PLACE
 SCALE: 1" = 10'

ISSUED FOR CONSTRUCTION
 MARCH 28, 1996

THE SEAL APPEARING ON THIS DOCUMENT WAS AUTHORIZED BY
 KENNETH A. ROBERTS, P.E. 55446
 ON MARCH 28, 1996.

3-28-96

| PAVING DETAILS | | | | | | |
|--|-------|-------|--------|--------|-------------|-----|
| ADDISON CIRCLE | | | | | | |
| PHASE I PUBLIC INFRASTRUCTURE | | | | | | |
| TOWN OF ADDISON, TEXAS | | | | | | |
| Huijt-Zollars, Inc./Engineering/Architecture Dallas, Fort Worth, Houston, El Paso, Phoenix, Tustin, Ontario, San Clemente | | | | | | |
| DESIGN | DRAWN | APPR. | SCALE | DATE | PROJECT NO. | NO. |
| HZI | HZI | KAR | N.T.S. | JAN 96 | 1822-04 | 31 |
| | | | | | | 137 |

RECORD DRAWING 5/1/98
 DELETED DETECTABLE WARNING STRIPS 11/15/96