




8+50

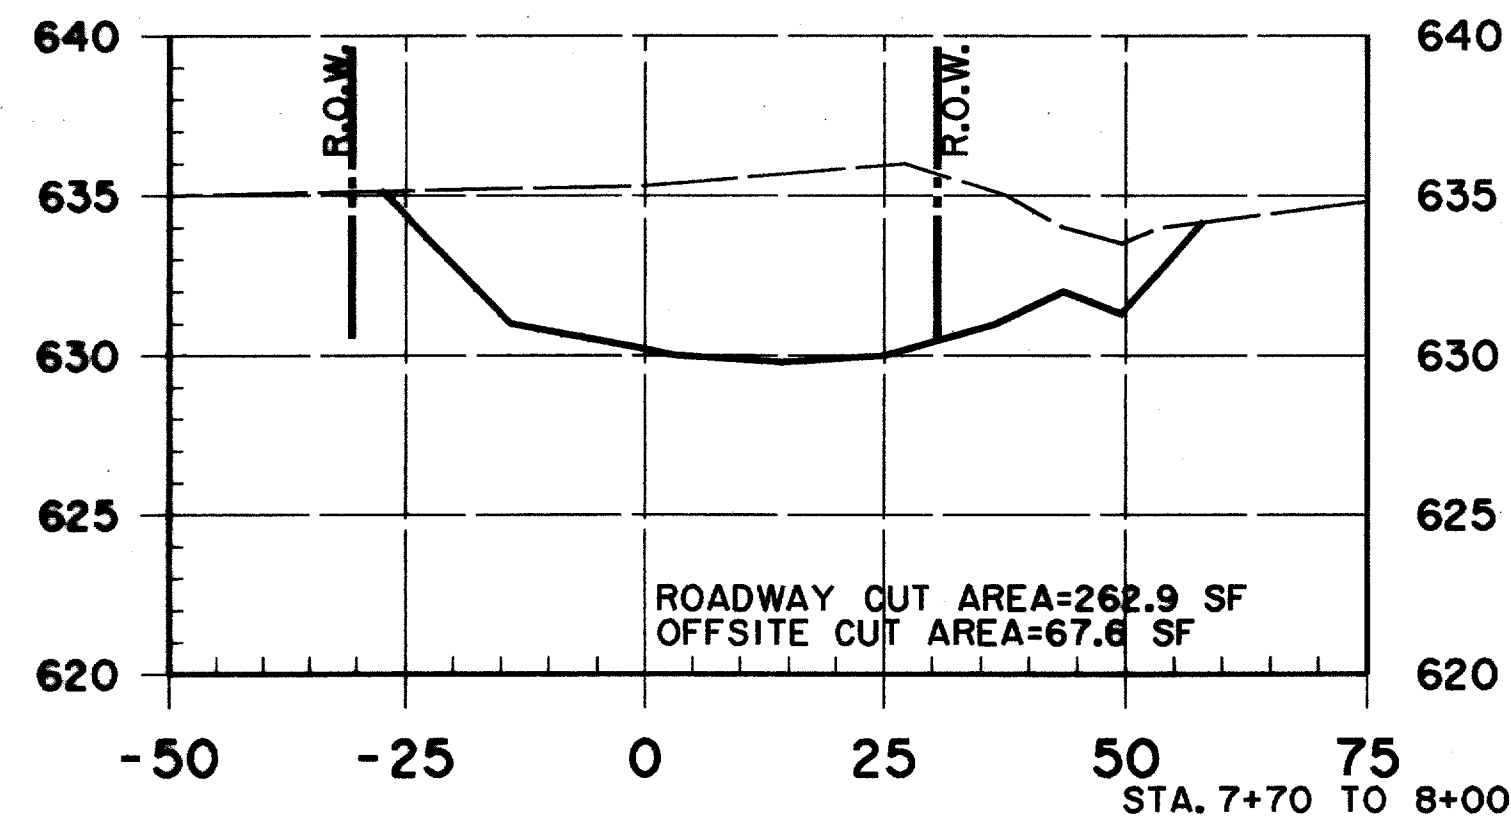


8+00

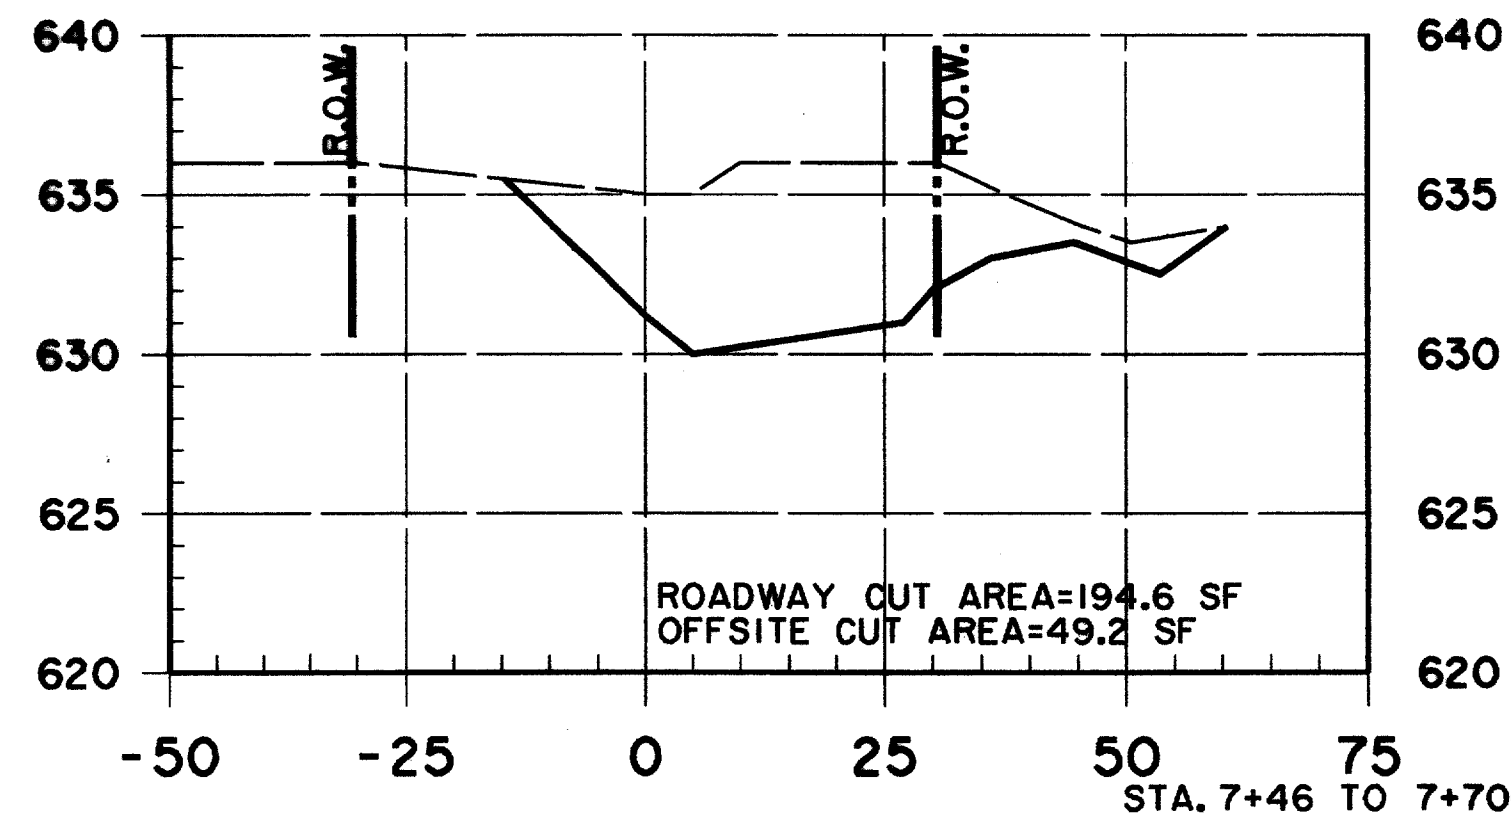


7+70

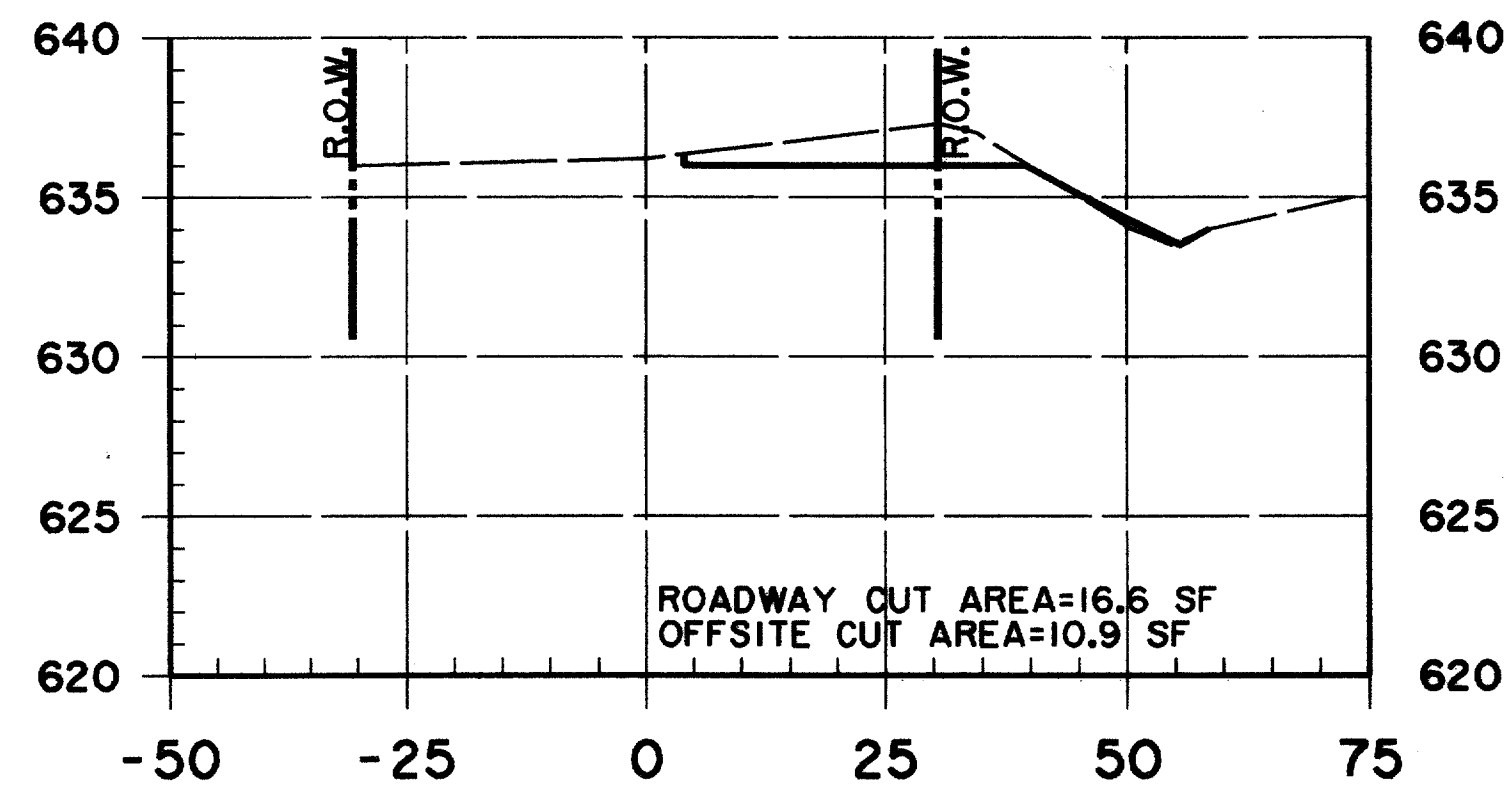


7+46

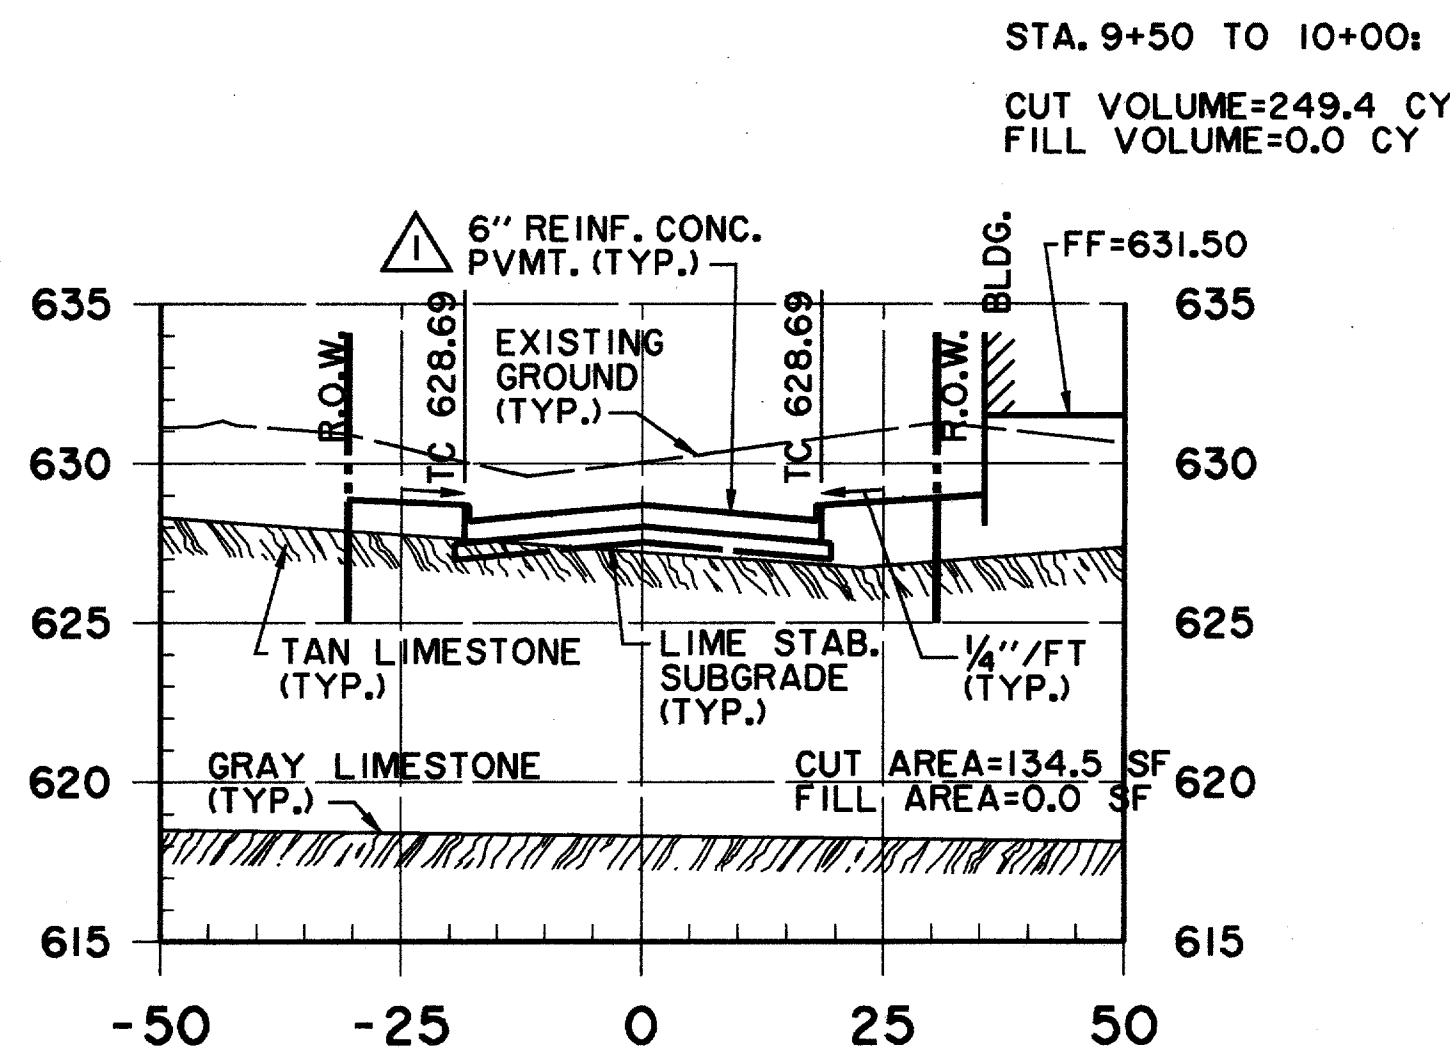


9+50

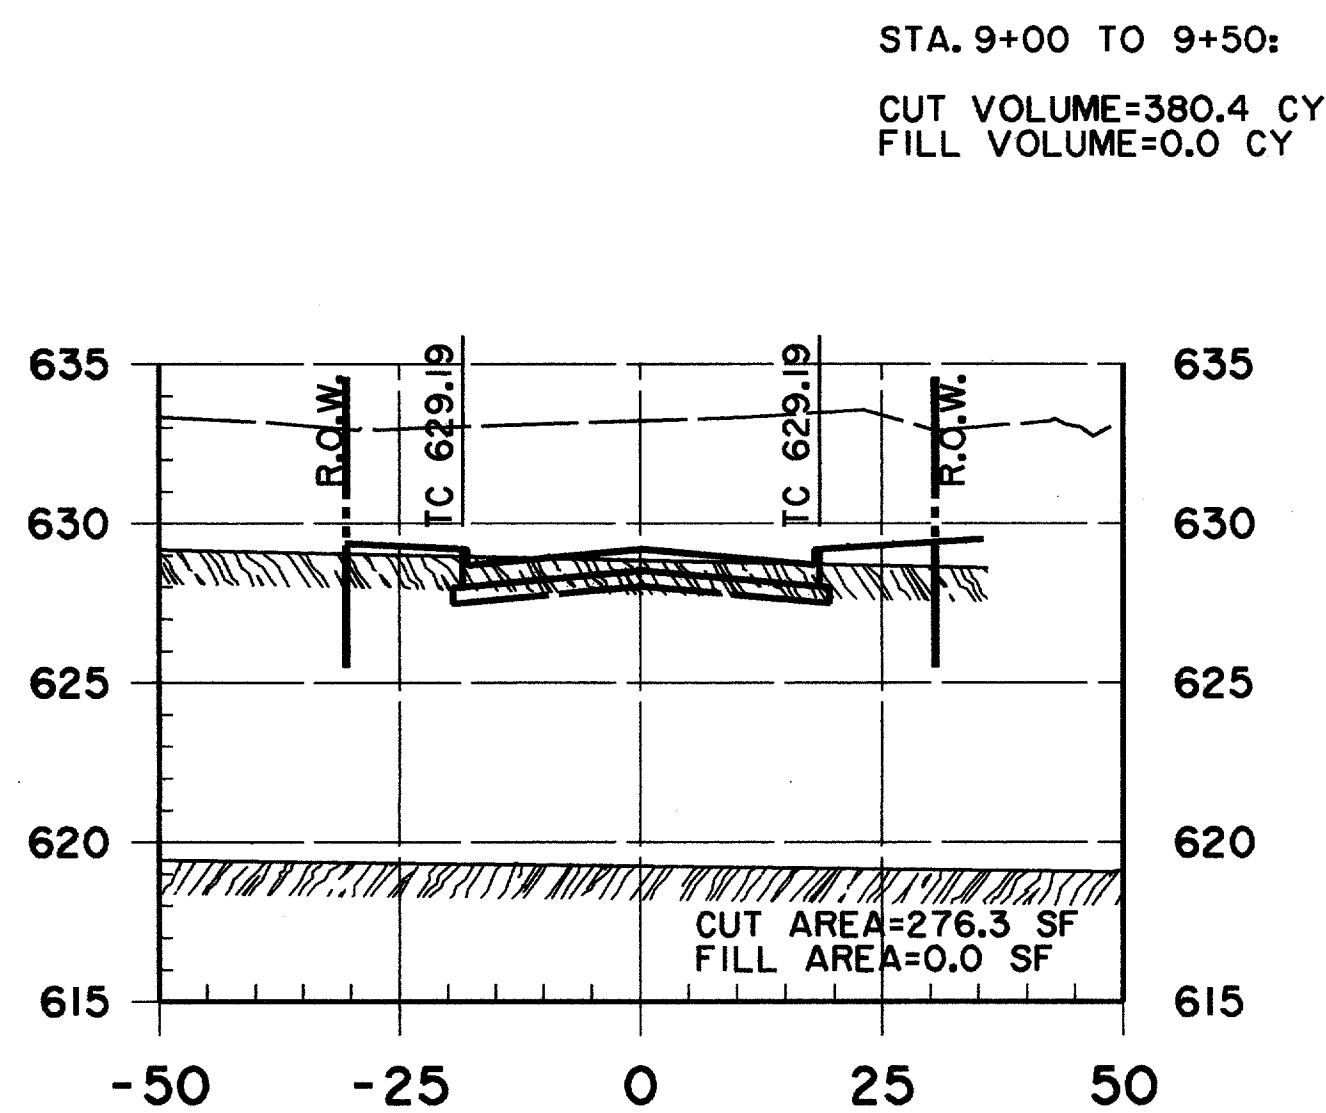

9+00

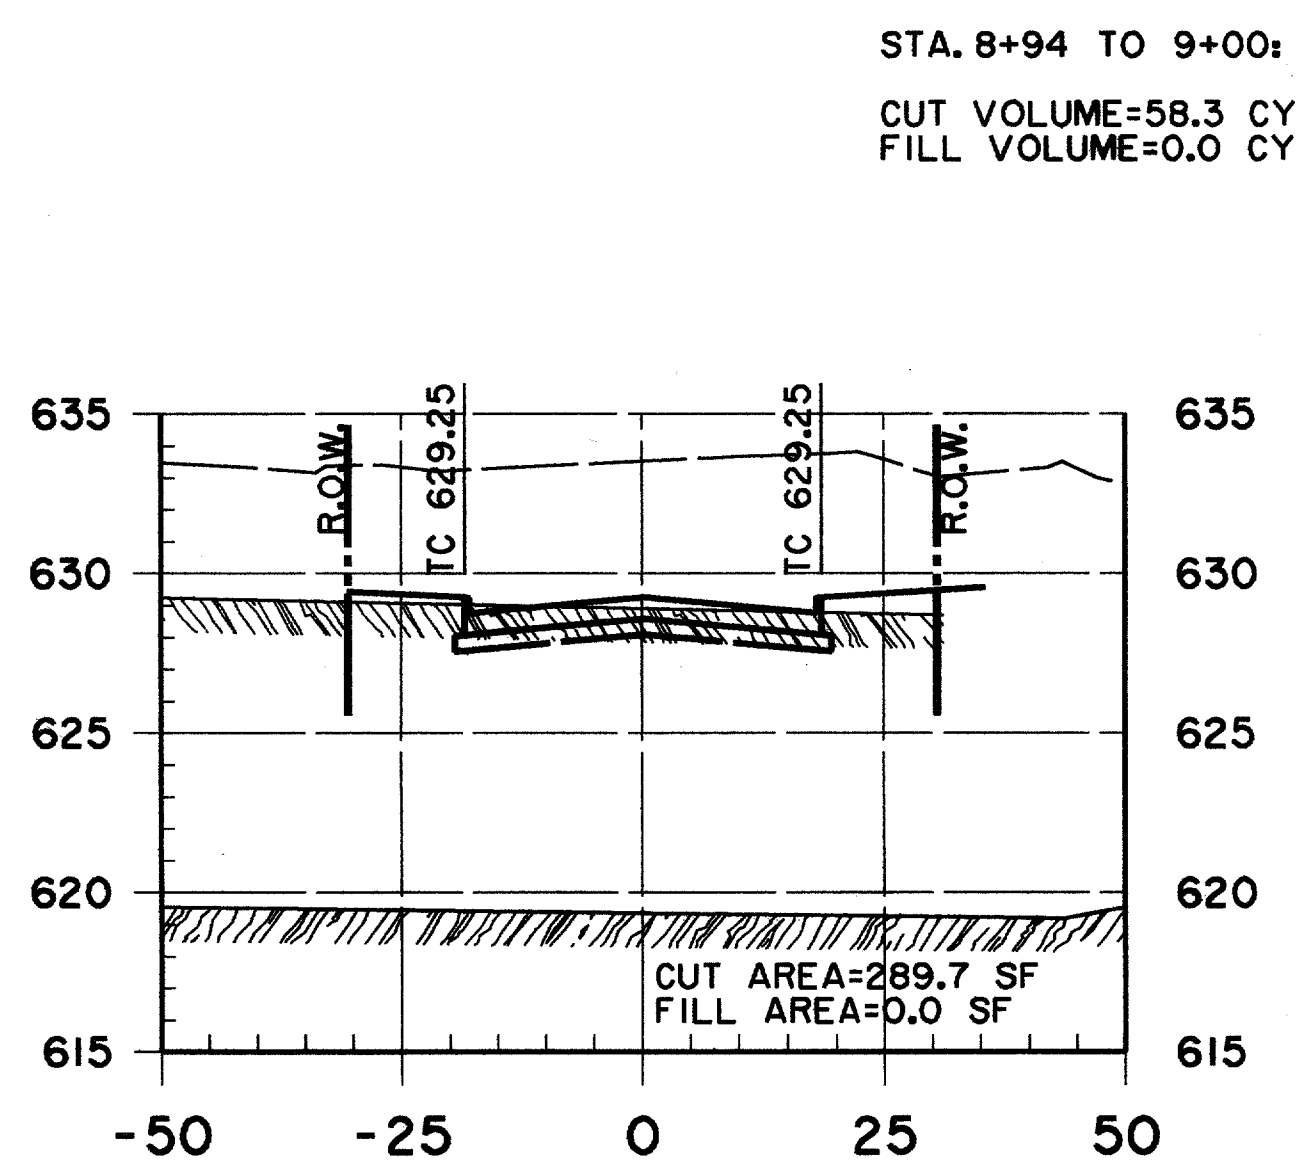


8+94.44

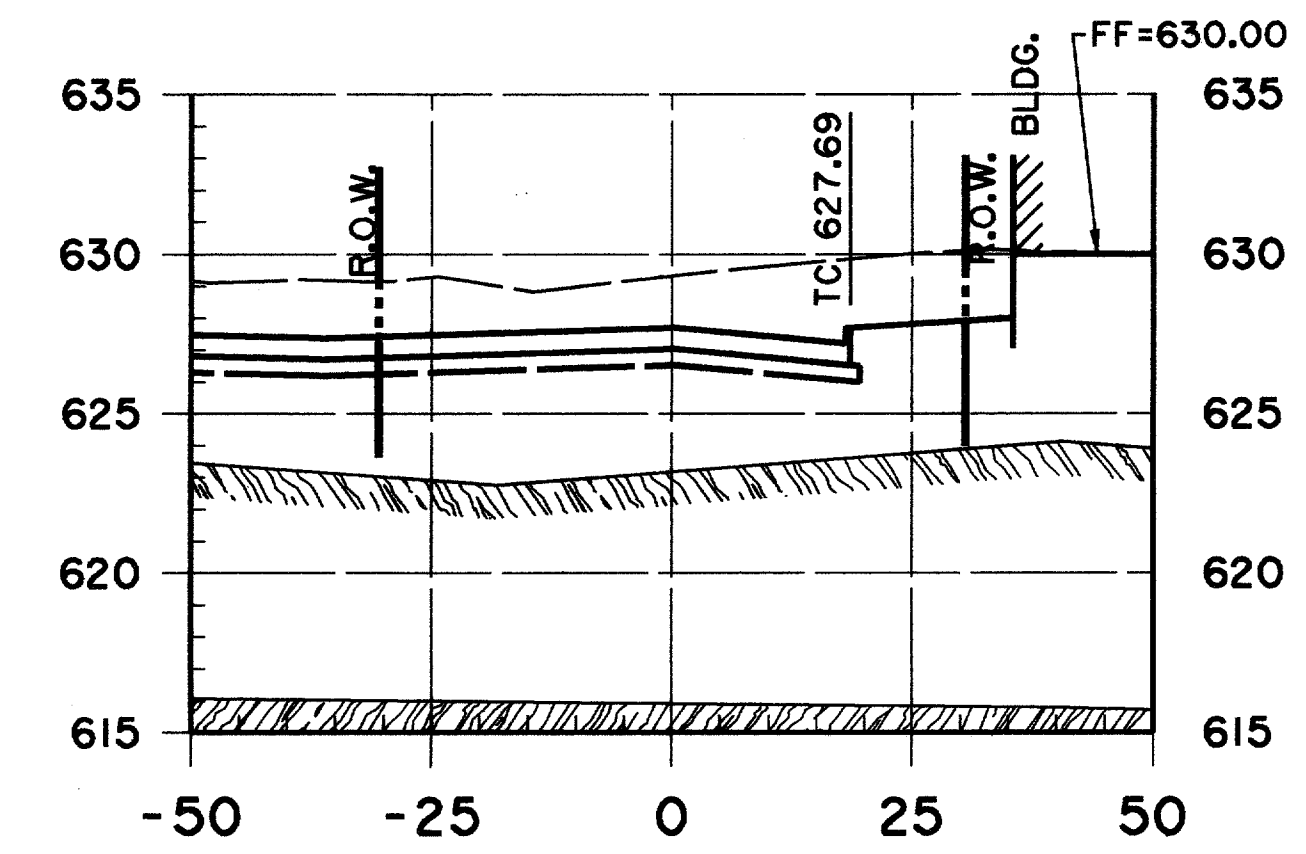


10+50.50

WEST EDGE OF PVMT., PASCHAL PLACE

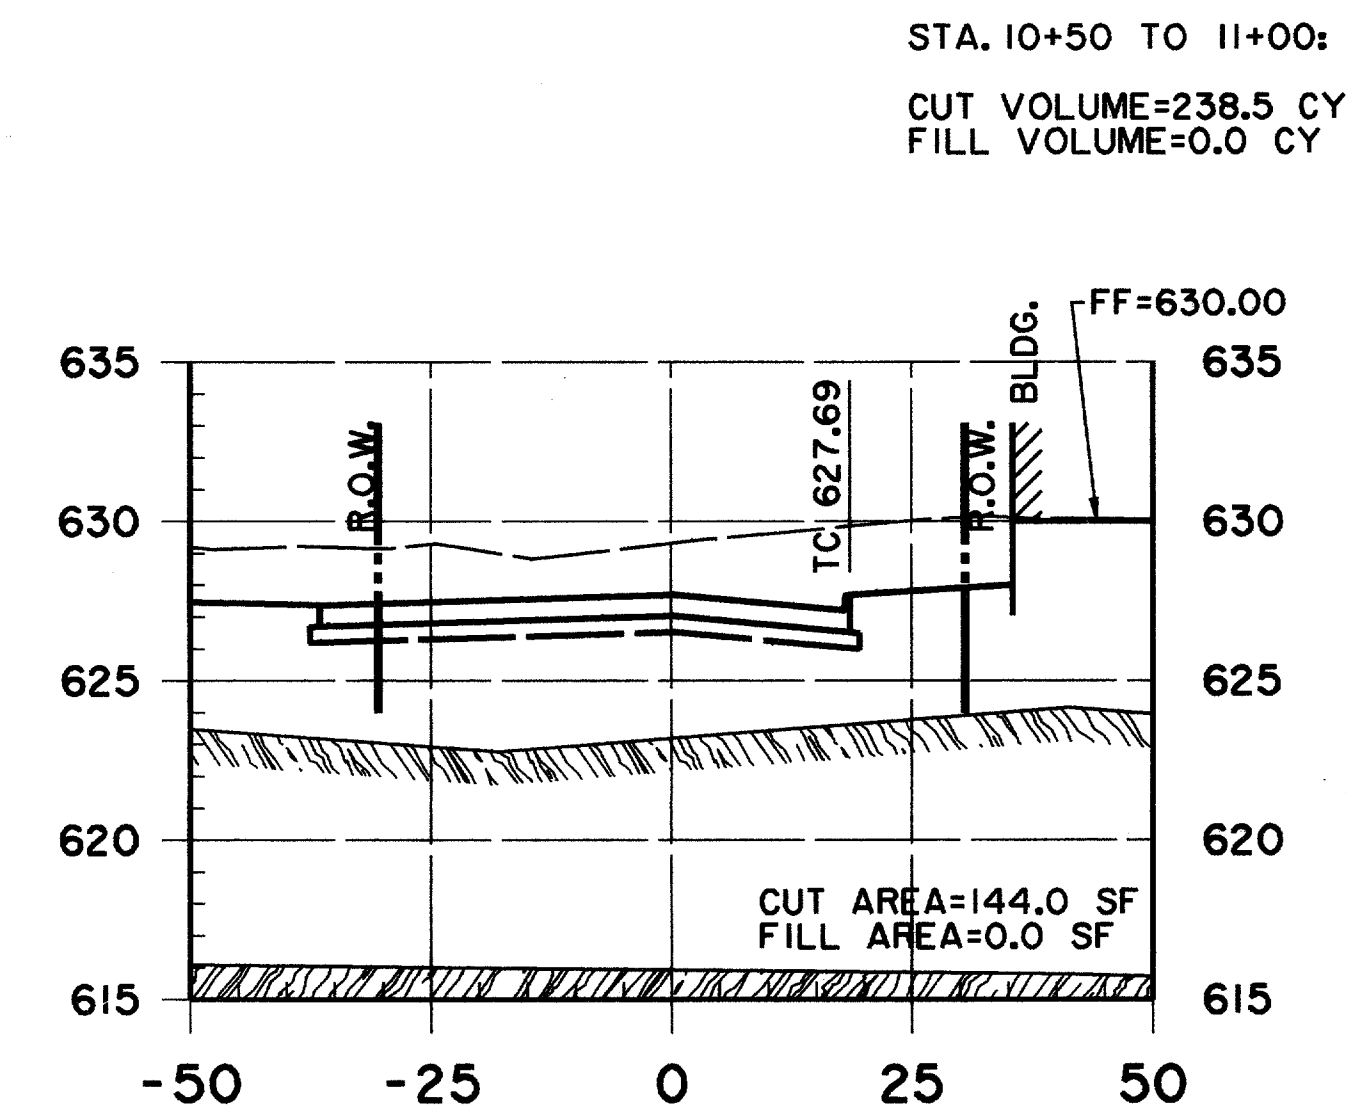


10+50

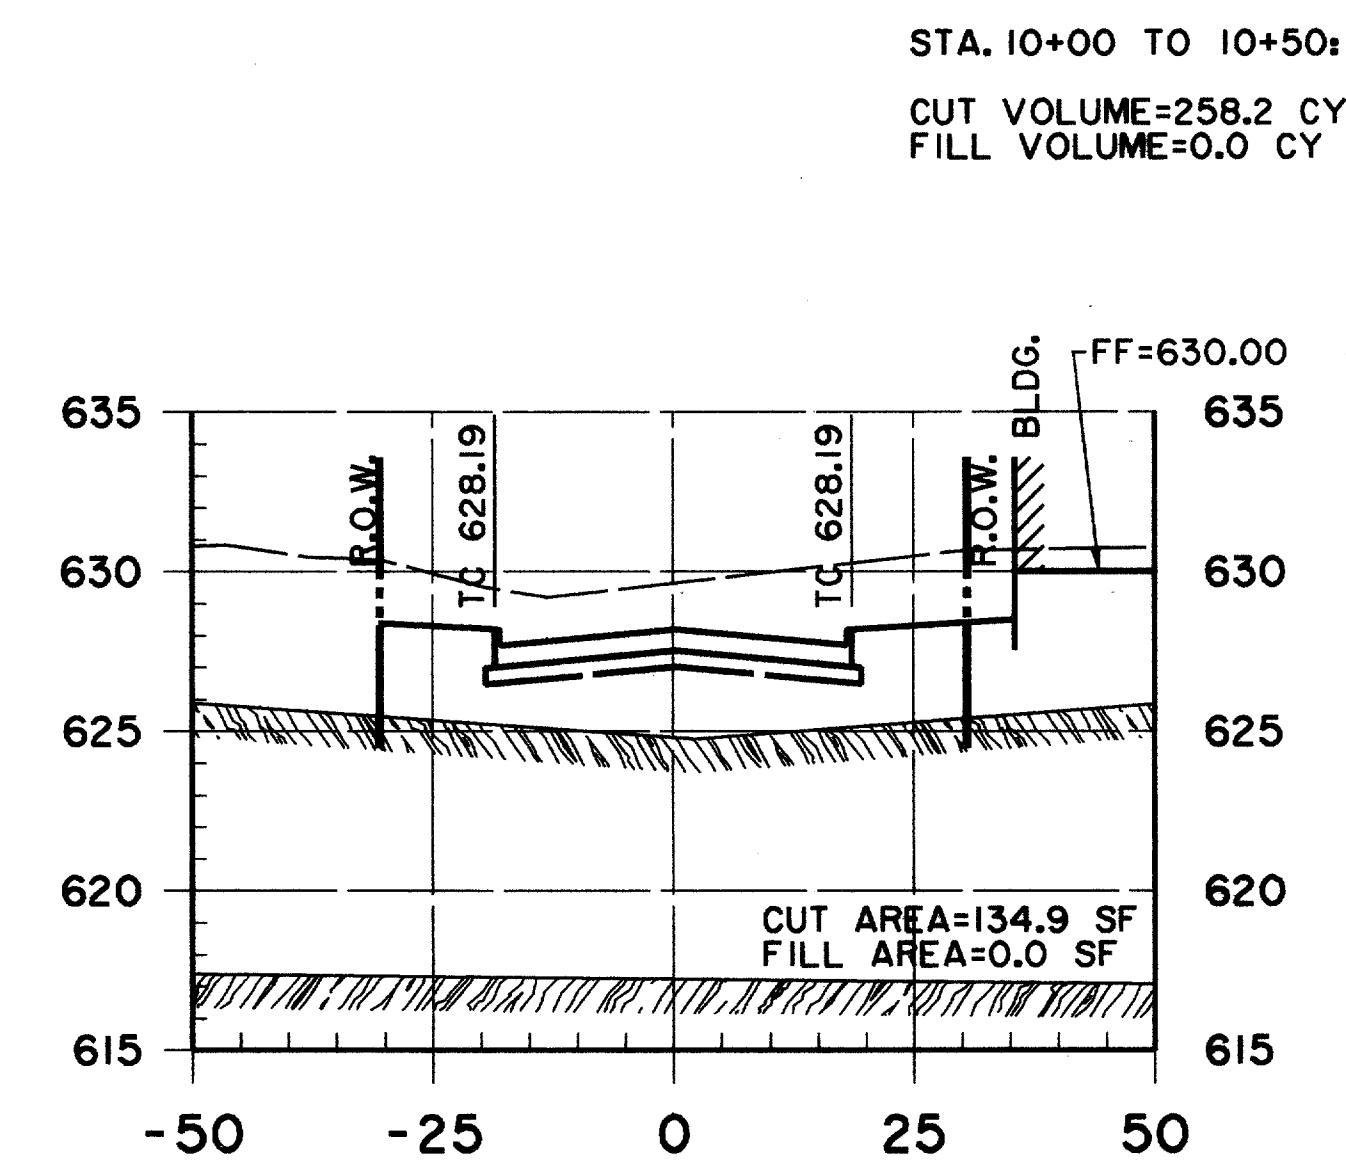

10+00

ISSUED FOR CONSTRUCTION
MARCH 28, 1996

THE SEAL APPEARING ON THIS DOCUMENT WAS AUTHORIZED BY KENNETH A. ROBERTS, P.E. 55446 ON MARCH 28, 1996.

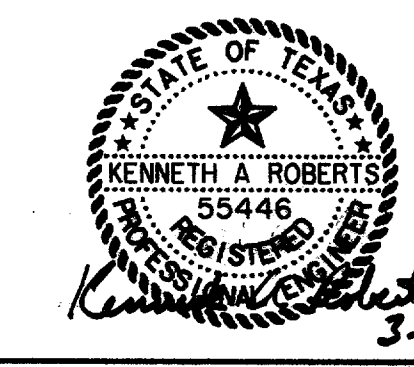

CROSS SECTIONS						
MORRIS AVENUE STA. 7+65.94 TO 10+50.50						
ADDISON CIRCLE						
PHASE I PUBLIC INFRASTRUCTURE						
TOWN OF ADDISON, TEXAS						
Hullt-Zollars, Inc./Engineering/Architecture Dallas, Fort Worth, Houston, El Paso, Phoenix, Tustin, Ontario, San Clemente						
DESIGN	DRAWN	APPR.	SCALE	DATE	PROJECT NO.	NO.
HZI	HZI	KAR	H: 1"=20' V: 1"=6'	JAN 96	1822-04	38
						137

RECORD DRAWING 5/1/98
ADDENDUM #4 2/16/96