


17+26.27  
 SOUTH R.O.W., MORRIS AVENUE  
 STA. 17+00 TO 17+26.27  
 CUT VOLUME=98.5 CY  
 FILL VOLUME=0.0 CY

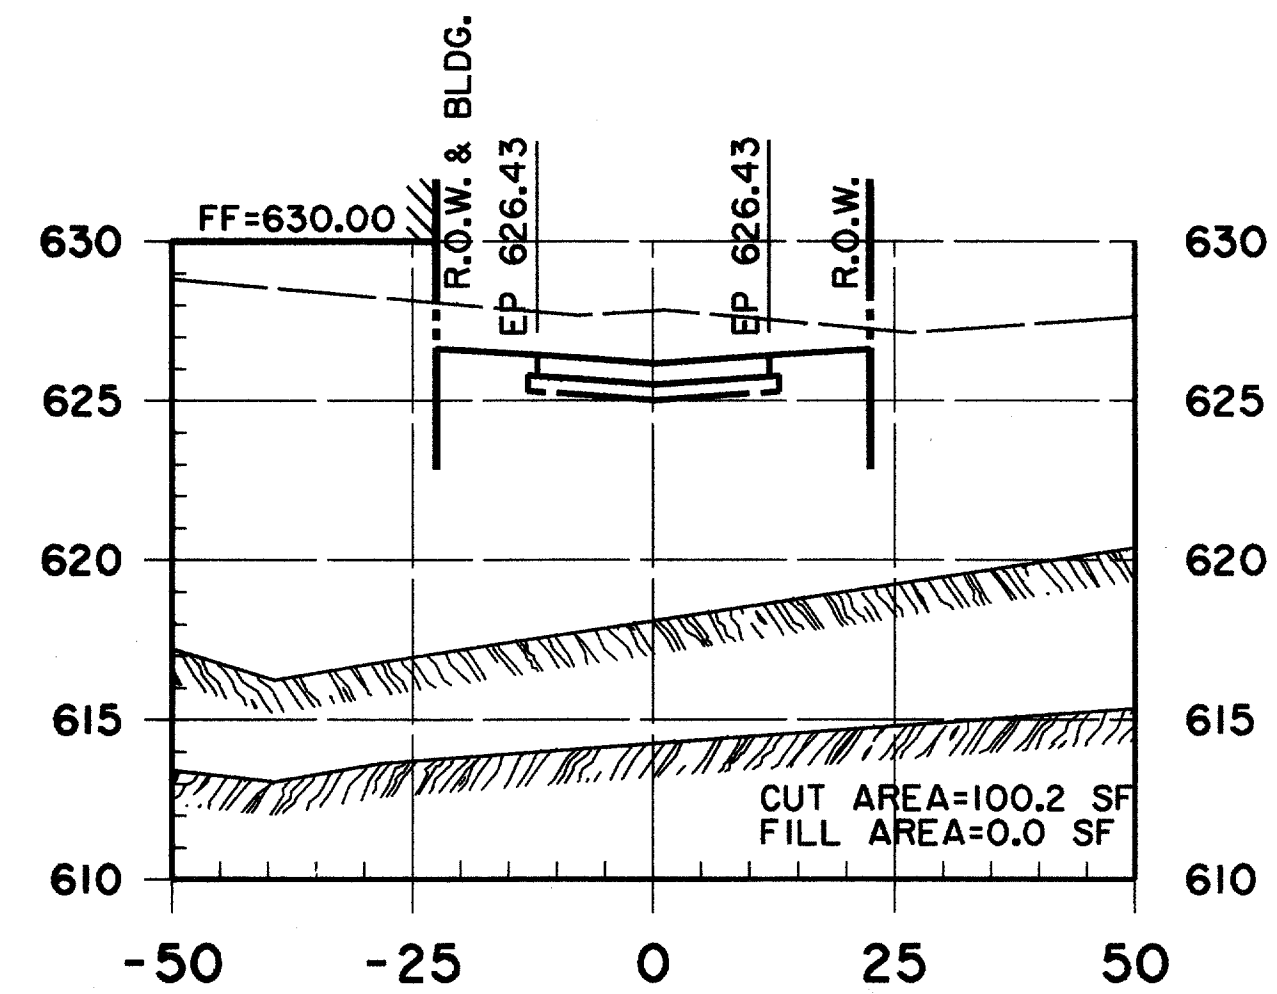

17+00

ISSUED FOR CONSTRUCTION  
 MARCH 28, 1996

THE SEAL APPEARING ON THIS  
 DOCUMENT WAS AUTHORIZED BY  
 KENNETH A. ROBERTS, P.E. 55446  
 ON MARCH 28, 1996.



CROSS SECTIONS					
WITT PLACE STA. 17+00 TO 17+26.27					
ADDISON CIRCLE					
PHASE I PUBLIC INFRASTRUCTURE					
TOWN OF ADDISON, TEXAS					
Huitt-Zollars, Inc./Engineering/Architecture Dallas, Fort Worth, Houston, El Paso, Phoenix, Tustin, Ontario, San Clemente					
DESIGN	DRAWN	APPR.	SCALE	DATE	PROJECT NO.
HZ1	HZ1	KAR	H: 1"=20' V: 1"=6'	JAN 96	1822-04
					NO.
					40
					137

RECORD DRAWING 5/1/98  
 ADDENDUM \*4 2/16/96